

BUILDING COVERAGE

LOT SIZE: 20,563 S.F.	EXISTING	NEW / ADDITION
a. 1st Floor Conditioned Area	1,929 S.F.	N/A
b. 2nd Floor Conditioned Area	1,167 S.F.	372 S.F.
c. 3rd Floor Conditioned Area	N/A	N/A
d. Basement	N/A	N/A
e. Garage / Carport		
Attached	N/A	N/A
Detached	1282 S.F.	N/A
f. Wood Decks (must be counted at 100%)	N/A	N/A
g. Breezeways	N/A	N/A
h. Covered Patios	260 S.F.	N/A
i. Covered Porches	91 S.F.	N/A
j. Balconies	N/A	N/A
k. Swimming Pool (surface area)	N/A	N/A
l. Other Building or Covered Areas (if applicable)		
Specify: Uncovered Roof Deck	436 S.F.	N/A
TOTAL BUILDING AREA (add a. through l.)	5,165 S.F.	372 S.F.

TOTAL BUILDING COVERAGE ON LOT (subtract, if applicable, b., c., d., k. and l. if uncovered)	4,370 S.F. 21.3% OF LOT
---	----------------------------

IMPERVIOUS COVERAGE

a. Total Building Coverage on Lot (see above)	4,370 S.F.
b. Driveway Area on Private Property	3,216 S.F.
c. Sidewalk / Walkways on Private Property	1,089 S.F.
d. Uncovered Patios	N/A
e. Uncovered Wood Decks (may be counted at 50%)	N/A
f. Air Conditioner Pad(s)	14 S.F.
g. Concrete Decks	N/A
h. Other Specify: Concrete steps Stone Walls	24 S.F. 626 S.F.

TOTAL IMPERVIOUS COVERAGE (add a. through h.)	9,339 S.F. 45.4% of lot
--	----------------------------

GROSS FLOOR AREA AND FLOOR AREA RATIO

	EXISTING	NEW / ADDITION
I. 1st Floor Gross Area		
a. 1st Floor Area (excluding covered or uncovered finished ground-floor porches)	1,929 S.F.	N/A
b. 1st Floor Area with Ceiling Height Over 15 Feet.	35 S.F.	N/A
c. TOTAL (add a and b above)	1,964 S.F.	N/A
II. 2nd Floor Gross Area		
d. 2nd Floor Area (including all areas covered by a roof)	1,167 S.F.	372 S.F.
e. 2nd Floor Area with Ceiling Height Over 15 Feet.	N/A	N/A
f. TOTAL (add d and e above)	1,167 S.F.	372 S.F.
III. 3rd Floor Gross Area		
g. 3rd Floor Area (including all areas covered by a roof)	N/A	N/A
h. 3rd Floor Area with Ceiling Height Over 15 Feet.	N/A	N/A
i. TOTAL (add g and h above)	N/A	N/A
IV. Basement Gross Area		
j. Floor area outside footprint of first floor	N/A	N/A
V. Garage		
k. Attached (subtract 200 sq. ft. if used to meet the minimum parking requirement)	N/A	N/A
l. Detached (subtract 450 square feet if more than 10 feet from principle structure)	510 S.F.	N/A
VI. Carport		
(Open on two or more sides without habitable space above it subtract 450 sq. ft.)	(322 - 450) 0 S.F.	N/A
VII. TOTAL	3,641 S.F.	372 S.F.


TOTAL GROSS FLOOR AREA	4,013 S.F.
GROSS AREA OF LOT	20,563 S.F.

FLOOR AREA RATIO (gross floor area /gross area of lot)	19.52% or 0.20 to 1.0
--	--------------------------

PROPERTY ADDRESS:
2321 Hartford Road
Austin, Texas 78703

LEGAL DESCRIPTION:
LOT 35, BLOCK 6,
LOT 35 *8 & N 15FT OF LOT 34 *8 & S 18FT LOT 36 SUNSET
HILL ENFIELD, TRAVIS COUNTY, TEXAS.

ZONING: SF-3-NP
FRONT YARD SETBACK 25 FEET
SIDE YARD SETBACK 5 FEET
REAR YARD SETBACK 10 FEET
MAXIMUM BUILDING COVERAGE 40%
MAXIMUM IMPERVIOUS COVERAGE 45%

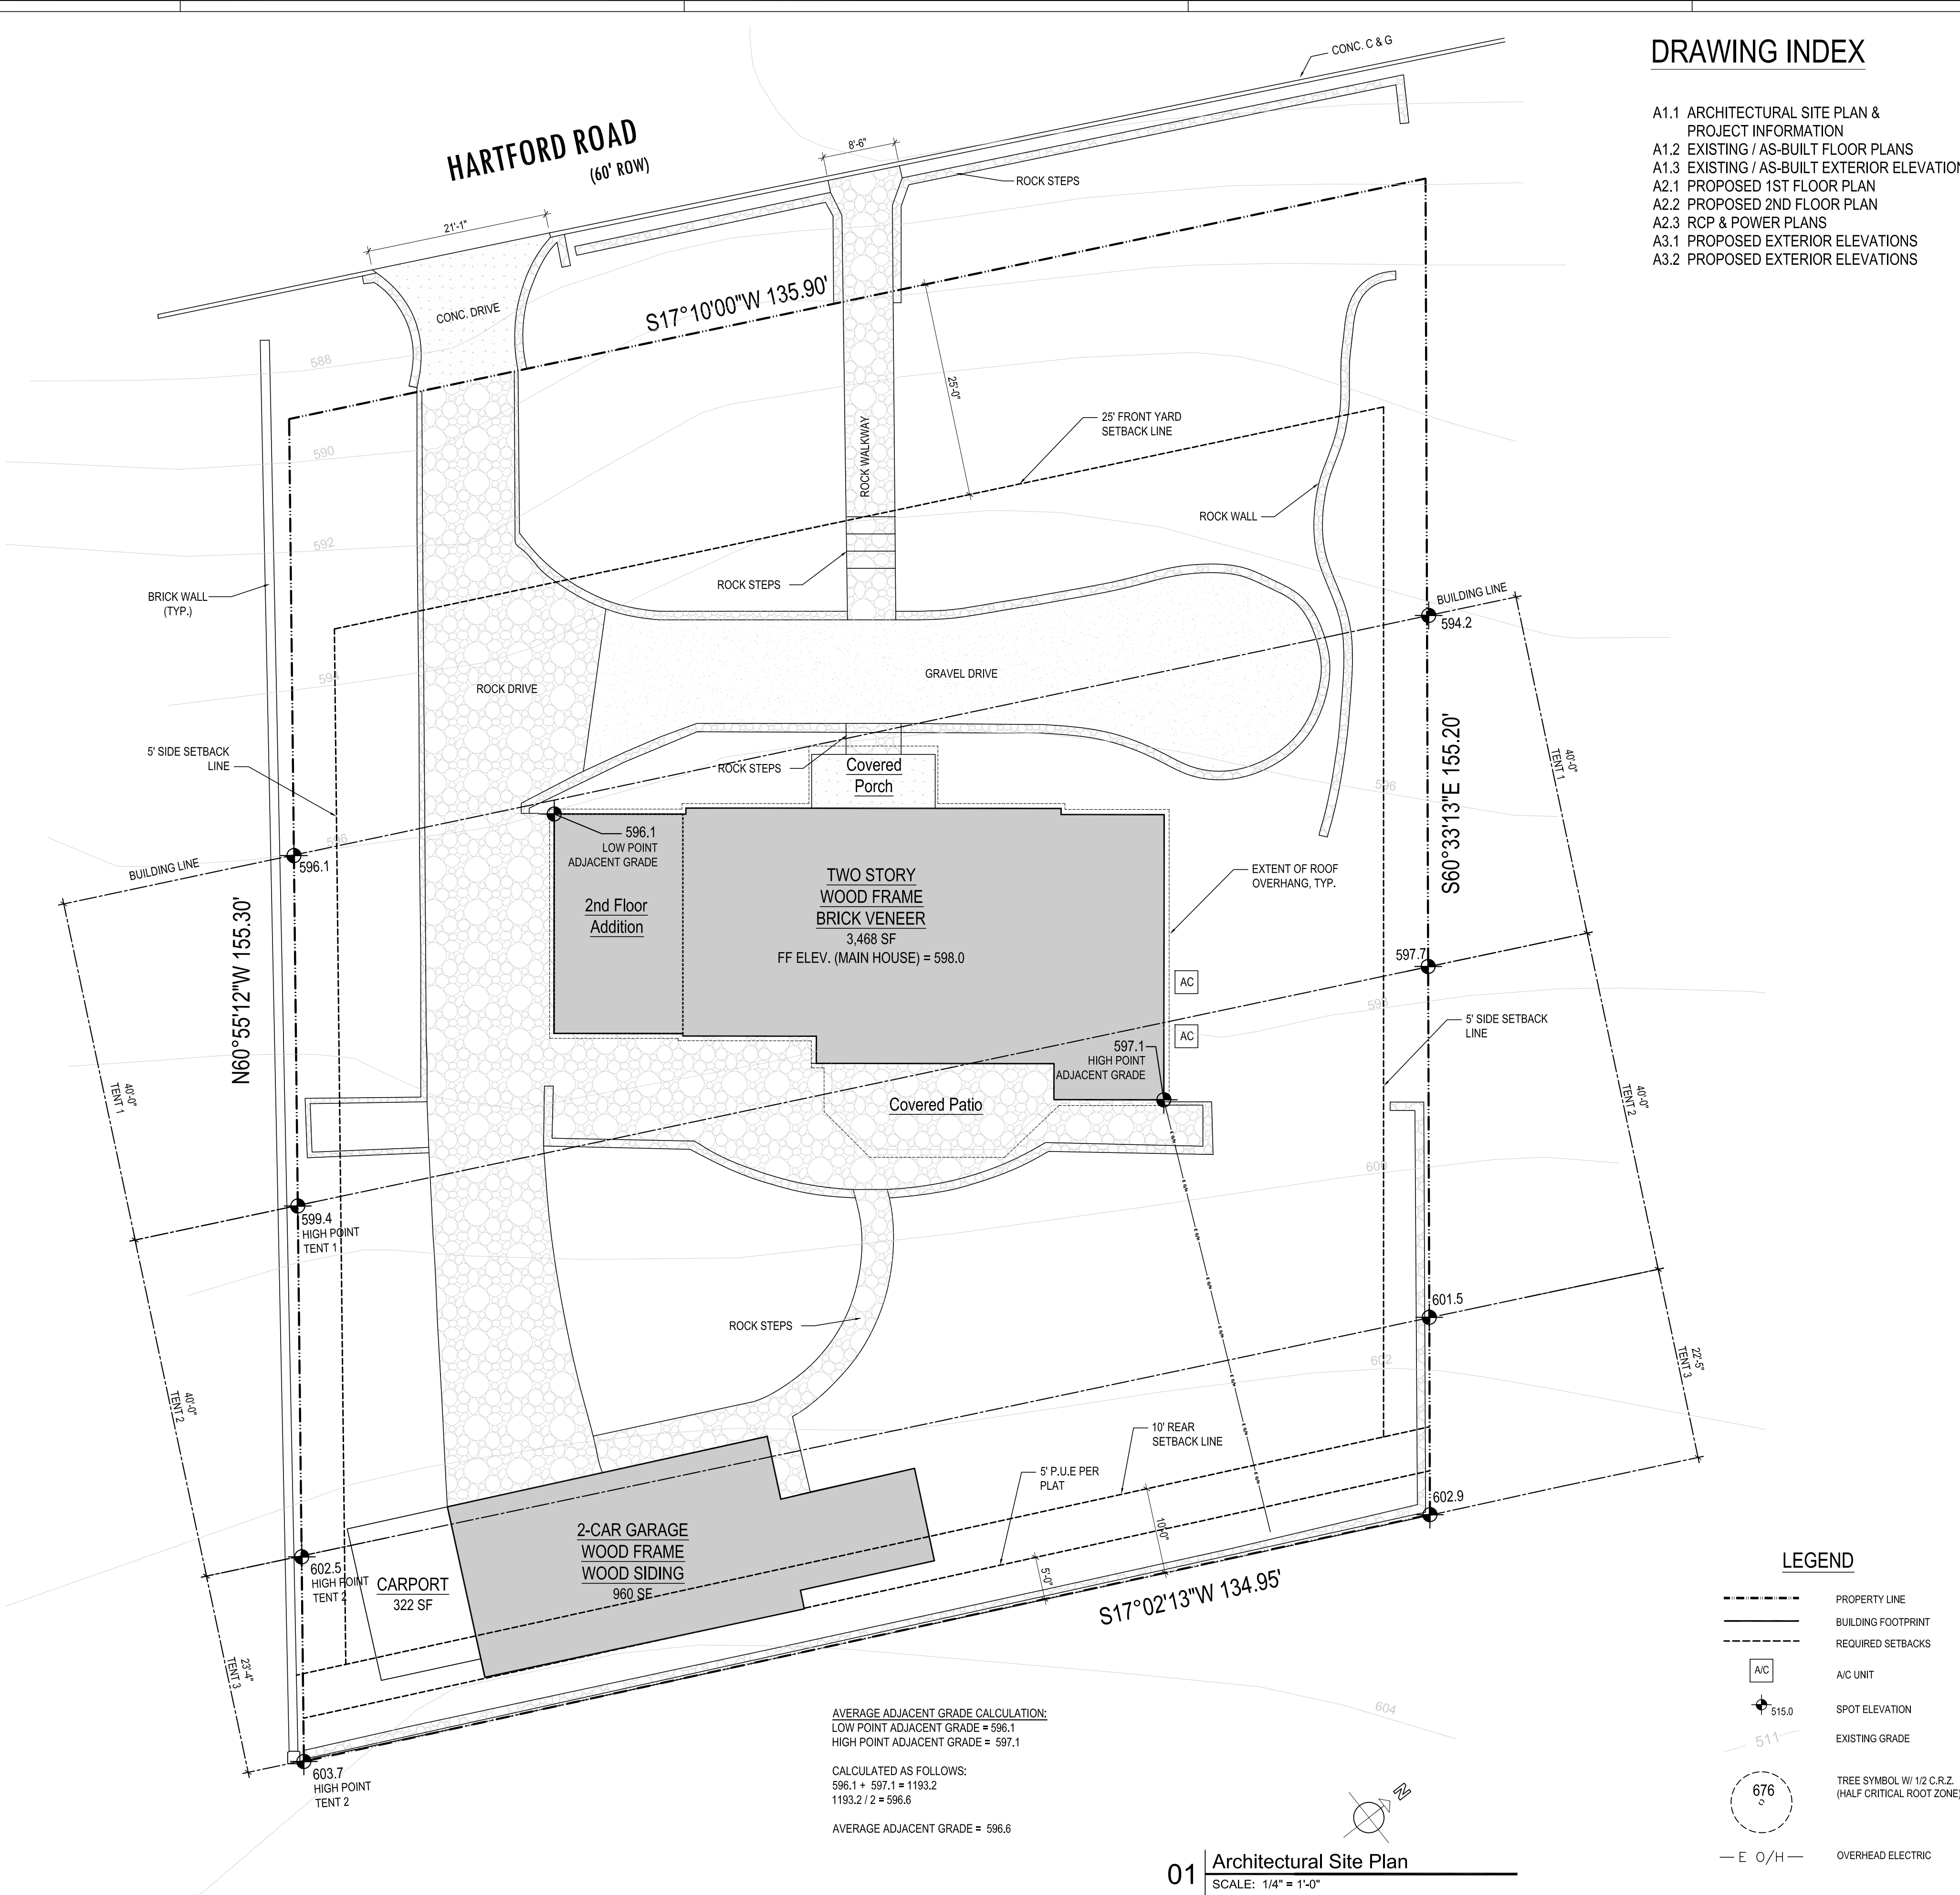

DRAWING INDEX

- A1.1 ARCHITECTURAL SITE PLAN & PROJECT INFORMATION
- A1.2 EXISTING / AS-BUILT FLOOR PLANS
- A1.3 EXISTING / AS-BUILT EXTERIOR ELEVATIONS
- A2.1 PROPOSED 1ST FLOOR PLAN
- A2.2 PROPOSED 2ND FLOOR PLAN
- A2.3 RCP & POWER PLANS
- A3.1 PROPOSED EXTERIOR ELEVATIONS
- A3.2 PROPOSED EXTERIOR ELEVATIONS

hatch + ulland owen
architects

1010 East 11th Street
Austin, Texas 78702
T: 512.474.8548
F: 512.474.8643

www.huoarchitects.com

Contractor:

David Bratton
Watermark Homes by
David Bratton
4208 Avenue D
Austin Texas 78751
Cell - 512-233-9301
Fax - 512-291-7650
watermarkhomesaustin.com


Structural Engineer:

DCI Engineers
600 Congress Avenue, Suite 1210
Austin, Texas 78701
512.472.9797

WEBSTER RESIDENCE
REMODEL

2321 HARTFORD ROAD, AUSTIN, TEXAS 78703

NOTE: This document, the ideas and design incorporated herein are and shall remain the property of huo architects. These documents are not to be used or altered, in whole or in part, for other than the original intended use, nor are they to be assigned to any third party without written permission from huo architects.

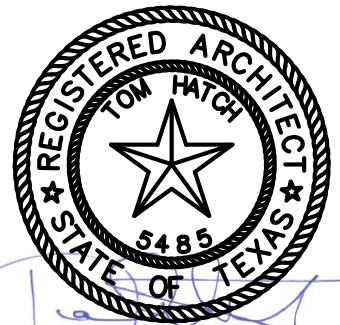


08.07.2014



△ ISSUE DATES:	08/07/14	PERMIT SET
....		
....		
Architectural Site Plan &
Project Information



A1.1

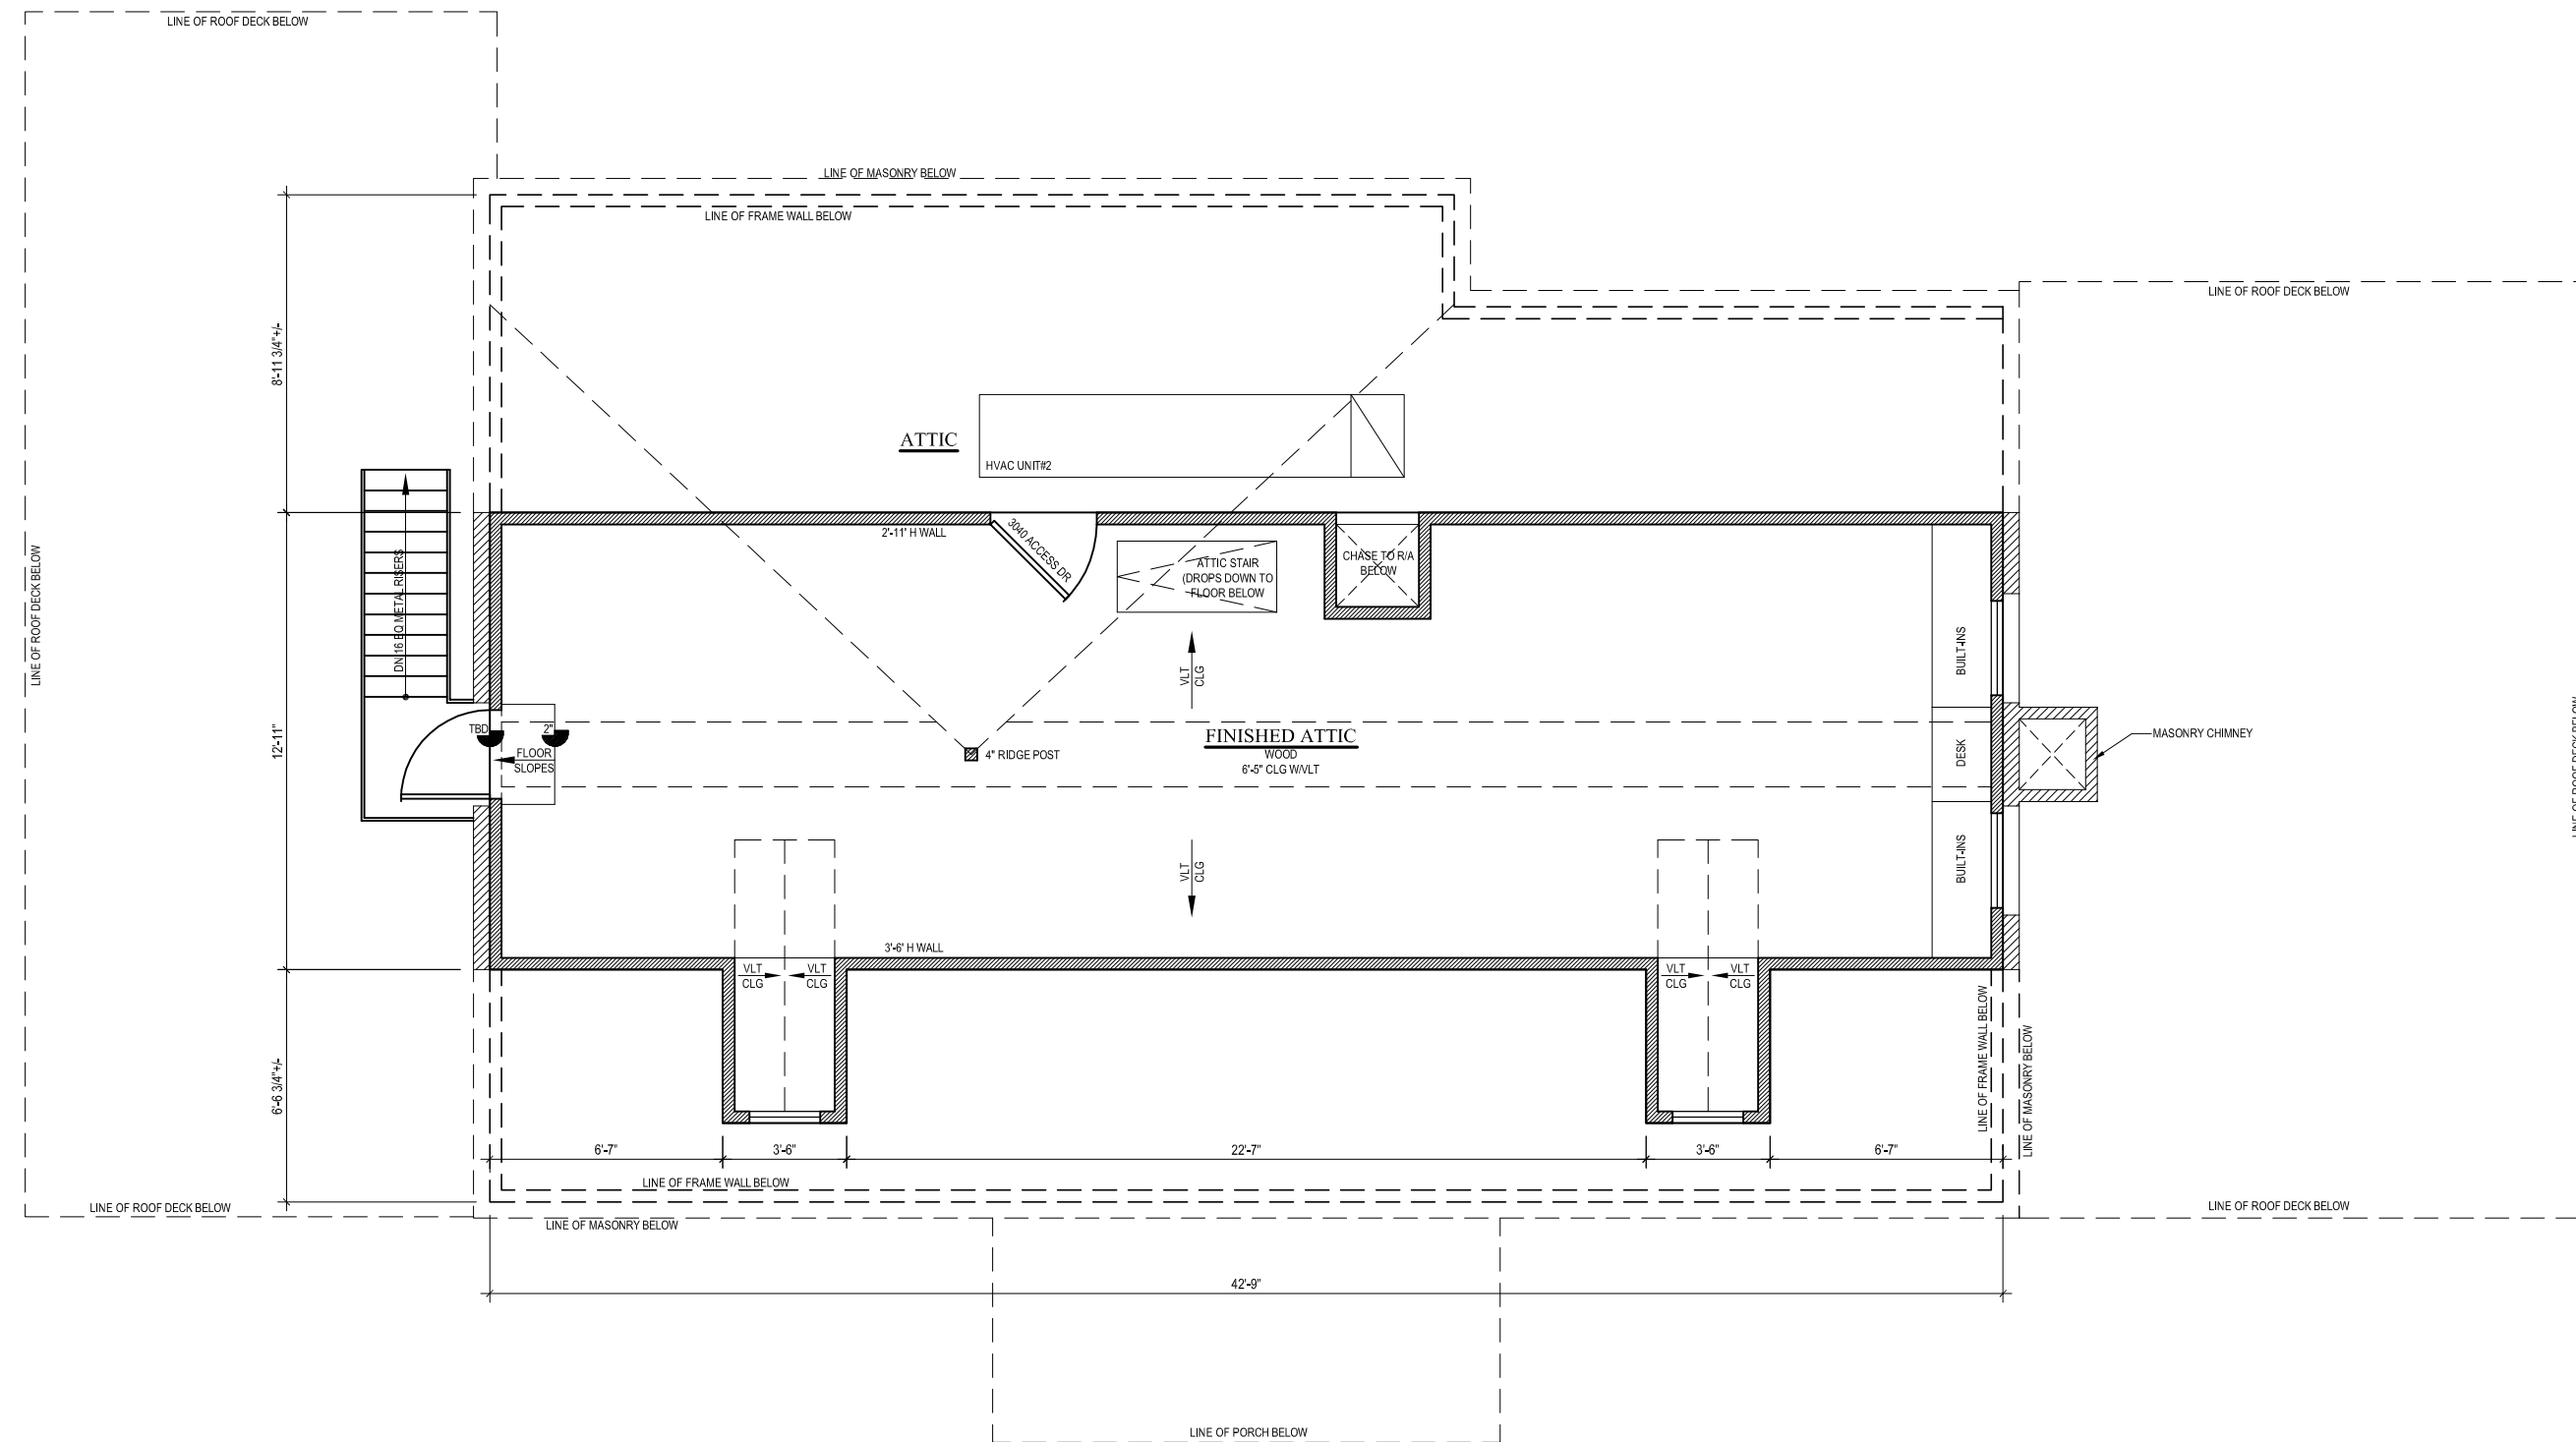



04 Existing Attic Plan
SCALE: 3/16" = 1'-0"

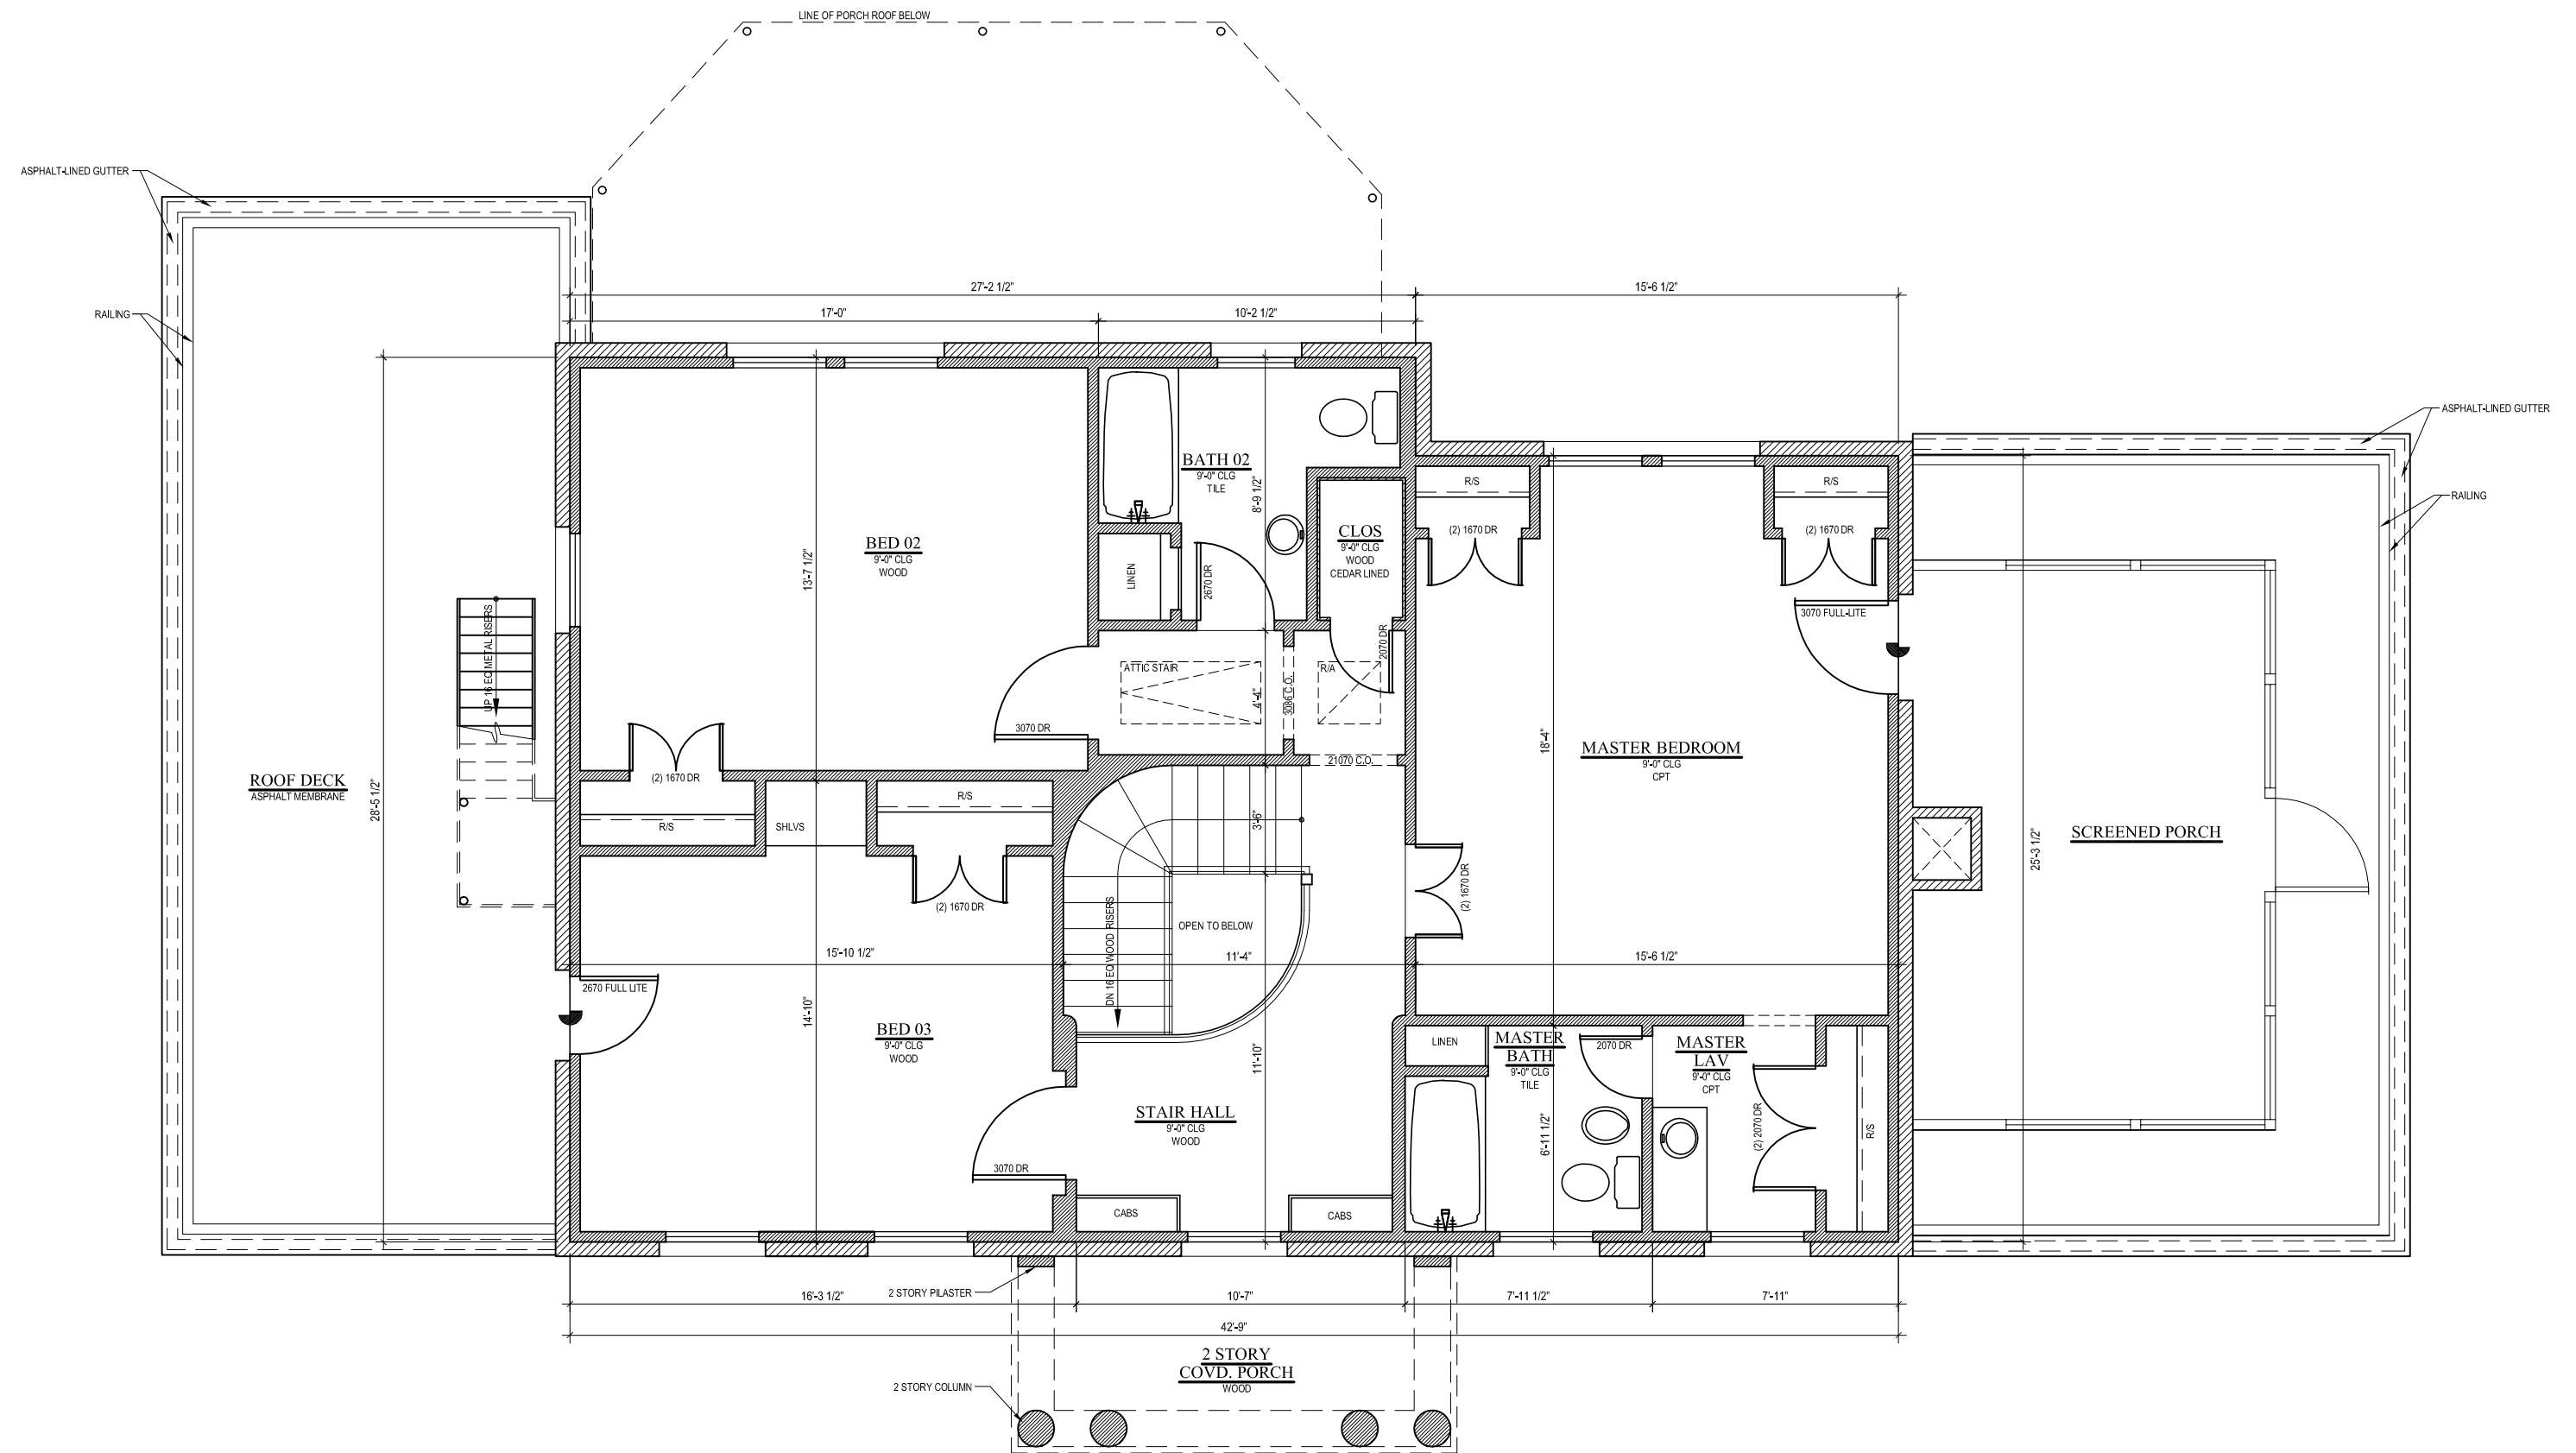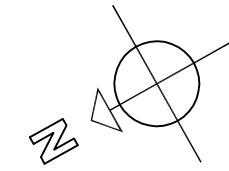


03 Existing 2nd Floor Plan
SCALE: 3/16" = 1'-0"

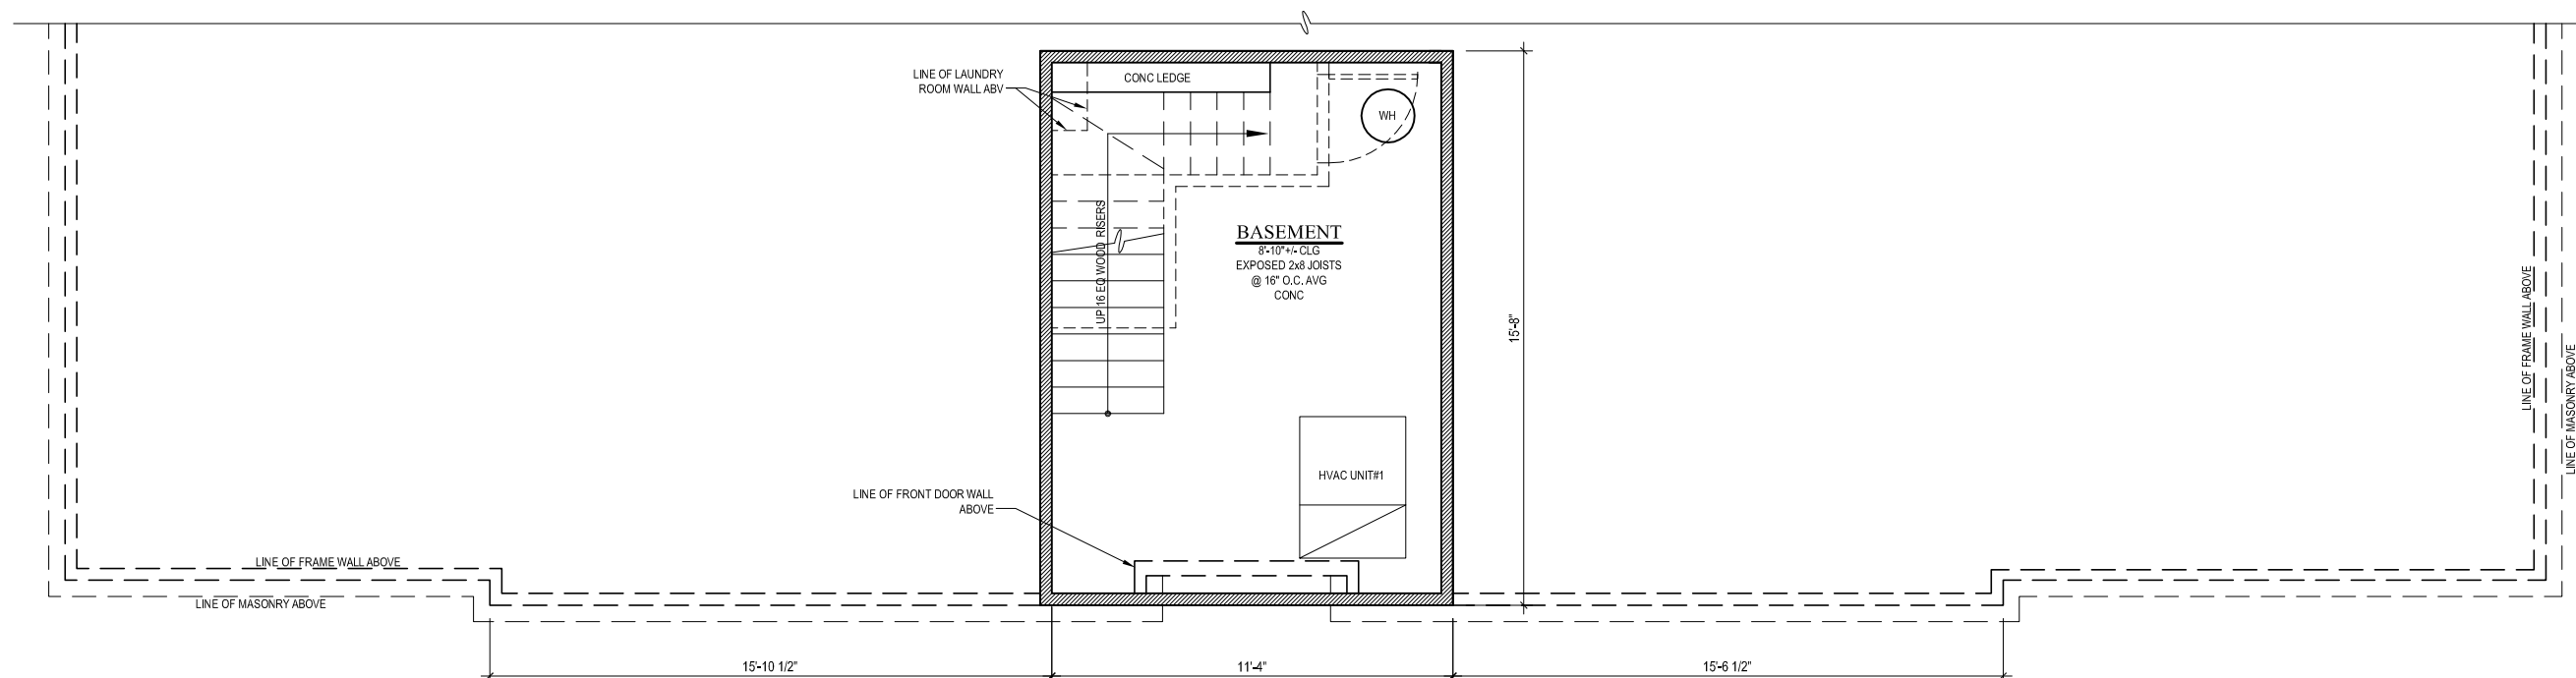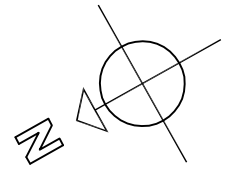

02 Existing Basement Plan
SCALE: 3/16" = 1'-0"

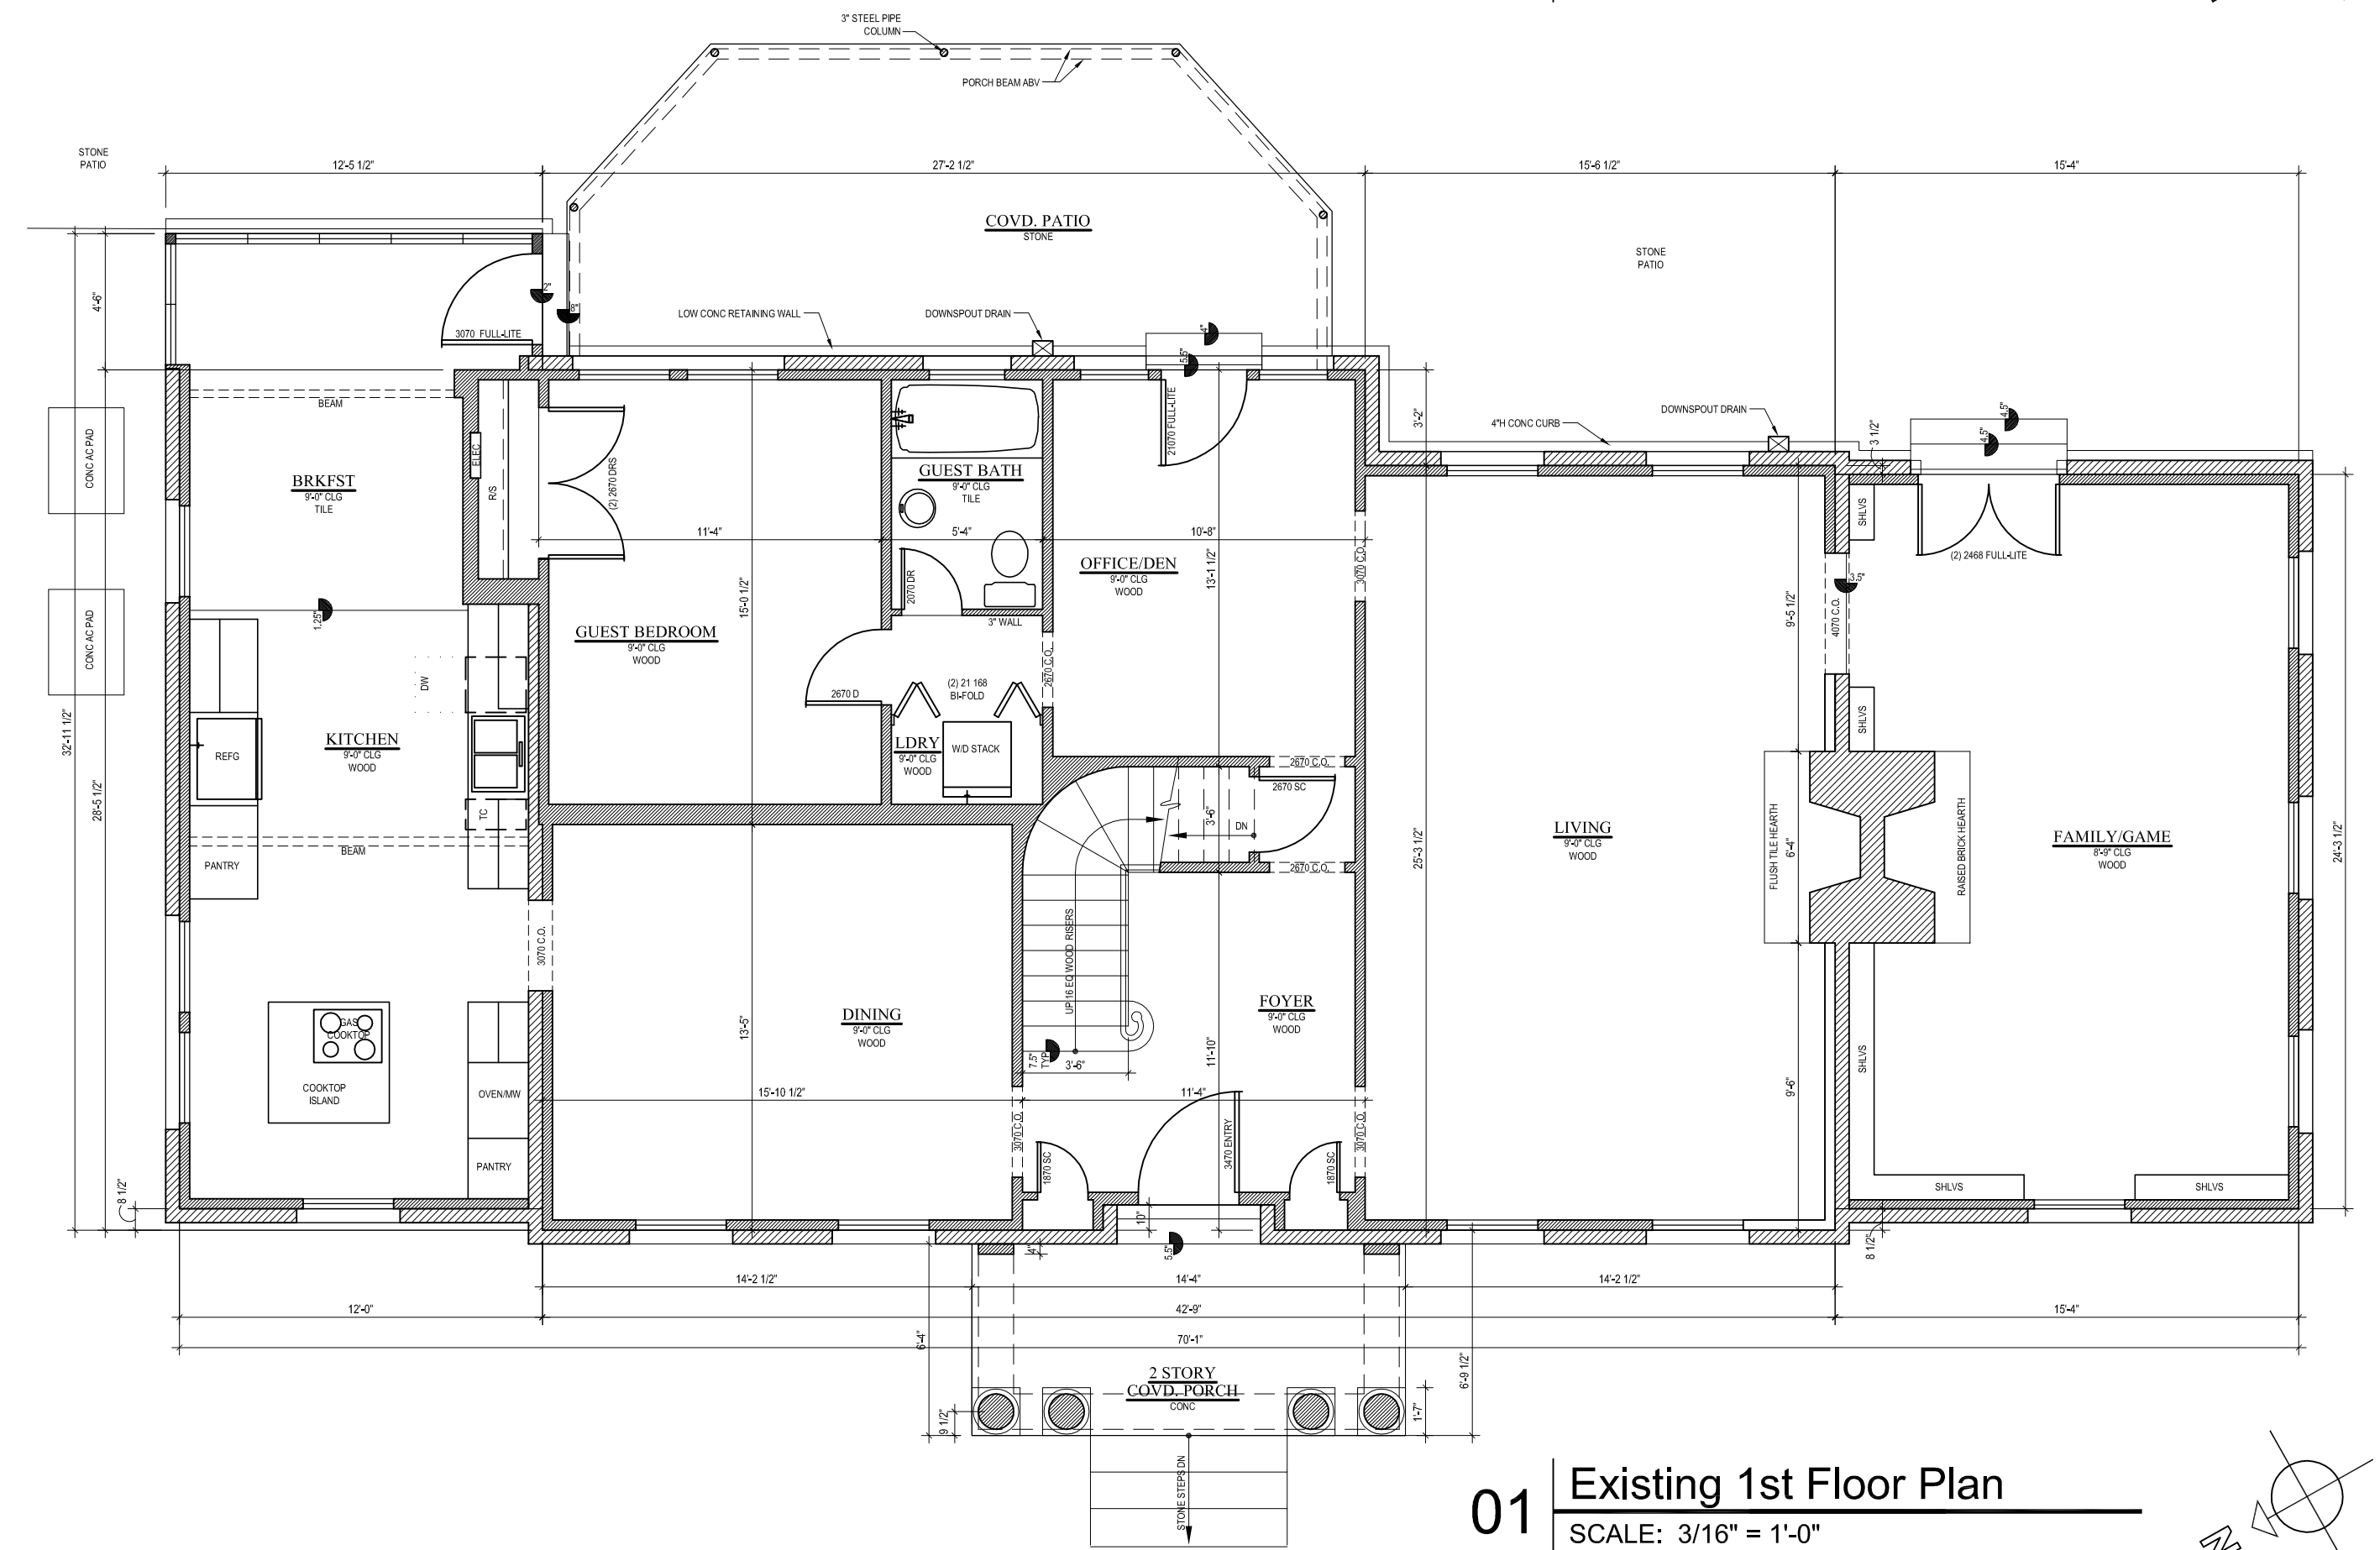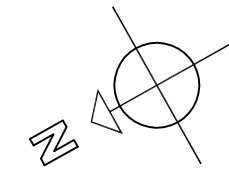

01 Existing 1st Floor Plan
SCALE: 3/16" = 1'-0"

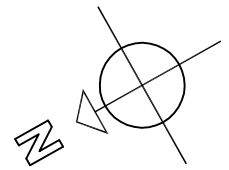

hatch + ulland owen
architects

1010 East 11th Street
Austin, Texas 78702
T: 512.474.8548
F: 512.474.8643

www.huoaarchitects.com

Contractor:
David Bratton
Watermark Homes by
David Bratton
4208 Avenue D
Austin Texas 78751
Cell - 512-233-9301
Fax - 512-291-7650
watermarkhomesaustin.com

Structural Engineer:
DCI Engineers
600 Congress Avenue, Suite 1210
Austin, Texas 78701
512.472.9797

WEBSTER RESIDENCE
REMODEL

2321 HARTFORD ROAD, AUSTIN, TEXAS 78703

NOTE: This document, the ideas and design incorporated herein are and shall remain the property of huo+o architects. These documents are not to be used or altered, in whole or in part, for other than the original intended use, nor are they to be assigned to any third party without written permission from huo+o architects.



08.07.2014

ISSUE DATES:	
08/07/14	PERMIT SET
....	
....	
Existing Floor Plans

A1.2



hatch + ulland owen
architects

1010 East 11th Street
Austin, Texas 78702
T: 512.474.8548
F: 512.474.8643

www.huoaarchitects.com

Contractor:

David Bratton
Watermark Homes by
David Bratton
4208 Avenue D
Austin Texas 78751
Cell - 512-233-9301
Fax - 512-291-7650
watermarkhomesaustin.com

Structural Engineer:

DCI Engineers
600 Congress Avenue, Suite 1210
Austin, Texas 78701
512.472.9797

WEBSTER RESIDENCE
REMODEL

2321 HARTFORD ROAD, AUSTIN, TEXAS 78703

NOTE: This document, the ideas and design incorporated herein are and shall remain the property of these architects. These documents are not to be used or altered, in whole or in part, for other than the original intended use, nor are they to be assigned to any third party without written permission from these architects.



ISSUE DATES:

08/07/14	PERMIT SET
....	
....	
Existing / As-Built
Exterior Elevations

A1.3



04 Existing Front Elevation
SCALE: 3/16" = 1'-0"



03 Existing Side (South) Elevation
SCALE: 3/16" = 1'-0"



02 Existing Side (South) Elevation
SCALE: 3/16" = 1'-0"



01 Existing Front Elevation
SCALE: 3/16" = 1'-0"



010 East 11th Street
Austin, Texas 78702
: 512.474.8548
: 512.474.8643

www.huoarchitects.com

Contractor:

David Bratton
Watermark Homes by
David Bratton
208 Avenue D
Austin Texas 78751
Cell - 512-233-9301
Fax - 512-291-7650
watermarkhomesaustin.com

Structural Engineer:

OCI Engineers
100 Congress Avenue, Suite 1210
Austin, Texas 78701
512.472.9797

WEBSIER RESIDENCE
REMODEL


23231 HARTFORD ROAD, AUSTIN, TEXAS 78703

NOTE: This document, the ideas and designs incorporated herein are and shall remain the property of h+uo architects. These documents are not to be used or altered, in whole or in part, for other than the original intended use, nor are they to be assigned to any third party without written permission from h+uo architects.


[illegible]

Proposed 1st Floor Plan


A2.1

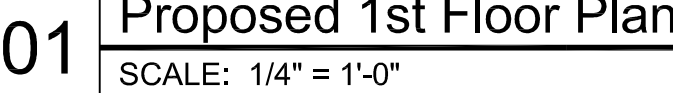

SCALE: 1/4" = 1'-0"

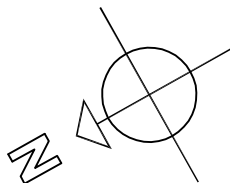

Proposed 1st Floor Plan

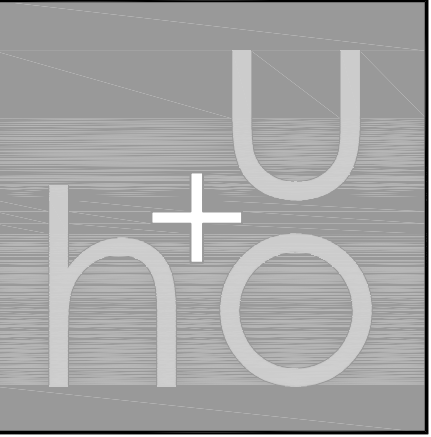

hatch + ulland owen
architects

1010 East 11th Street
Austin, Texas 78702
T: 512.474.8548
F: 512.474.8643
www.huoaarchitects.com

Contractor:
David Bratton
Watermark Homes by
David Bratton
4208 Avenue D
Austin Texas 78751
Cell - 512-233-9301
Fax - 512-291-7650
watermarkhomesaustin.com

Structural Engineer:
DCI Engineers
600 Congress Avenue, Suite 1210
Austin, Texas 78701
512.472.9797

WEBSTER RESIDENCE
REMODEL

2321 HARTFORD ROAD, AUSTIN, TEXAS 78703


NOTE: This document, the ideas and design incorporated herein are and shall remain the property of h+u architects. These documents are not to be used or altered, in whole or in part, for other than the original intended use, nor are they to be assigned to any third party without written permission from h+u architects.



ISSUE DATES:	
08/07/14	PERMIT SET
....	
....	
Proposed 2nd Floor Plan

A2.2

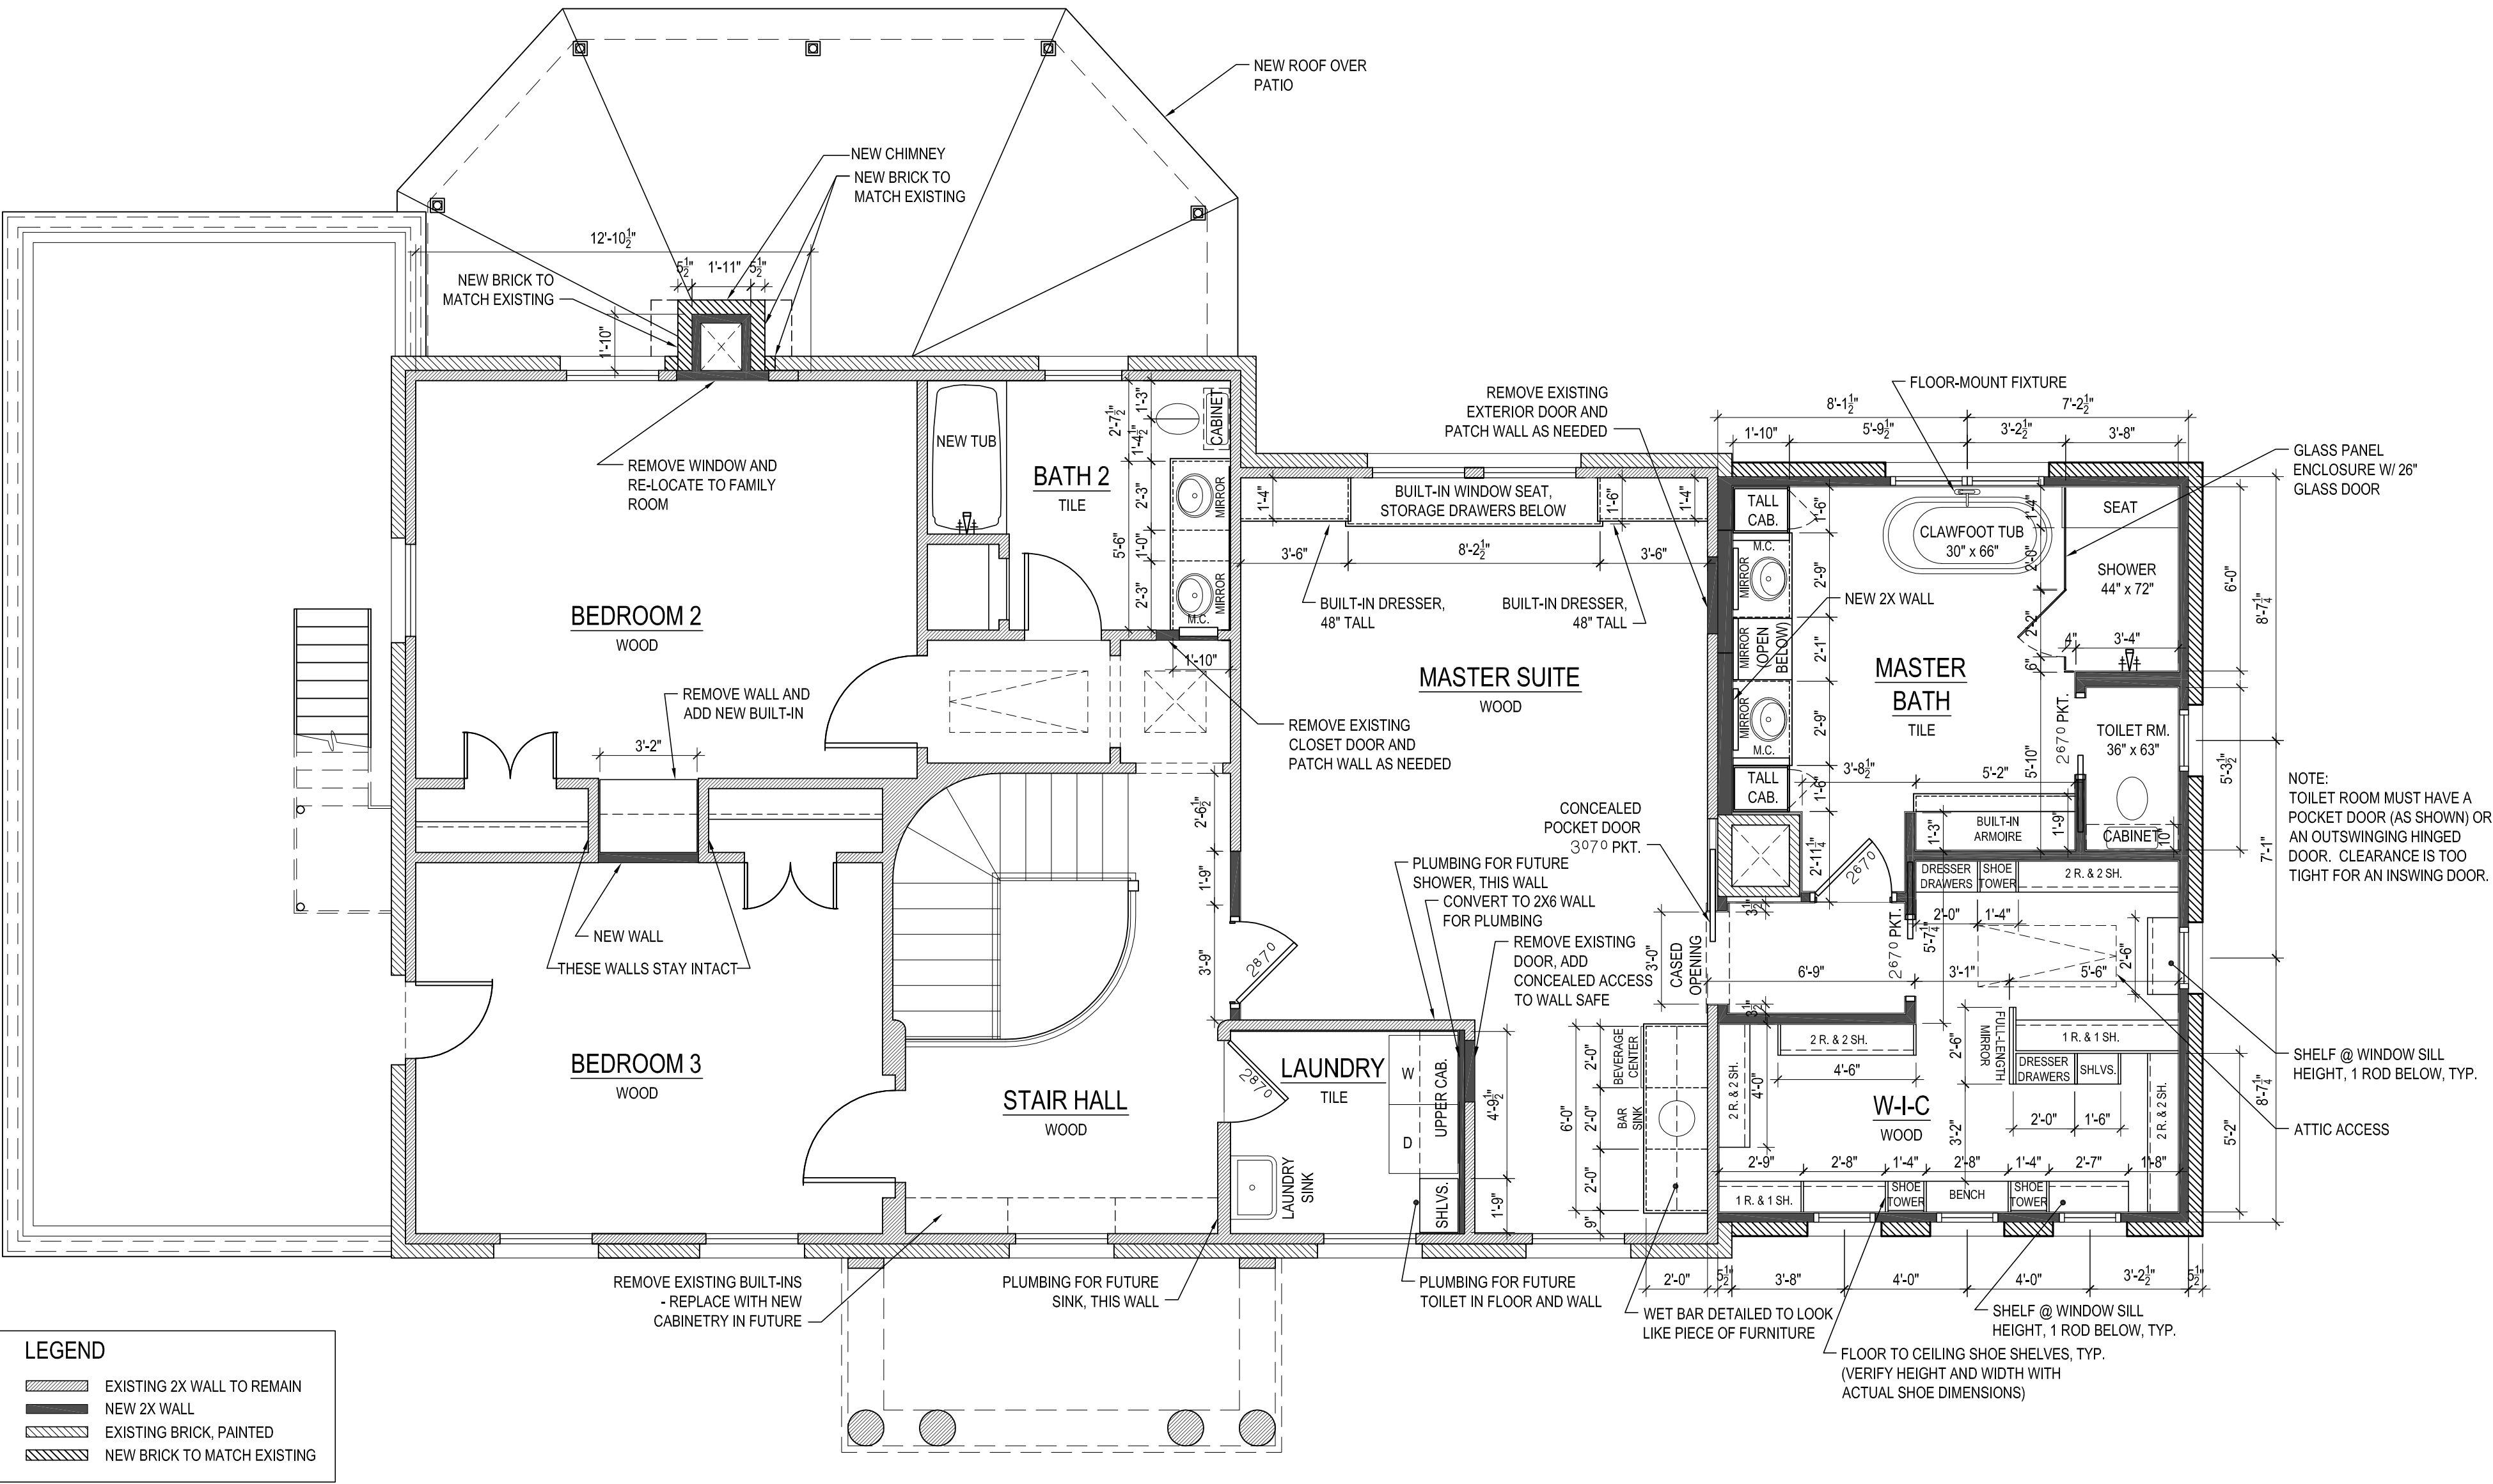

01 Proposed 2nd Floor Plan
SCALE: 1/4" = 1'-0"



hatch + ulland owen
architects

1010 East 11th Street
Austin, Texas 78702
T: 512.474.8548
F: 512.474.8643

www.huoaarchitects.com


Contractor:
David Bratton
Watermark Homes by
David Bratton
4208 Avenue D
Austin Texas 78751
Cell - 512-233-9301
Fax - 512-291-7650
watermarkhomesaustin.com

Structural Engineer:
DCI Engineers
600 Congress Avenue, Suite 1210
Austin, Texas 78701
512.472.9797

WEBSTER RESIDENCE
REMODEL

2321 HARTFORD ROAD, AUSTIN, TEXAS 78703


NOTE: This document, the ideas and design incorporated herein are and shall remain the property of h+u architects. These documents are not to be used or altered, in whole or in part, for other than the original intended use, nor are they to be assigned to any third party without written permission from h+u architects.

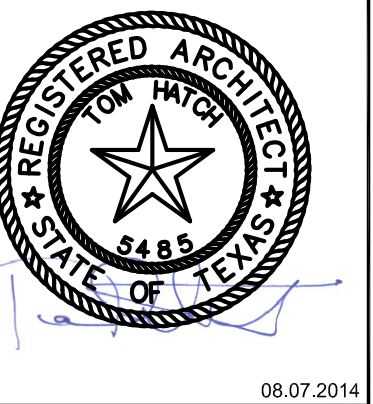

ISSUE DATES:	
08/07/14	PERMIT SET
....	
....	
RCP / Power Plans



A2.3

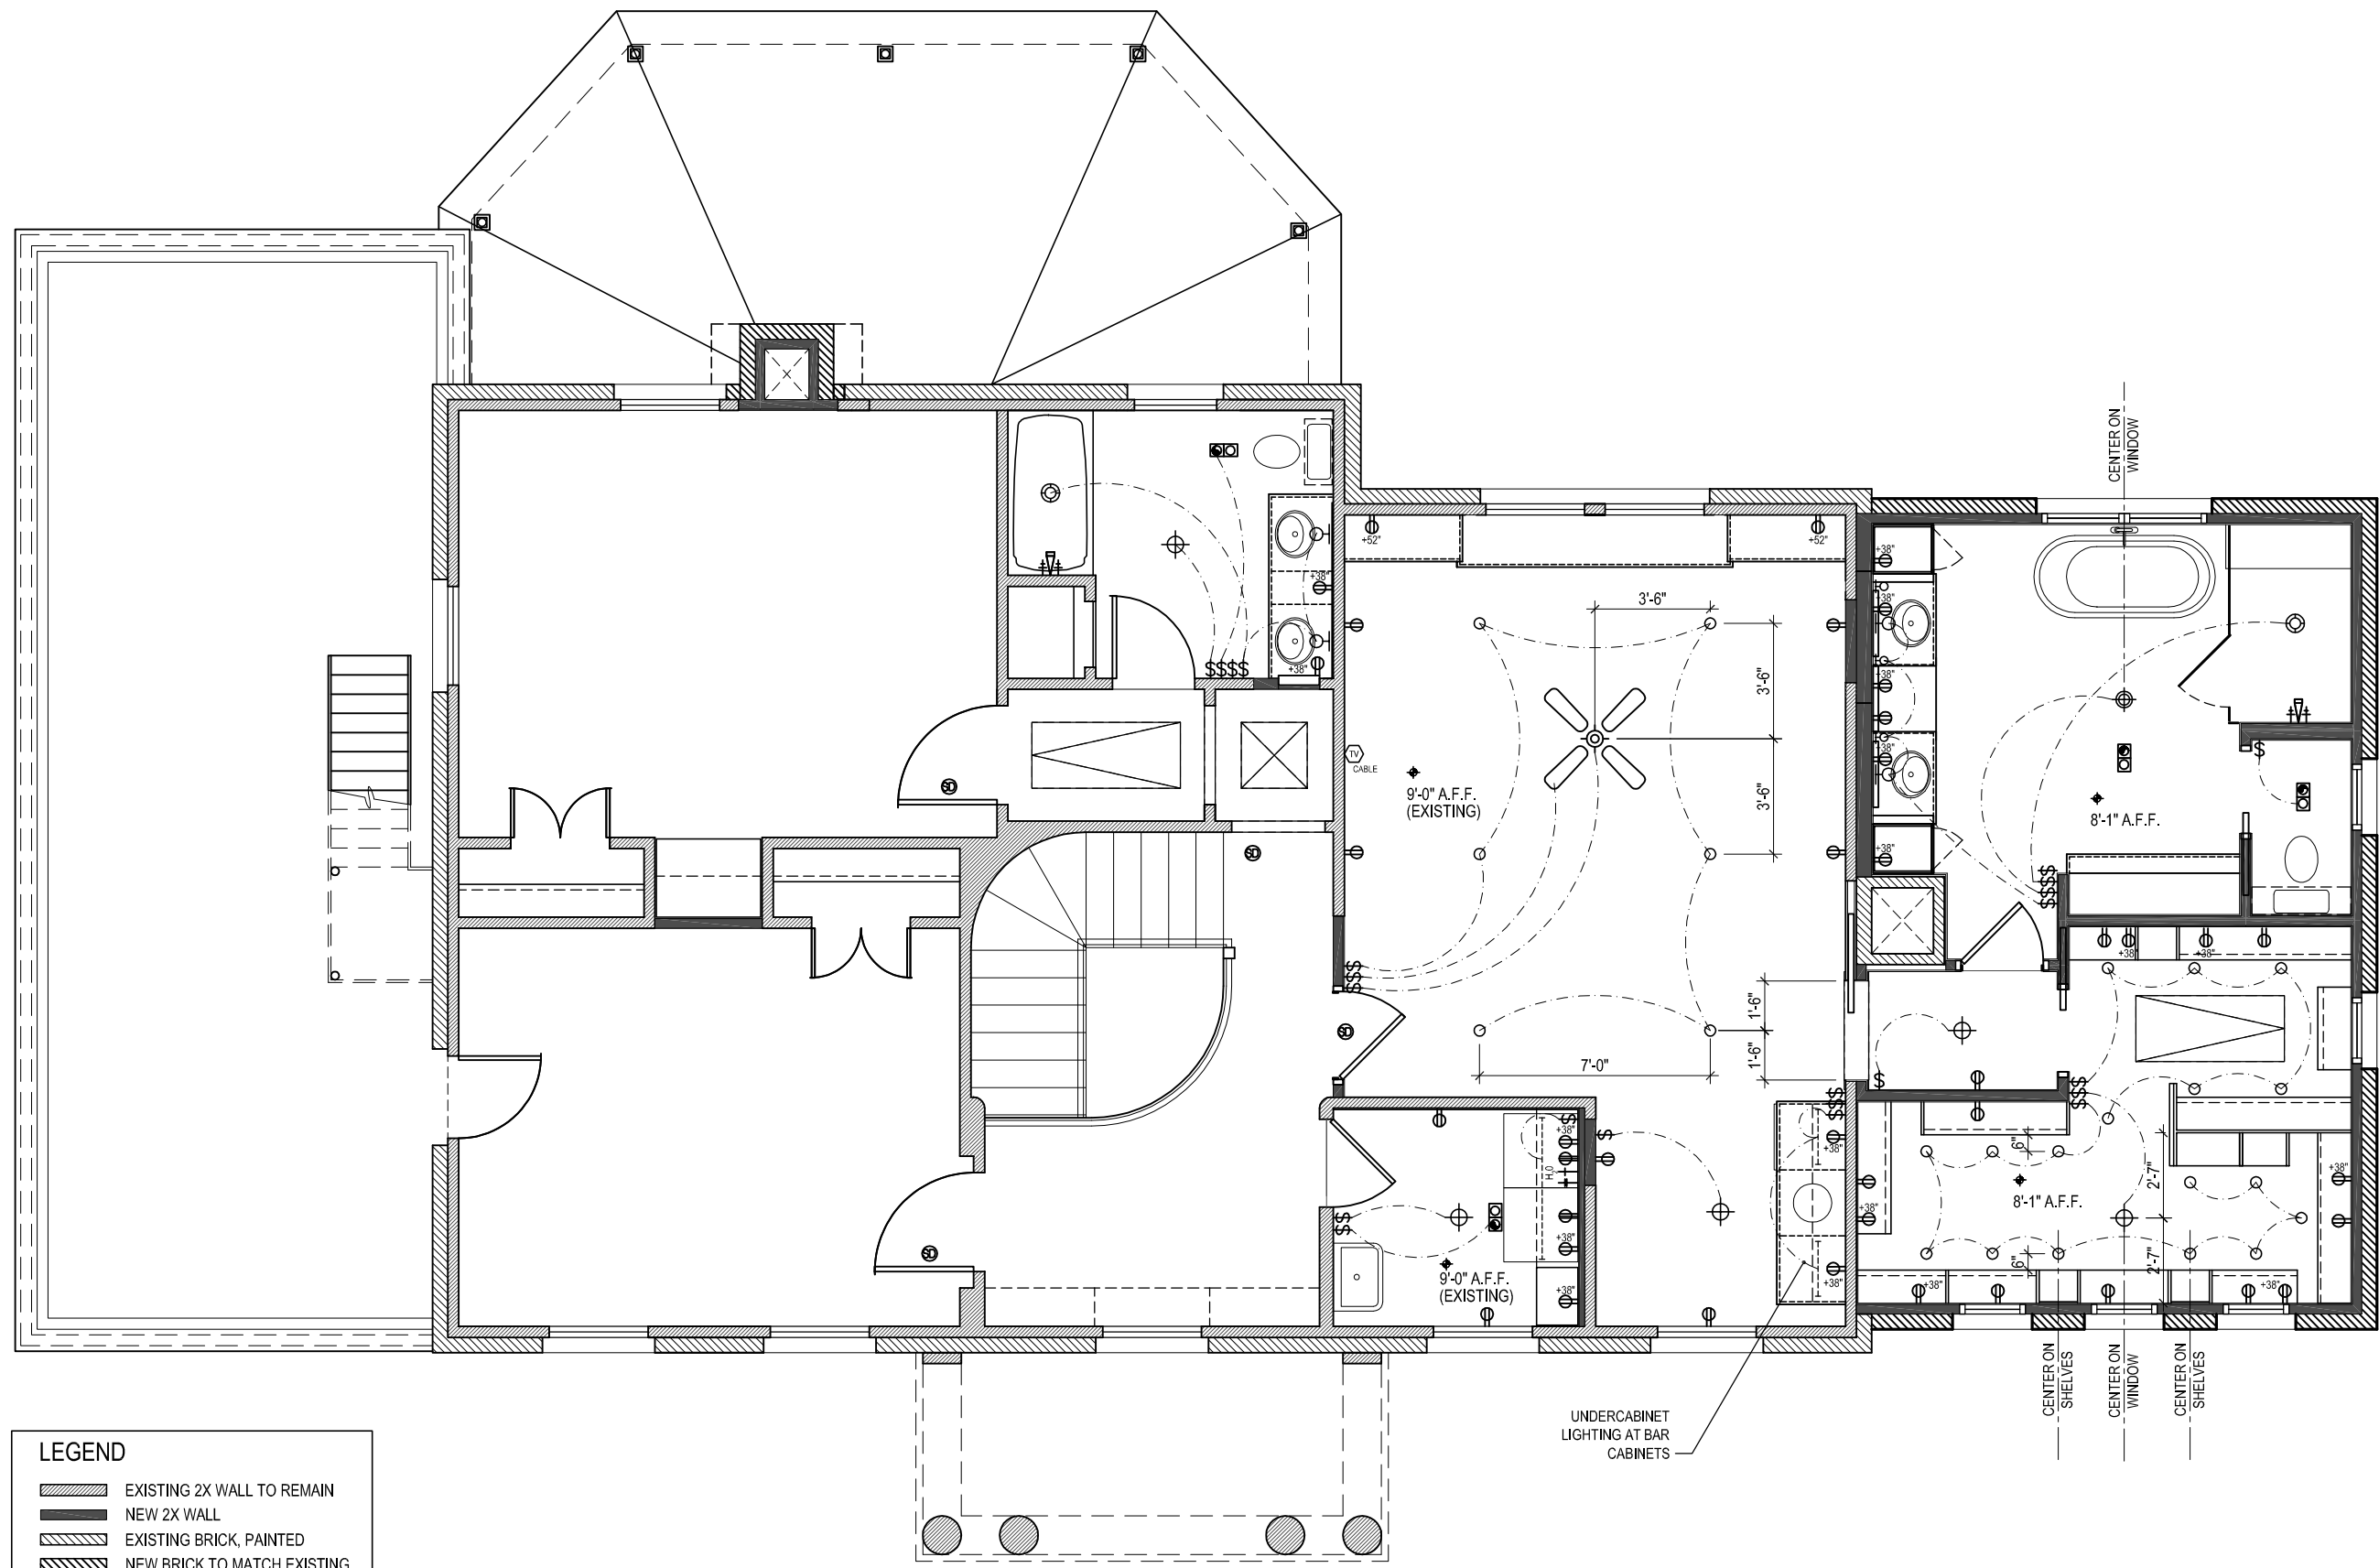

LEGEND
EXISTING 2X WALL TO REMAIN
NEW 2X WALL
EXISTING BRICK, PAINTED
NEW BRICK TO MATCH EXISTING

02 | 2nd Floor RCP / Power Plan


SCALE: 3/16" = 1'-0"

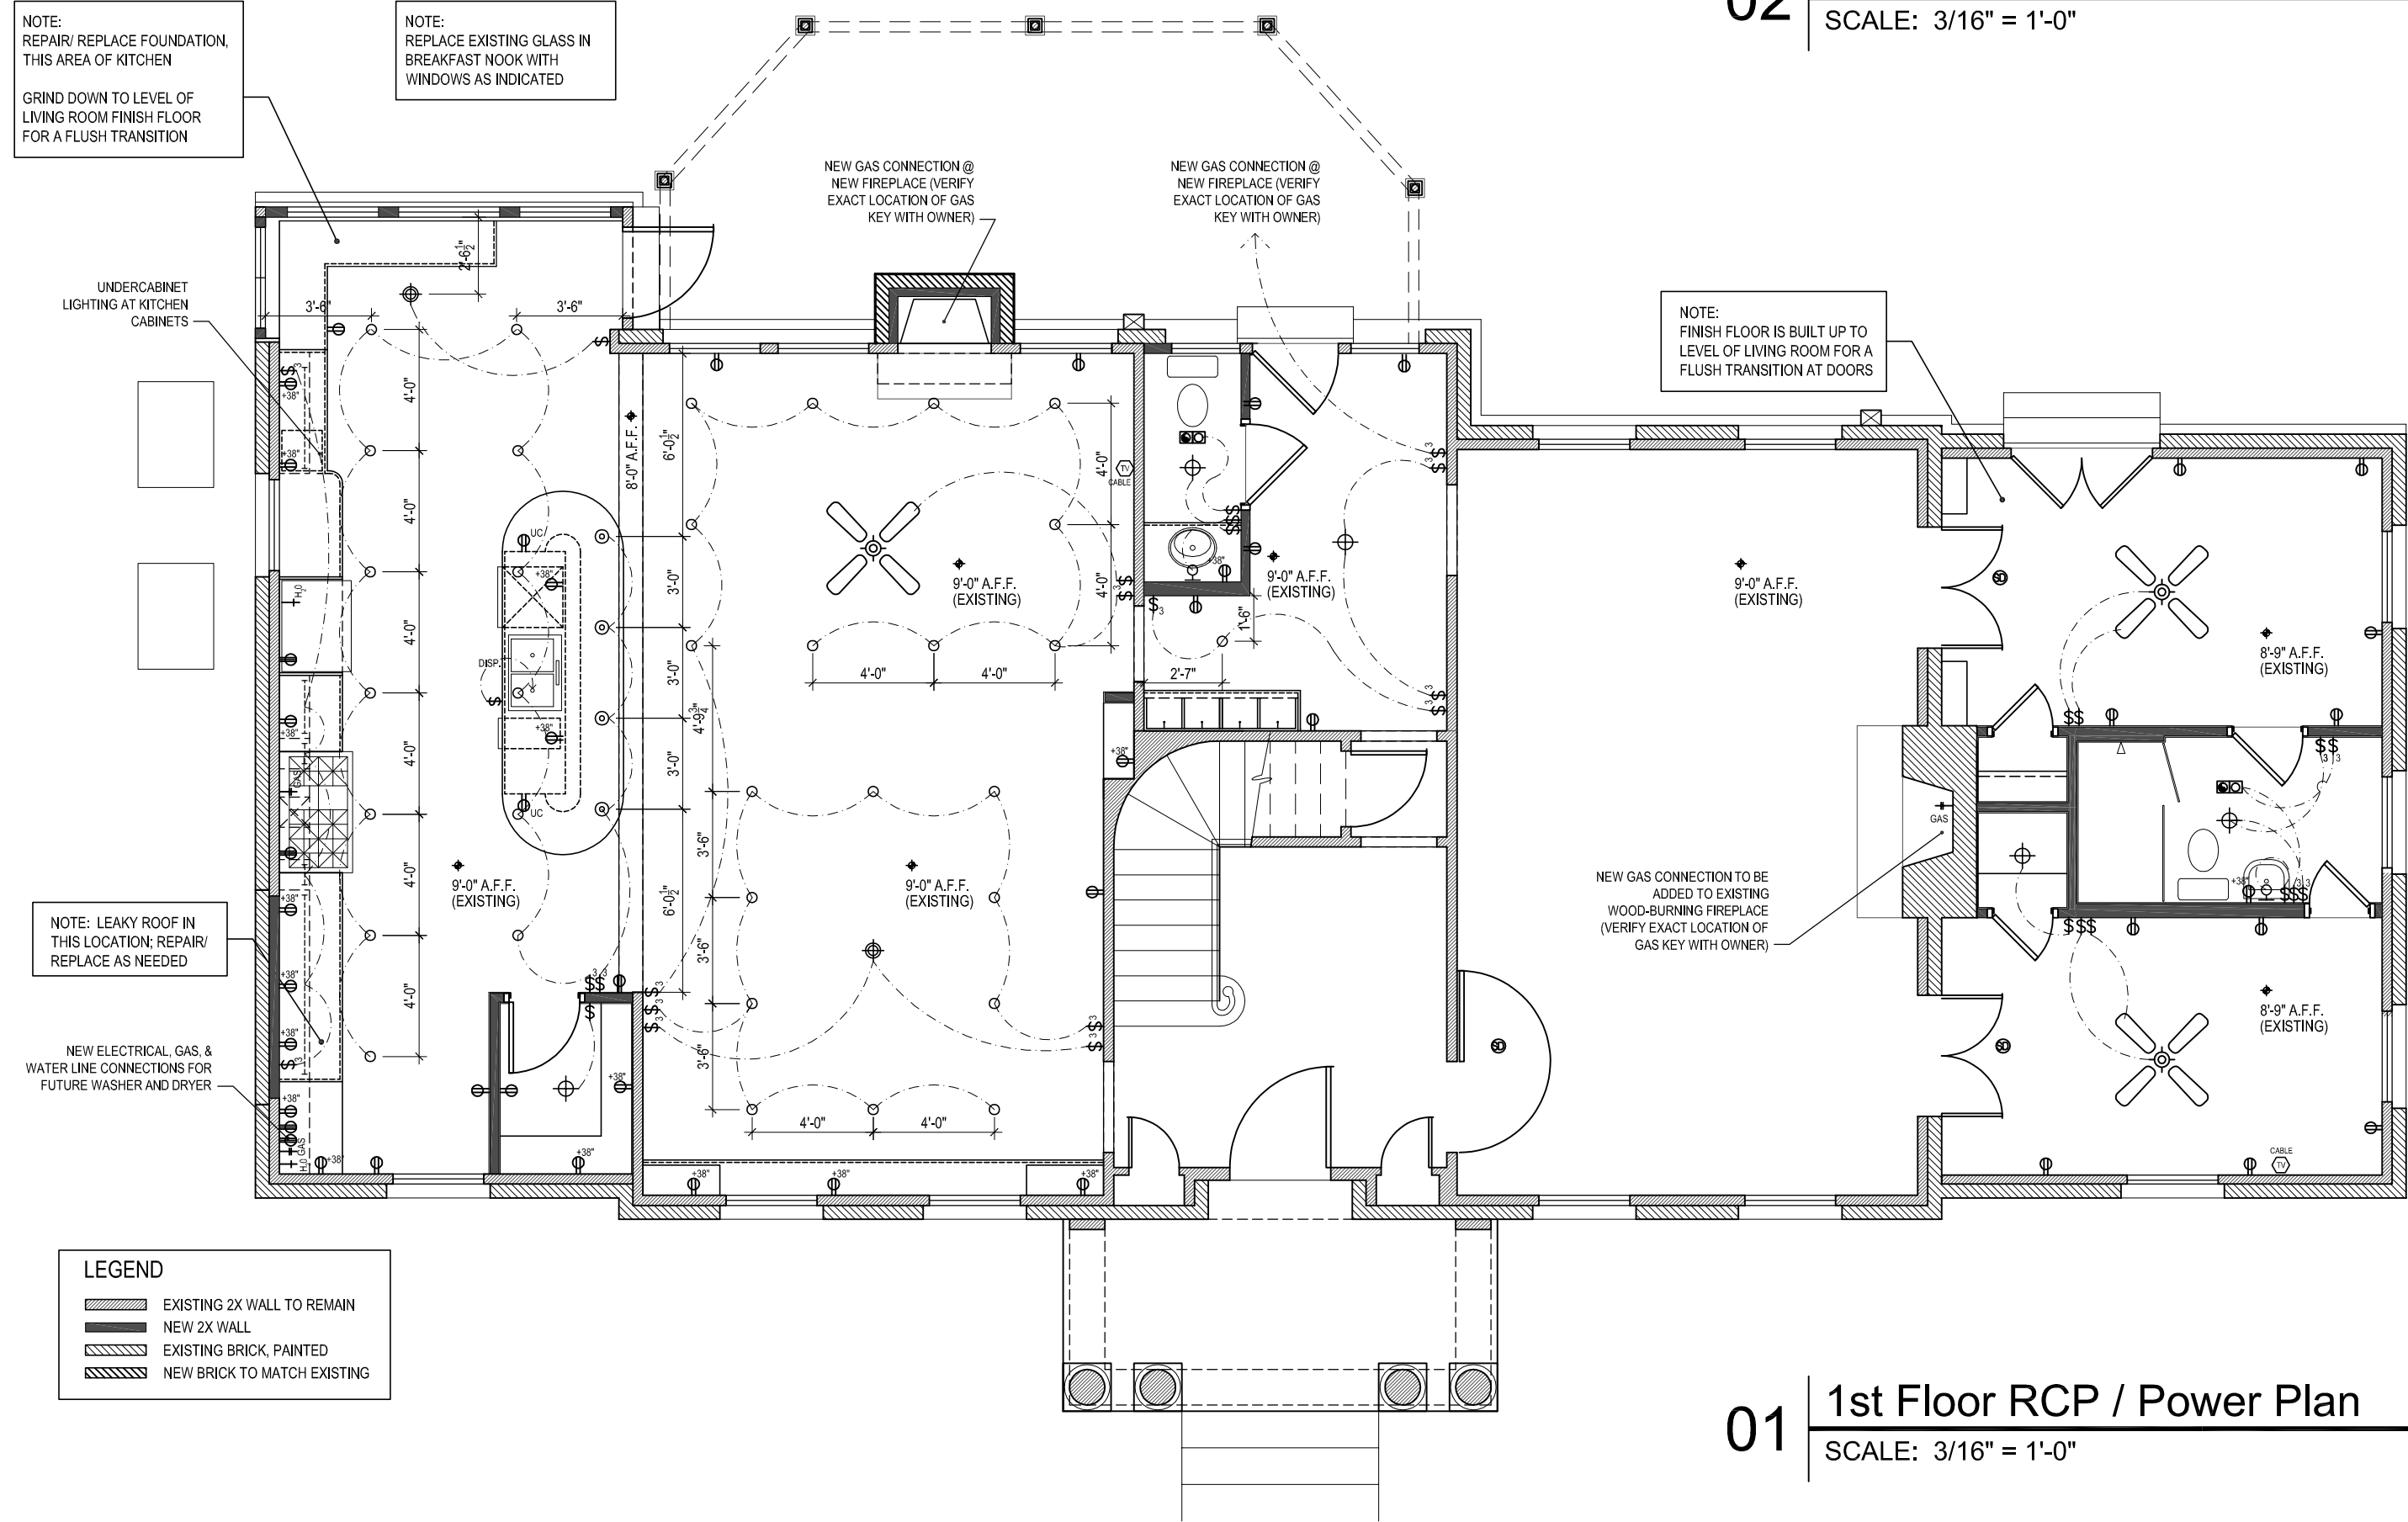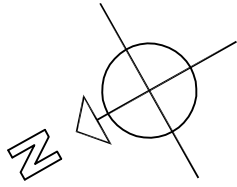

LEGEND
EXISTING 2X WALL TO REMAIN
NEW 2X WALL
EXISTING BRICK, PAINTED
NEW BRICK TO MATCH EXISTING

01 | 1st Floor RCP / Power Plan

SCALE: 3/16" = 1'-0"

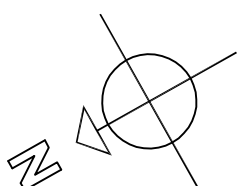


SYMBOL LEGEND

- 7'-0" A.F.F.
- BELL
- DOORBELL W/ LIGHT
- LIGHT, FAN, RECEPTICAL SWITCH
- THREE-WAY WALL SWITCH
- DIMMER SWITCH
- SWITCH LOCATED IN CABINETRY
- STANDARD DUPLEX RECEPTICAL
- STANDARD DUPLEX RECEPTICAL INSTALLED 36" ABOVE F.F.
- DUPLEX RECEPTICAL FOR MAJOR APPLIANCES
- STANDARD WATERPROOF DUPLEX RECEPTICAL
- UNDER COUNTER DUPLEX RECEPTICAL
- SWITCH-OPERATED DUPLEX RECEPTICAL
- FLOOR OUTLET
- CEILING OUTLET
- TELEPHONE
- CABLE / TELEVISION
- PLUMBING CONNECTION
- GAS CONNECTION
- HOSE BIBB
- THERMOSTAT
- MOTION-ACTIVATED SECURITY LIGHT

LIGHT FIXTURE SCHEDULE

- SMOKE DETECTOR (PER CODE)
- WALL-MOUNTED FIXTURE
- EXTERIOR WALL SCONCE
- RECESSED DOWNLIGHT
- DIRECTIONAL RECESSED LIGHT
- HEAT / FAN / LIGHT COMBO - VENT TO OUTSIDE AIR
- EXHAUST FAN / LIGHT COMBO - VENT TO OUTSIDE AIR
- EXHAUST FAN - VENT TO OUTSIDE AIR
- FLUSH-MOUNTED CEILING FIXTURE
- PENDANT
- UNDER-CABINET LED LIGHTING STRIP
- CEILING FAN W/ LIGHT (EXTERIOR TO BE UL WET RATED)
- IN-WALL STEP LIGHT
- UL WET RATED EXTERIOR DOWNLIGHT SURFACE MOUNT
- UTILITY FLUORESCENT
- CHANDELLER
- WET-RATED LIGHT W/ INTEGRAL FAN

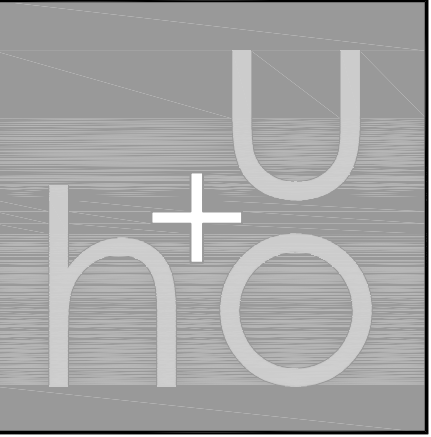

hatch + ulland owen
architects

1010 East 11th Street
Austin, Texas 78702
T: 512.474.8548
F: 512.474.8643

www.huoaarchitects.com


Contractor:
David Bratton
Watermark Homes by
David Bratton
4208 Avenue D
Austin Texas 78751
Cell - 512-233-9301
Fax - 512-291-7650
watermarkhomesaustin.com

Structural Engineer:
DCI Engineers
600 Congress Avenue, Suite 1210
Austin, Texas 78701
512.472.9797

WEBSTER RESIDENCE
REMODEL

2321 HARTFORD ROAD, AUSTIN, TEXAS 78703


NOTE: This document, the ideas and design incorporated herein are and shall remain the property of huo architects. These documents are not to be used or altered, in whole or in part, for other than the original intended use, nor are they to be assigned to any third party without written permission from huo architects.

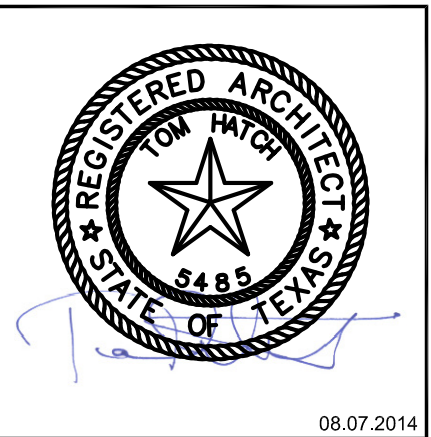


ISSUE DATES:	
08/07/14	PERMIT SET
....	
....	
Proposed
Exterior Elevations

A3.1

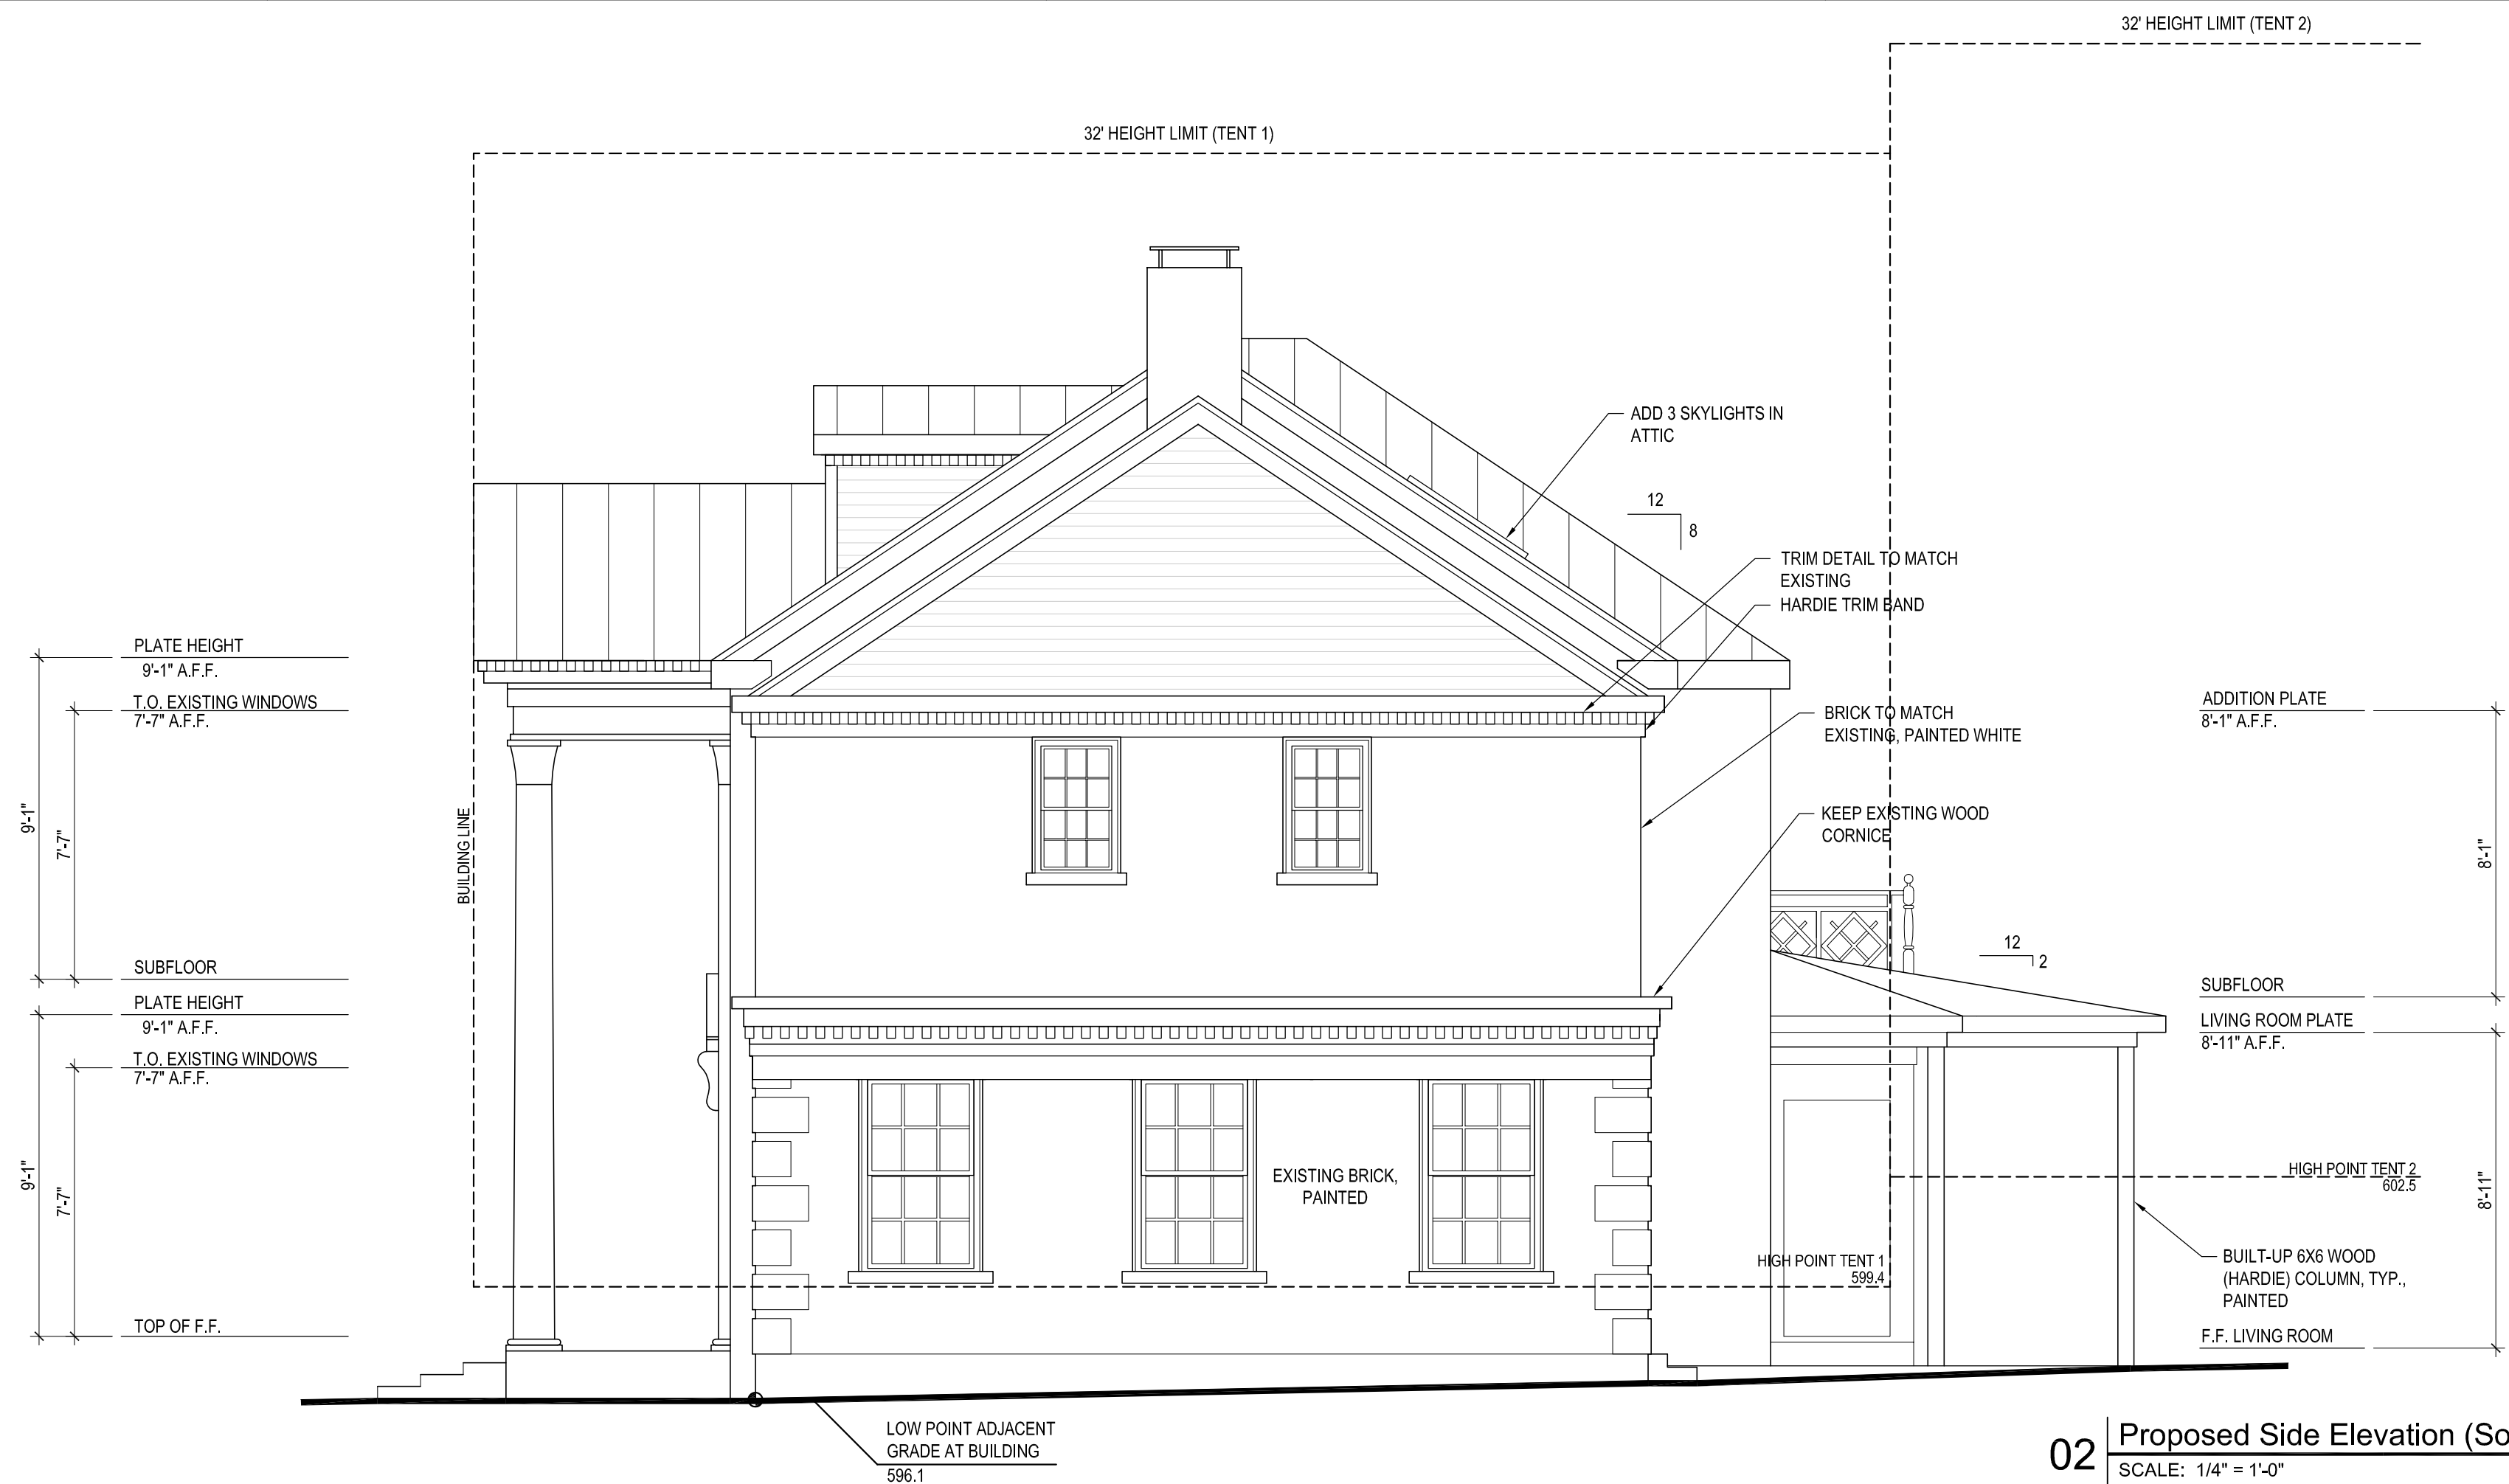

02 Proposed Side Elevation (South)
SCALE: 1/4" = 1'-0"

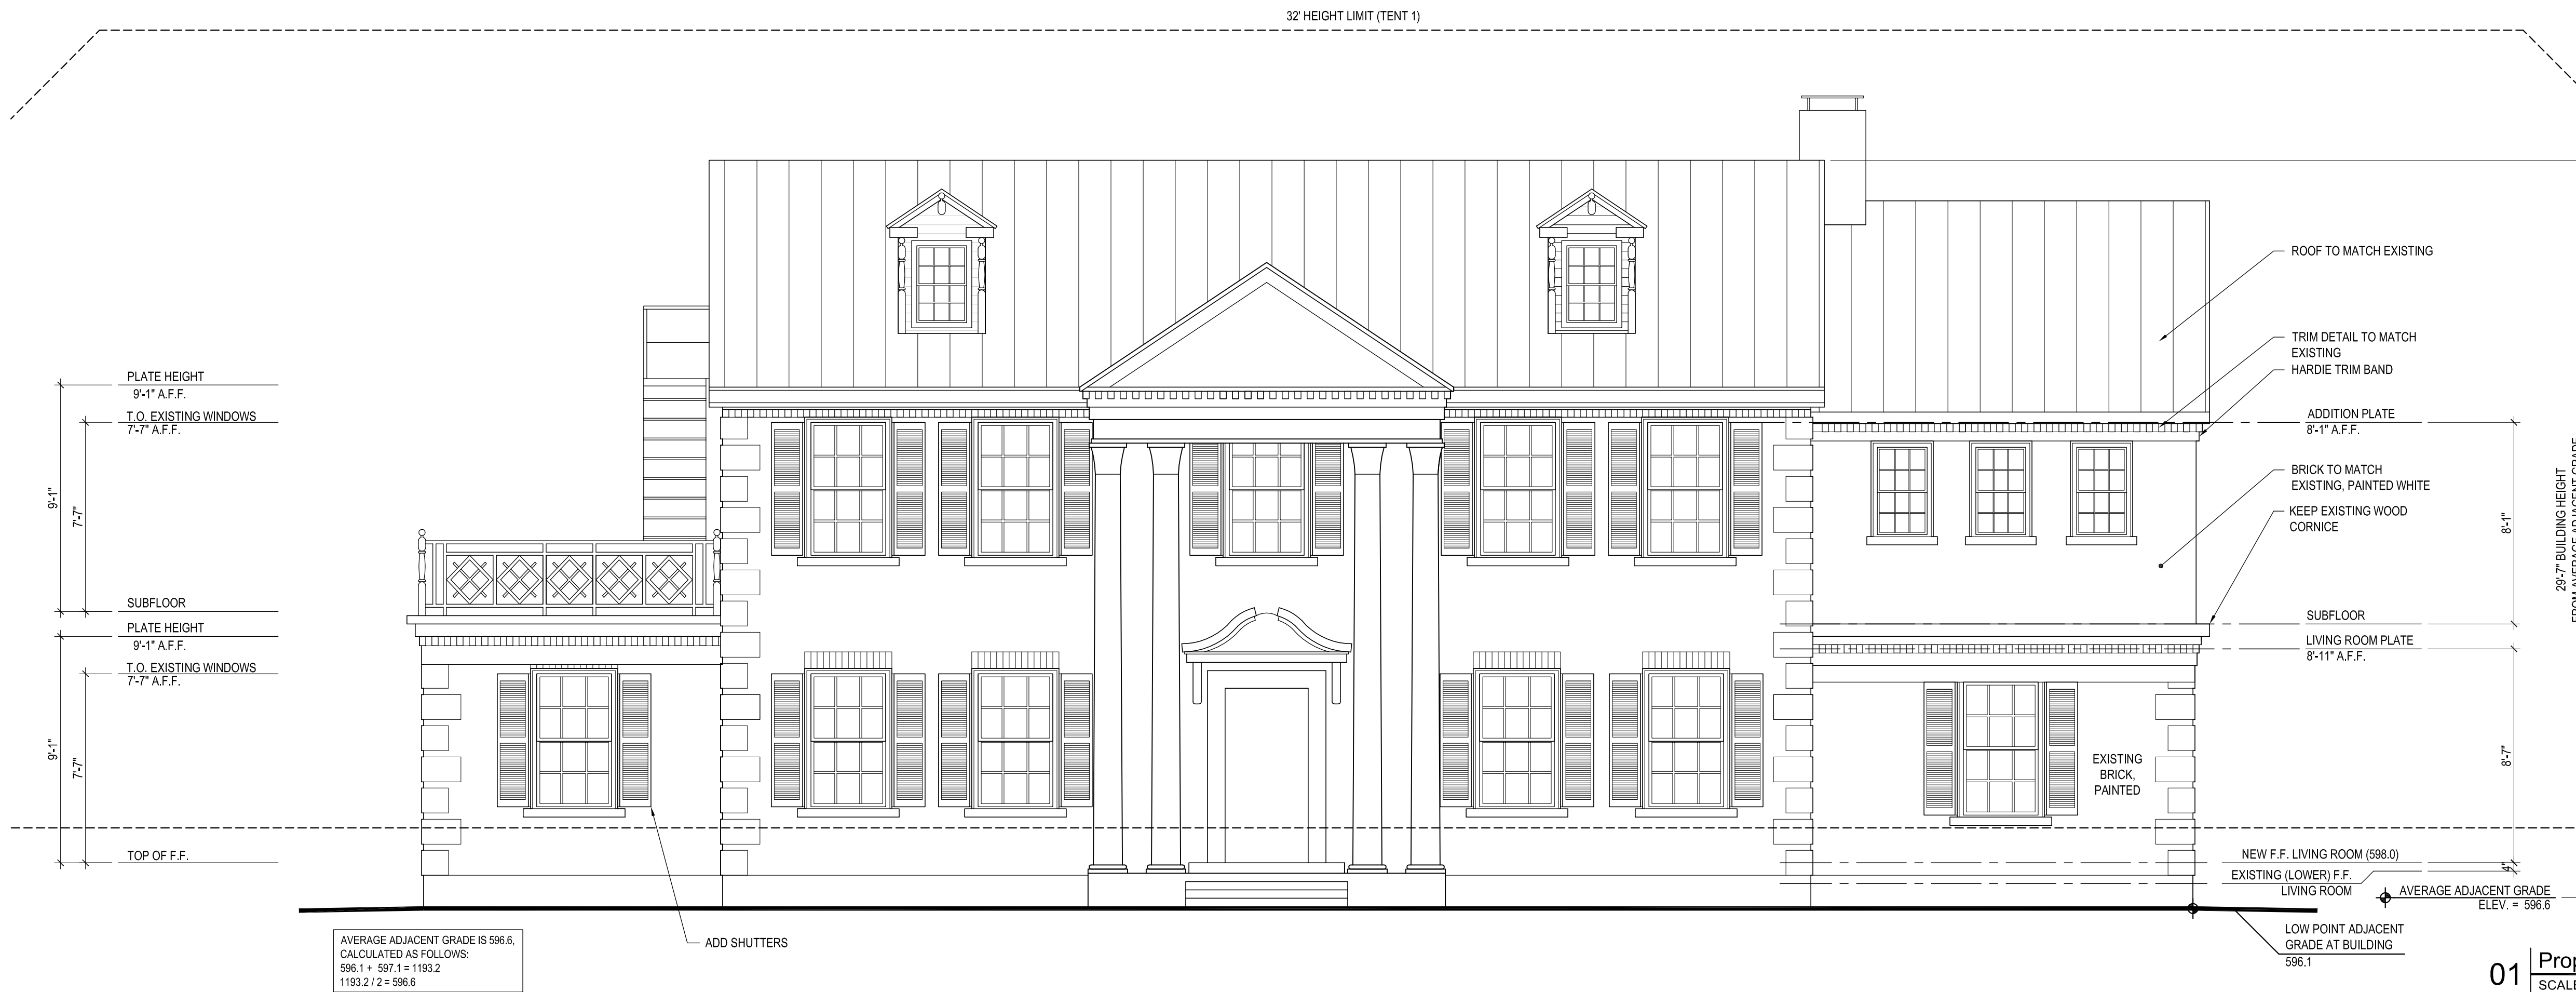

01 Proposed Front Elevation
SCALE: 1/4" = 1'-0"



010 East 11th Street
Austin, Texas 78702
: 512.474.8548
: 512.474.8643

www.huoarchitects.com

Contractor:

David Bratton
Watermark Homes by
David Bratton
208 Avenue D
Austin Texas 78751
Cell - 512-233-9301
Fax - 512-291-7650
watermarkhomesaustin.com

Structural Engineer:

OCI Engineers
100 Congress Avenue, Suite 1210
Austin, Texas 78701
512.472.9797

WEBSTER RESIDENCE
REMODEL

2321 HARTFORD ROAD, AUSTIN, TEXAS 78703

NOTE: This document, the ideas and designs incorporated herein are and shall remain the property of h+uo architects. These documents are not to be used or altered, in whole or in part, for other than the original intended use, nor are they to be assigned to any third party without written permission from h+uo architects.





ISSUE DATES:

[illegible]

Proposed Exterior Elevations

A3.2

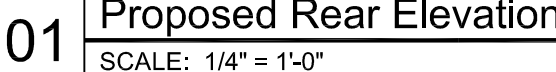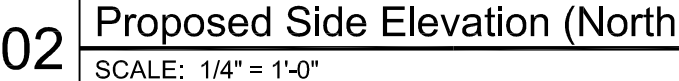

PROPERTY LINE