



3 SIDE ELEVATION / EXISTING
SCALE: 1/8" = 1'-0"

1 FRONT ELEVATION / EXISTING
SCALE: 1/8" = 1'-0"

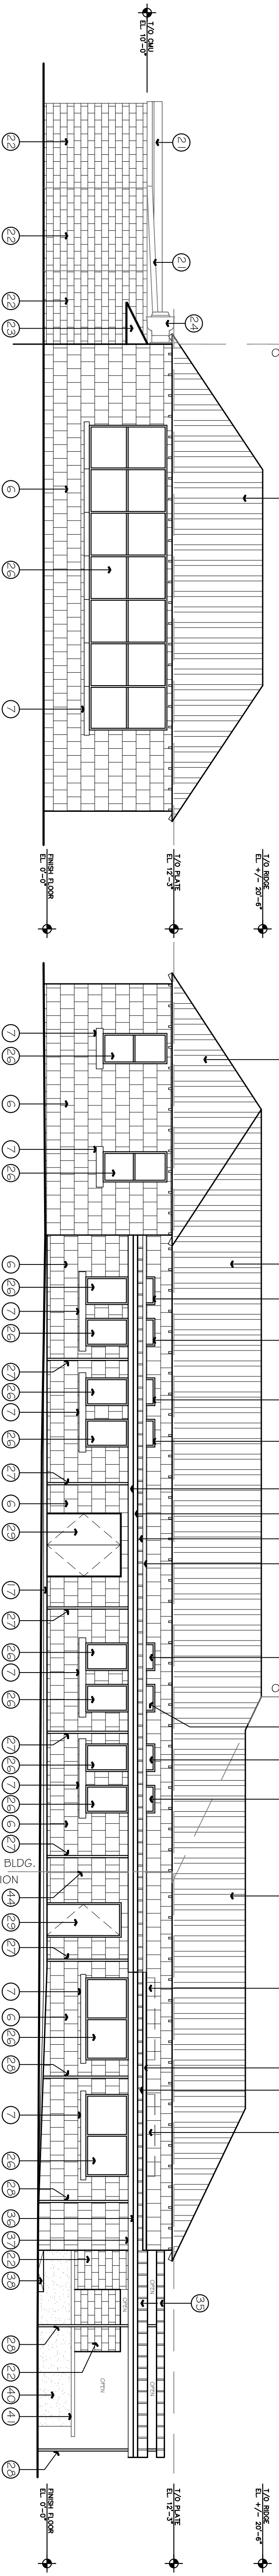


3A SIDE ELEVATION / PROPOSED
SCALE: 1/8" = 1'-0"

1A FRONT ELEVATION / PROPOSED
SCALE: 1/8" = 1'-0"

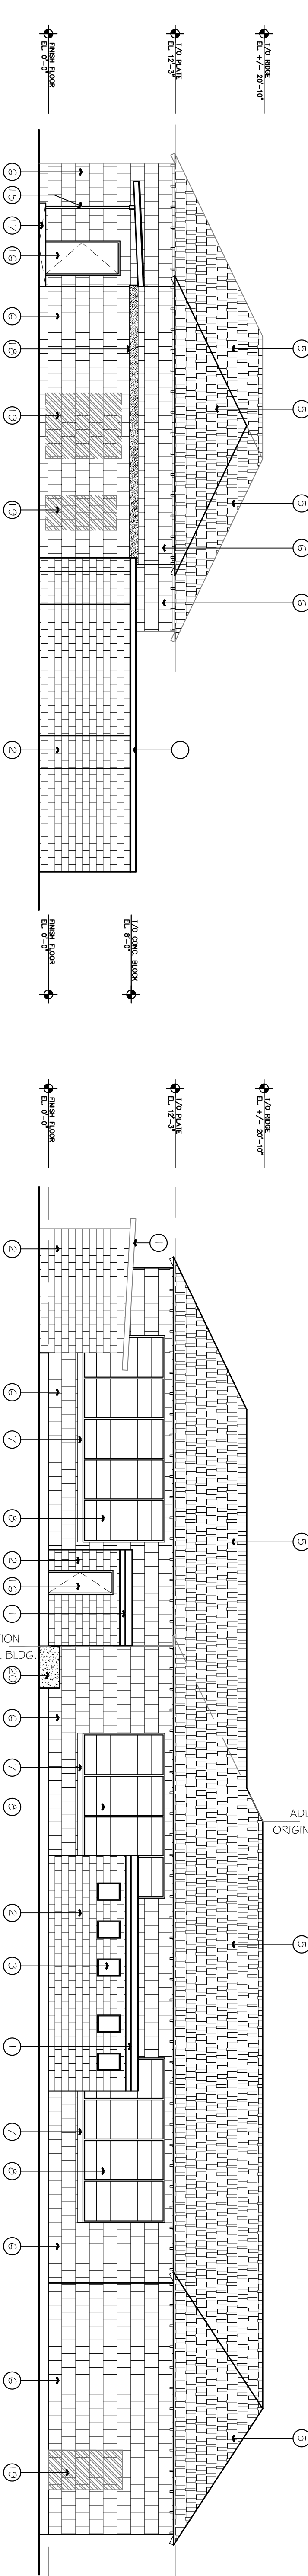


2 REAR ELEVATION / EXISTING
SCALE: 1/8" = 1'-0"

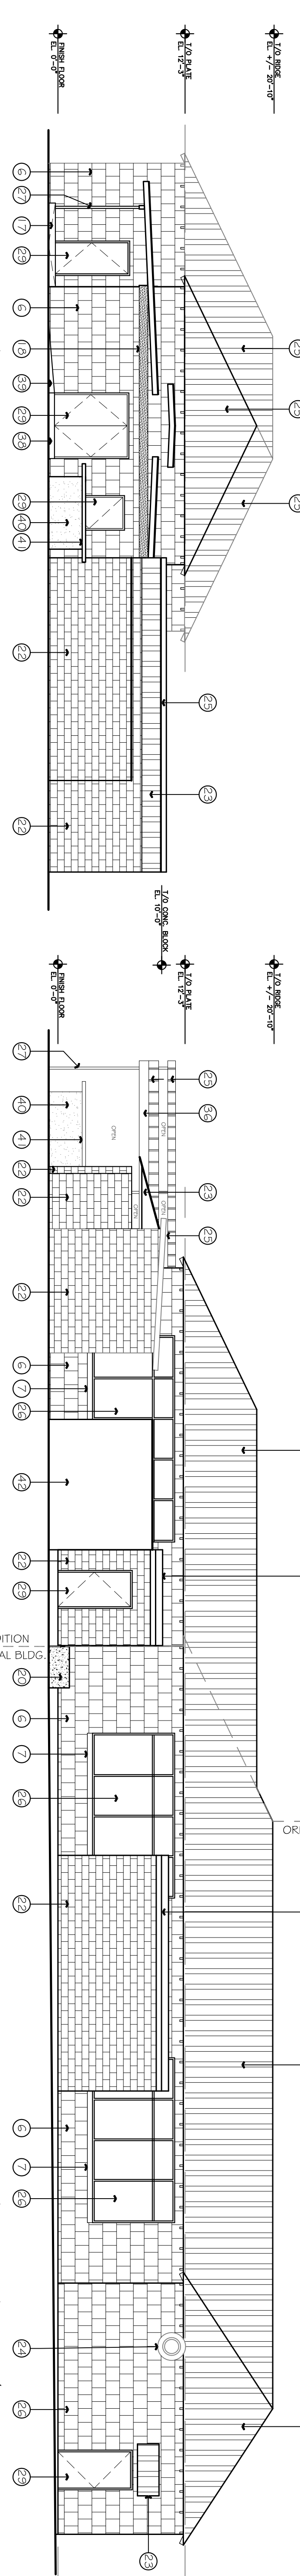

2A REAR ELEVATION / PROPOSED
SCALE: 1/8" = 1'-0"

4 SIDE ELEVATION / EXISTING
SCALE: 1/8" = 1'-0"

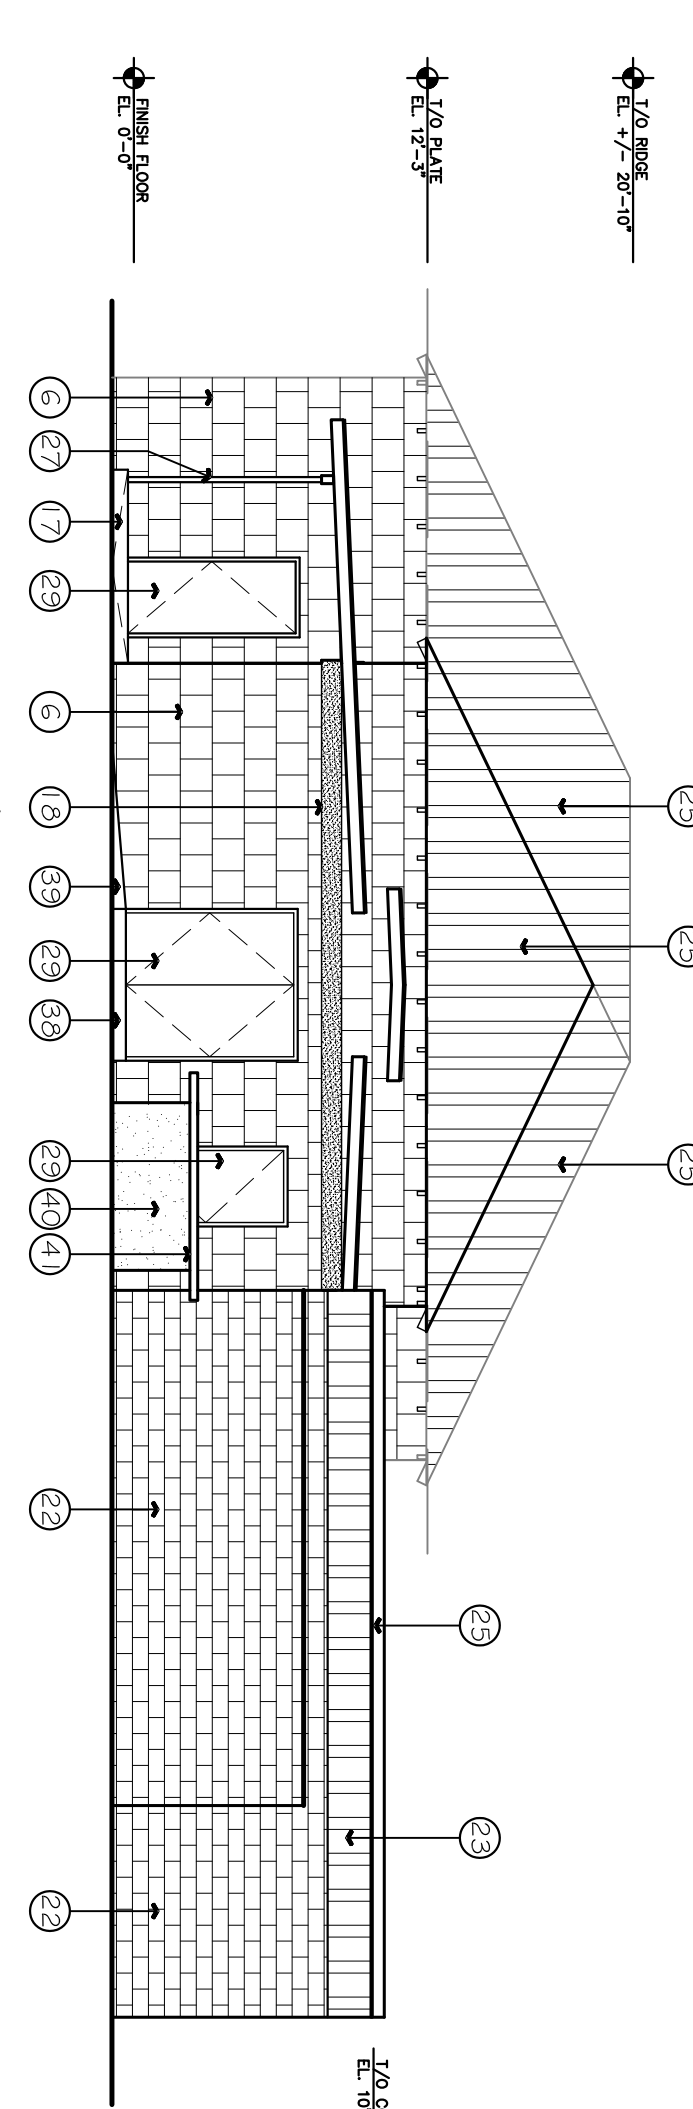

4A SIDE ELEVATION
SCALE: 1/8" = 1'-0"

EXTERIOR ELEVATION GENERAL KEYNOTES

1. DEMO EXISTING METAL ROOF & FRAME.
2. DEMO EXISTING CONCRETE BLOCK WALL.
3. OPENING IN WALL.
4. DEMO WOOD PANEL IN WINDOW OPENING.
5. DEMO EXISTING SHINGLE ROOF - FLASHING/FACE ROOF DECK AS NECESSARY.
6. STONE SILL.
7. DEMO WINDOW & FRAME.
8. DEMO A/C WINDOW UNIT.
9. DEMO GLASS BLOCK & FRAME.
10. DEMO EXISTING WOOD FASCIA.
11. METAL ROOF OVER SIDEWALK.
12. FLASHING.
13. METAL POST.
14. REPAIR (E) WOOD BEAM AS NECESSARY. PAINT.
15. CONCRETE SIDEWALK.
16. DEMO JOIST SUPPORT.
17. DEMO PORTION OF WALL FOR NEW DOOR OPENING.
18. (N) METAL FLASHING.
19. (N) WOOD BEAM. PAINT.
20. (N) CONCRETE BLOCK WALL.
21. (N) METAL AWNING.
22. (N) KITCHEN EXHAUST FAN.
23. (N) METAL ROOF FRAME.
24. (N) METAL POST.
25. (N) DOOR & FRAME.
26. (N) METAL FLASHING.
27. (N) METAL FLASHING.
ELEVATION GENERAL NOTES

1. THE DIMENSIONS ON THIS SHEET ARE BASED OFF THE FACE OF FINISH MATERIAL, OR MASONRY. ALL DIMENSIONS ARE TO FACE OF FINISH MATERIAL, EDGE OF AWNING, OR CENTERLINE OF SUPPORT, UNLESS OTHERWISE NOTED.
 2. KEYNOTES ON THIS SHEET ARE FOR THIS SHEET ONLY.
 3. FOR CLARITY PURPOSES, THE FINISH FLOOR ELEVATION (FFE) IS EQUAL TO THE TOP OF SLAB (TPO SLAB) WHICH IS EQUAL TO O.O.-.
 4. PROVIDE FINISH MATERIAL SAMPLES FOR OWNER APPROVAL.
- LIMITED SERVICE CONTRACT:
PLEASE NOTE THAT THESE DRAWINGS WERE PRODUCED UNDER A LIMITED OR PARTIAL SERVICES CONTRACT. NOT ALL DETAILS OR CONSTRUCTION NOTES HAVE BEEN SHOWN. THE ARCHITECT'S RESPONSIBILITY IS TO REVIEW AND REVIEW DURING CONSTRUCTION.

REVISIONS		
NO.	DATE	DESCRIPTION

BRINKS PIZZA
6240 WEST HWY 290
Austin, TX 78735

© 2015 M.A.D. Architecture
All Rights Reserved. The
drawings and notes herein
are the sole property of M.A.D.
Architecture and may not be
reproduced in any form without
written permission from the
Architect.

JOB NO.: 1524
PHASE:
DRAWN:
CHECKED:
DATE: August 25, 2015


Exterior Elevations

SHEET
A5.0

ASBUILT SURVEY

BEING 4.18 ACRES OF LAND, INCLUDING LOTS 7,8,13&14 OF THE TOWN OF DATMANVILLE, A SUBDIVISION IN TRAVIS COUNTY, TEXAS, ACCORDING TO THE MAP OR PLAT THEREOF, RECORDED IN BOOK 'X', PAGE 242, OF THE DEED RECORDS OF TRAVIS COUNTY, TEXAS, AND BEING COMPRISED OF A PORTION OF A TRACT OF LAND DESCRIBED AS 4.18 ACRES, BY METES AND BOUNDS, PREPARED BY BILLY F. PRIEST, REGISTERED PROFESSIONAL LAND SURVEYOR NO. 828, DATED MARCH 22, 1968, AND THAT CERTAIN TRACT OF LAND DESCRIBED IN A DEED RECORDED IN VOLUME 1447, PAGE 538, OF THE DEED RECORDS OF TRAVIS COUNTY, TEXAS.

AUSTIN INDEPENDANT SCHOOL DISTRICT
3972/481

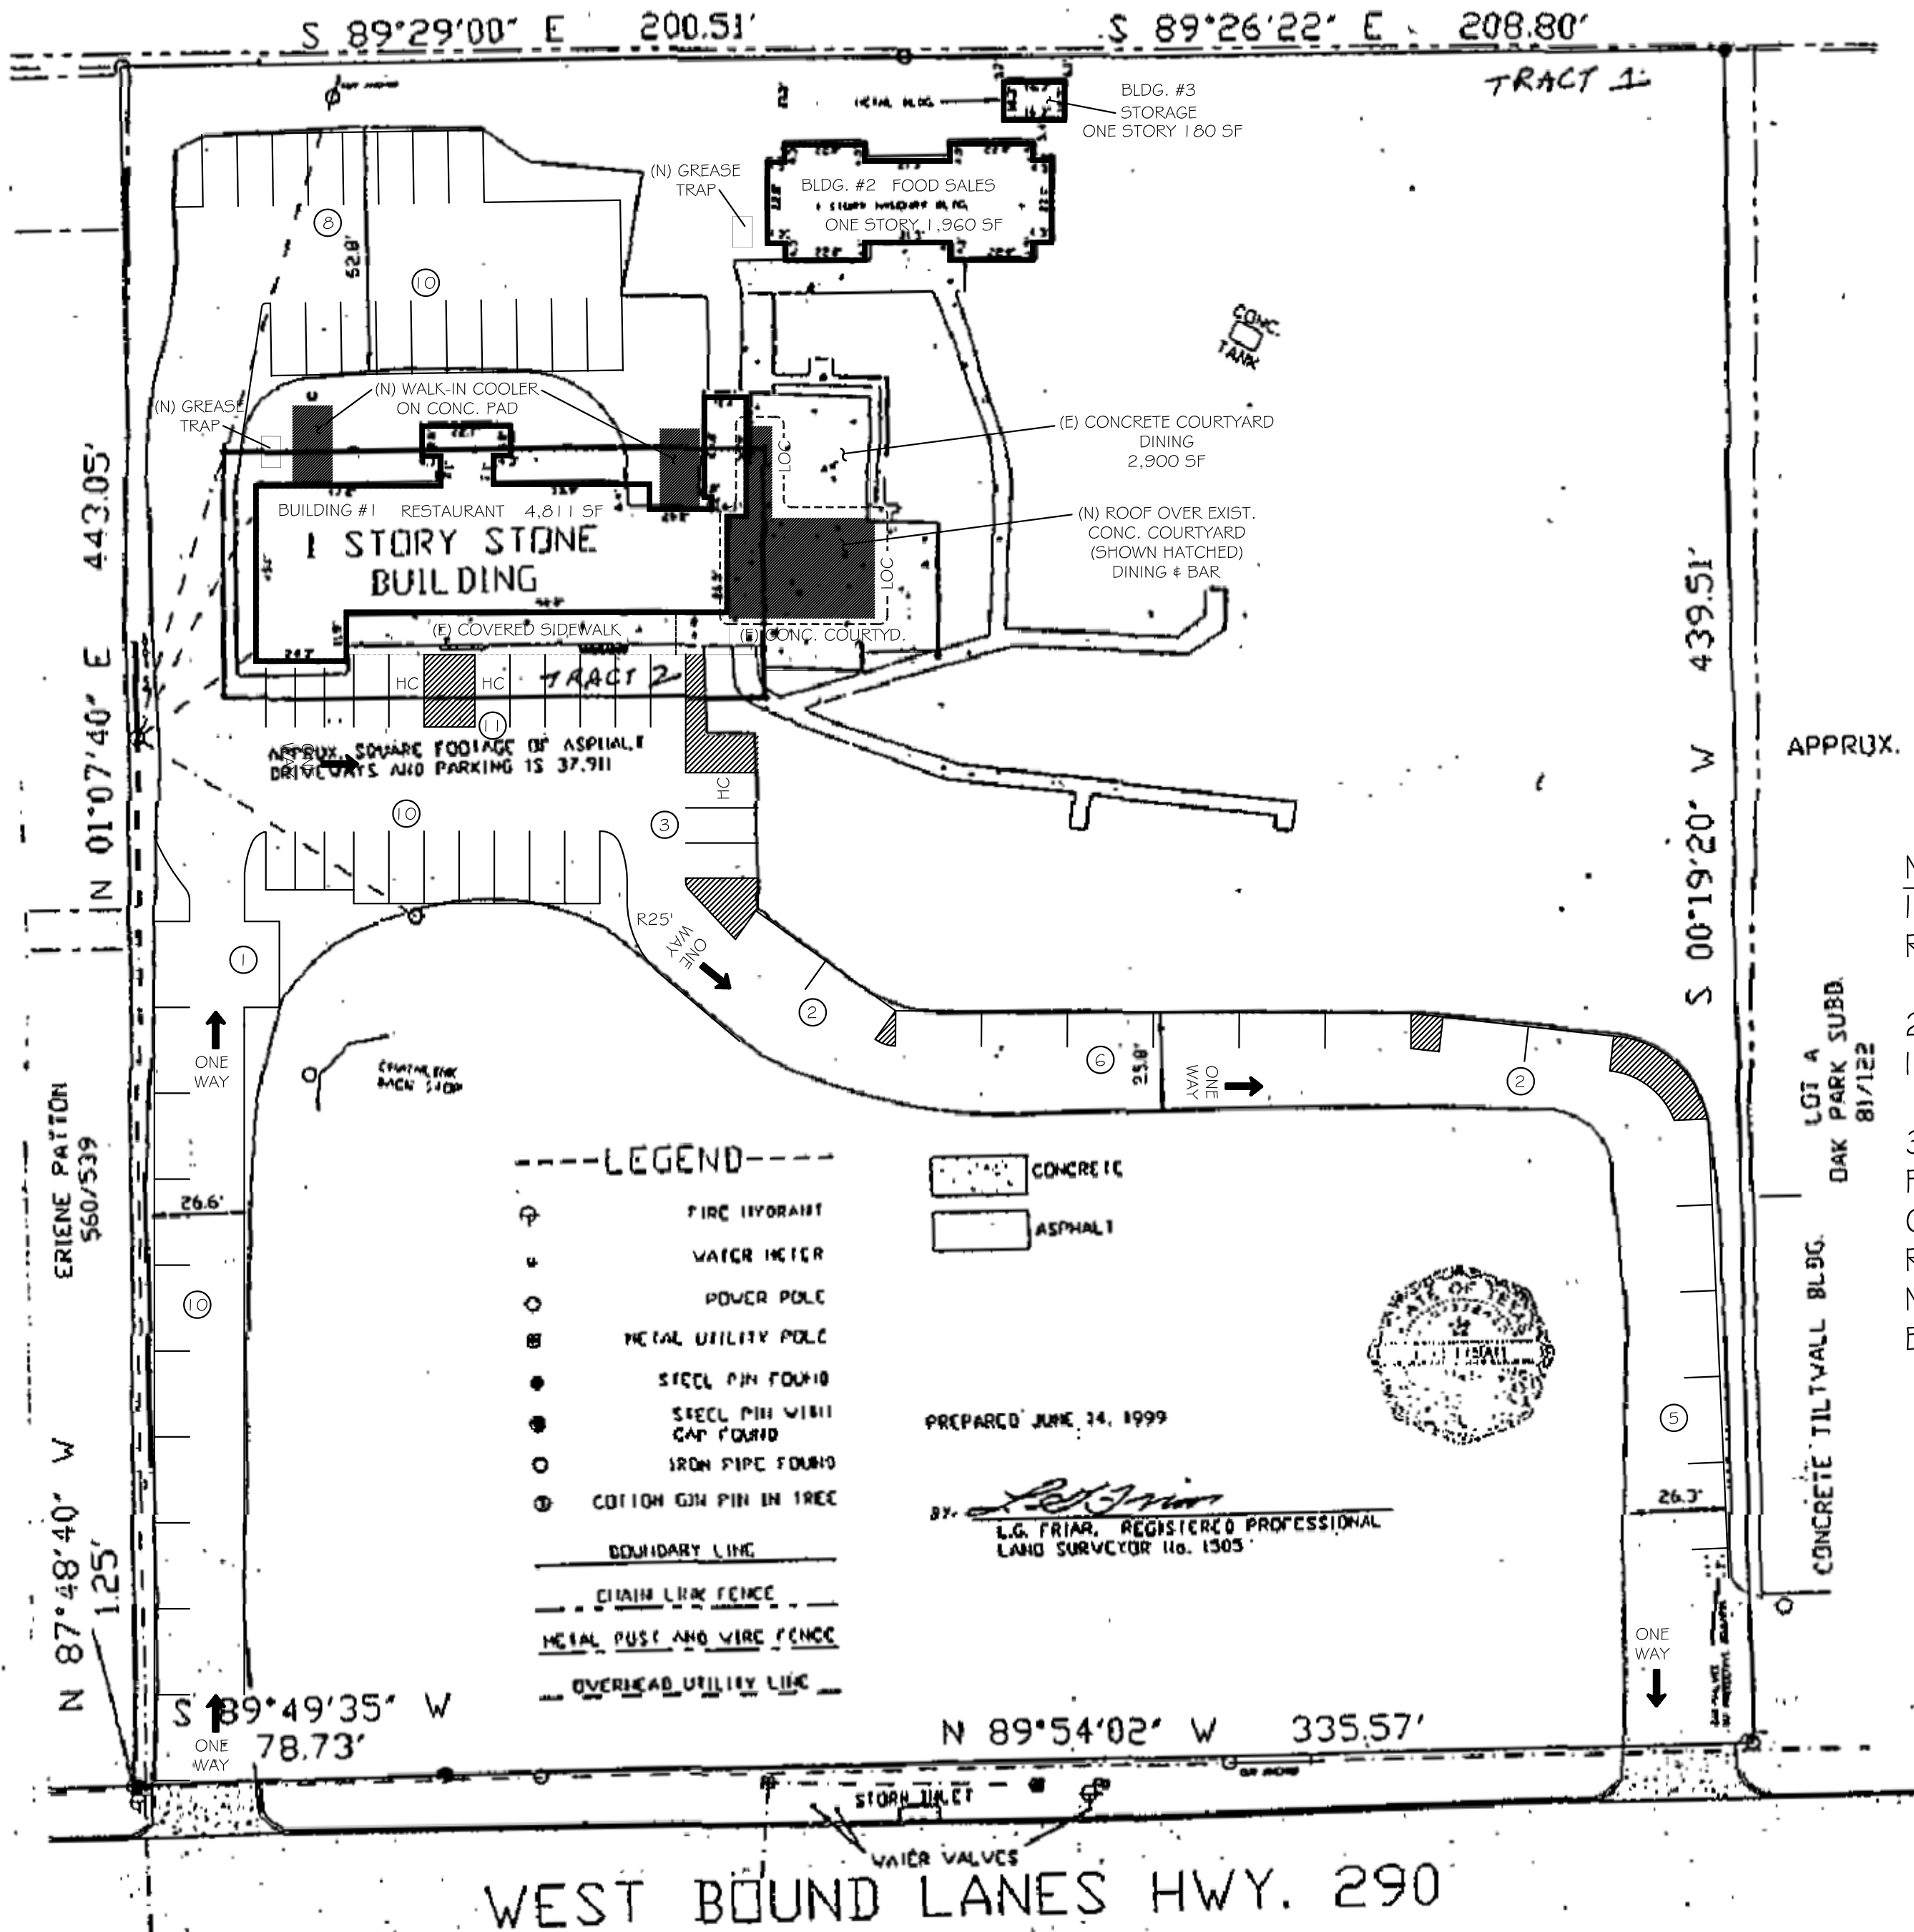

NOTES:

1) SURVEY IS USED FOR REFERENCE PURPOSES ONLY.

2) ALL WORK IS ON EXISTING IMPERVIOUS COVER.

3) NO SPRINKLER SYSTEM IS PROPOSED. OCCUPANT LOAD FOR THE RESTAURANT (BLDG. 2) DOES NOT EXCEED 100 PEOPLE FOR EACH FIRE AREA.

AUG. 6, 2015

EXHIBIT A