

PROJECT INFORMATION

PROJECT DESCRIPTION:

INTERIOR RENOVATION OF EXISTING RESTAURANT & BAR + KITCHEN RENOVATION & PATIO RENOVATIONS + NEW STAGE & BATHROOMS

PROJECT ADDRESS:

1607 SAN JACINTO BLVD. AUSTIN TEXAS 78701

CODE DATA

APPLICABLE CODES:
2012 IBC AMENDED INTERNATIONAL BUILDING CODE INC
2009 INTERNATIONAL EXISTING BUILDING CODE
2009 IECC INTERNATIONAL ENERGY CONSERVATION CODE
2006 NEC AMENDED NATIONAL ELECTRICAL CODE
2009 IFC INTERNATIONAL FIRE CODE
2009 IPMC INTERNATIONAL PROPERTY MAINTENANCE CODE
2009 UMC AMENDED UNIFORM MECHANICAL CODE
2009 UPC AMENDED UNIFORM PLUMBING CODE
2012 TAS TEXAS ACCESSIBILITY STANDARDS

TYPE OF DEVELOPMENT:

RESTAURANT

GROUP/OCCUPANCY:

A-2

ZONING:

CS-GR-MF-4

TYPE OF CONSTRUCTION:

EXISTING: III-A
NEW: III-A

NUMBER OF STORIES:

EXISTING: 1
NEW: 2

SIGN OFF

X

APPROVED SITE PLAN EXEMPTION NO.

CONTACTS

APPLICANT

PERMIT PARTNERS

CONTACT: CLAUDIA SANCHEZ

EMAIL: CLAUDIA@PERMIT-PARTNERS.COM

DESIGN

NORTH ARROW STUDIO

CONTACT: FRANCISCO X. ARREDONDO

E-MAIL: FX@NORTHARROWSTUDIO.COM

PHONE: 512.956.0644

DRAWING INDEX

DESIGN

0.1 COVER SHEET
1.0 SITE PLAN
1.1 AS-BUILT & DEMO PLAN
1.2 PROPOSED DESIGN PLAN

2.1 PROPOSED STAGE DESIGN: E 17TH ELEVATION
2.2 PROPOSED AWNING DESIGN
2.3 WEST ELEVATION
2.4 EAST ELEVATION
2.5 SOUTH ELEVATION
2.6 NORTH ELEVATION

3.1 HISTORICAL PHOTOGRAPHS
3.2 SANBORN MAPS

SYMBOLS

01

NORTH ARROW

DRAWING NUMBER

PLAN:1ST LEVEL

3/16" = 1'-0"

DRAWING TITLE

DINING

TILE

ROOM NAME

112'-4"

CONCRETE

ELEVATION MARKER

2/2.3

BUILDING ELEVATION MARKER

2/2.3

B

A

C

D

2

2.3

INTERIOR ELEVATION MARKER

2

2.3

WALL SECTION/DETAIL MARKER

200

DOOR DESIGNATION NUMBER

J

WINDOW DESIGNATION NUMBER

CL

CENTERLINE

02

REVISION MARKER

DROP

FLOOR DROP

UP

DN

STAIRS DESIGNATION

2'-10"

DIMENSIONS

02

FINISH MARKER IN ELEVATIONS

07

EQUIPMENT TAG

F.F. CHANGE

FINISH FLOOR CHANGE

GRAPHIC LEGEND

A

NEW STONE VENEER WALL W/ 2 X 4 STUD WALL

B

NEW 2 X 4 STUD WALL

C

EXT'G. BRICK WALL

D

NEW 2 X 4 STUD WALL W/ STUCCO

E

NEW STUD WALL OVER EXT'G. BRICK WALL

F

NEW BRICK WALL

G

NEW PTD. CMU GARDEN WALL

AREA DRAIN

HOSE BIB

DROP

DROP

TREE TRUNKS

NOTES:

-> FOR INT. WALL FINISHES SEE INT. ELEV. , WALL FINISHES SHEET
-> FOR EXT. WALL FINISHES SEE EXT. ELEV.
-> VERIFY ALL DIMENSIONS IN-FIELD
-> VERIFY ALL UTILITIES IN FIELD

VICINITY MAP

NORTH ARROW STUDIO

NORTHARROWSTUDIO.COM

INFO@NORTHARROWSTUDIO.COM

512.956.0644

SEAL

PROJECT

SCHOLZ BEER GARTEN

1607 SAN JACINTO BLVD.
AUSTIN, TX 78701

REVISIONS

01

HLC REVISION 2017-11-21

SET ISSUED

TITLE OF SHEET

COVER SHEET

NUMBER OF SHEET

0.1

CAUTION

DO NOT SCALE DRAWINGS

THESE DRAWINGS ARE THE PROPERTY OF THE DESIGNER & MAY ONLY BE USED IN CONJUNCTION WITH THIS PROJECT

PROJECT INFORMATION

PROJECT DESCRIPTION:
INTERIOR RENOVATION OF EXISTING RESTAURANT & BAR +
KITCHEN RENOVATION & PATIO RENOVATIONS + NEW STAGE
& BATHROOMS

PROJECT ADDRESS:
1607 SAN JACINTO

PROJECT CONTACT:
CLAUDIA SANCHEZ
CLAUDIA@PERMIT-PARTNERS.COM

TYPE OF DEVELOPMENT:
RESTAURANT

GROUP/OCCUPANCY:
A-2

ZONING:
CS-GR-MF-4

TYPE OF CONSTRUCTION:
EXISTING: III-A
NEW: III-A

NUMBER OF STORIES:
EXISTING: 1
NEW: 2

AREA CALCULATIONS

SITE PLAN EXEMPTION REQUIREMENTS
NEW DEVELOPMENT ALLOWED 01,000 SQ.FT.
LIMITS OF CONSTRUCTION ALLOWED: 03,000 SQ.FT.

NEW DEVELOPMENT:


NEW 2 STORY STAGE & BATHROOM BLDG:	720 SQ.FT.
NEW PATIO BAR:	029 SQ.FT.
TOTAL:	749 SQ.FT.

LIMITS OF CONSTRUCTION AREAS:

NEW 2 STORY STAGE & BATHROOM BLDG:	720 SQ.FT.
NEW STAIRCASE:	081 SQ.FT.
NEW RAMP:	072 SQ.FT.
NEW SERVICE BOX:	010 SQ.FT.
NEW UNPAVED AREA:	285 SQ.FT.
NEW PLANTER BED:	132 SQ.FT.

TOTAL: 1,300 SQ.FT.

IMP. COVER AND FAR REQUIREMENTS:
TOTAL LOT SIZE: 29,241 SQ.FT.
MAX. BUILDING COVERAGE 95% 19,000 SQ.FT.
MAX. IMP. COVER 95%: 27,000 SQ.FT.
MAX. FLOOR AREA RATIO 2:1: 00,000 SQ.FT.

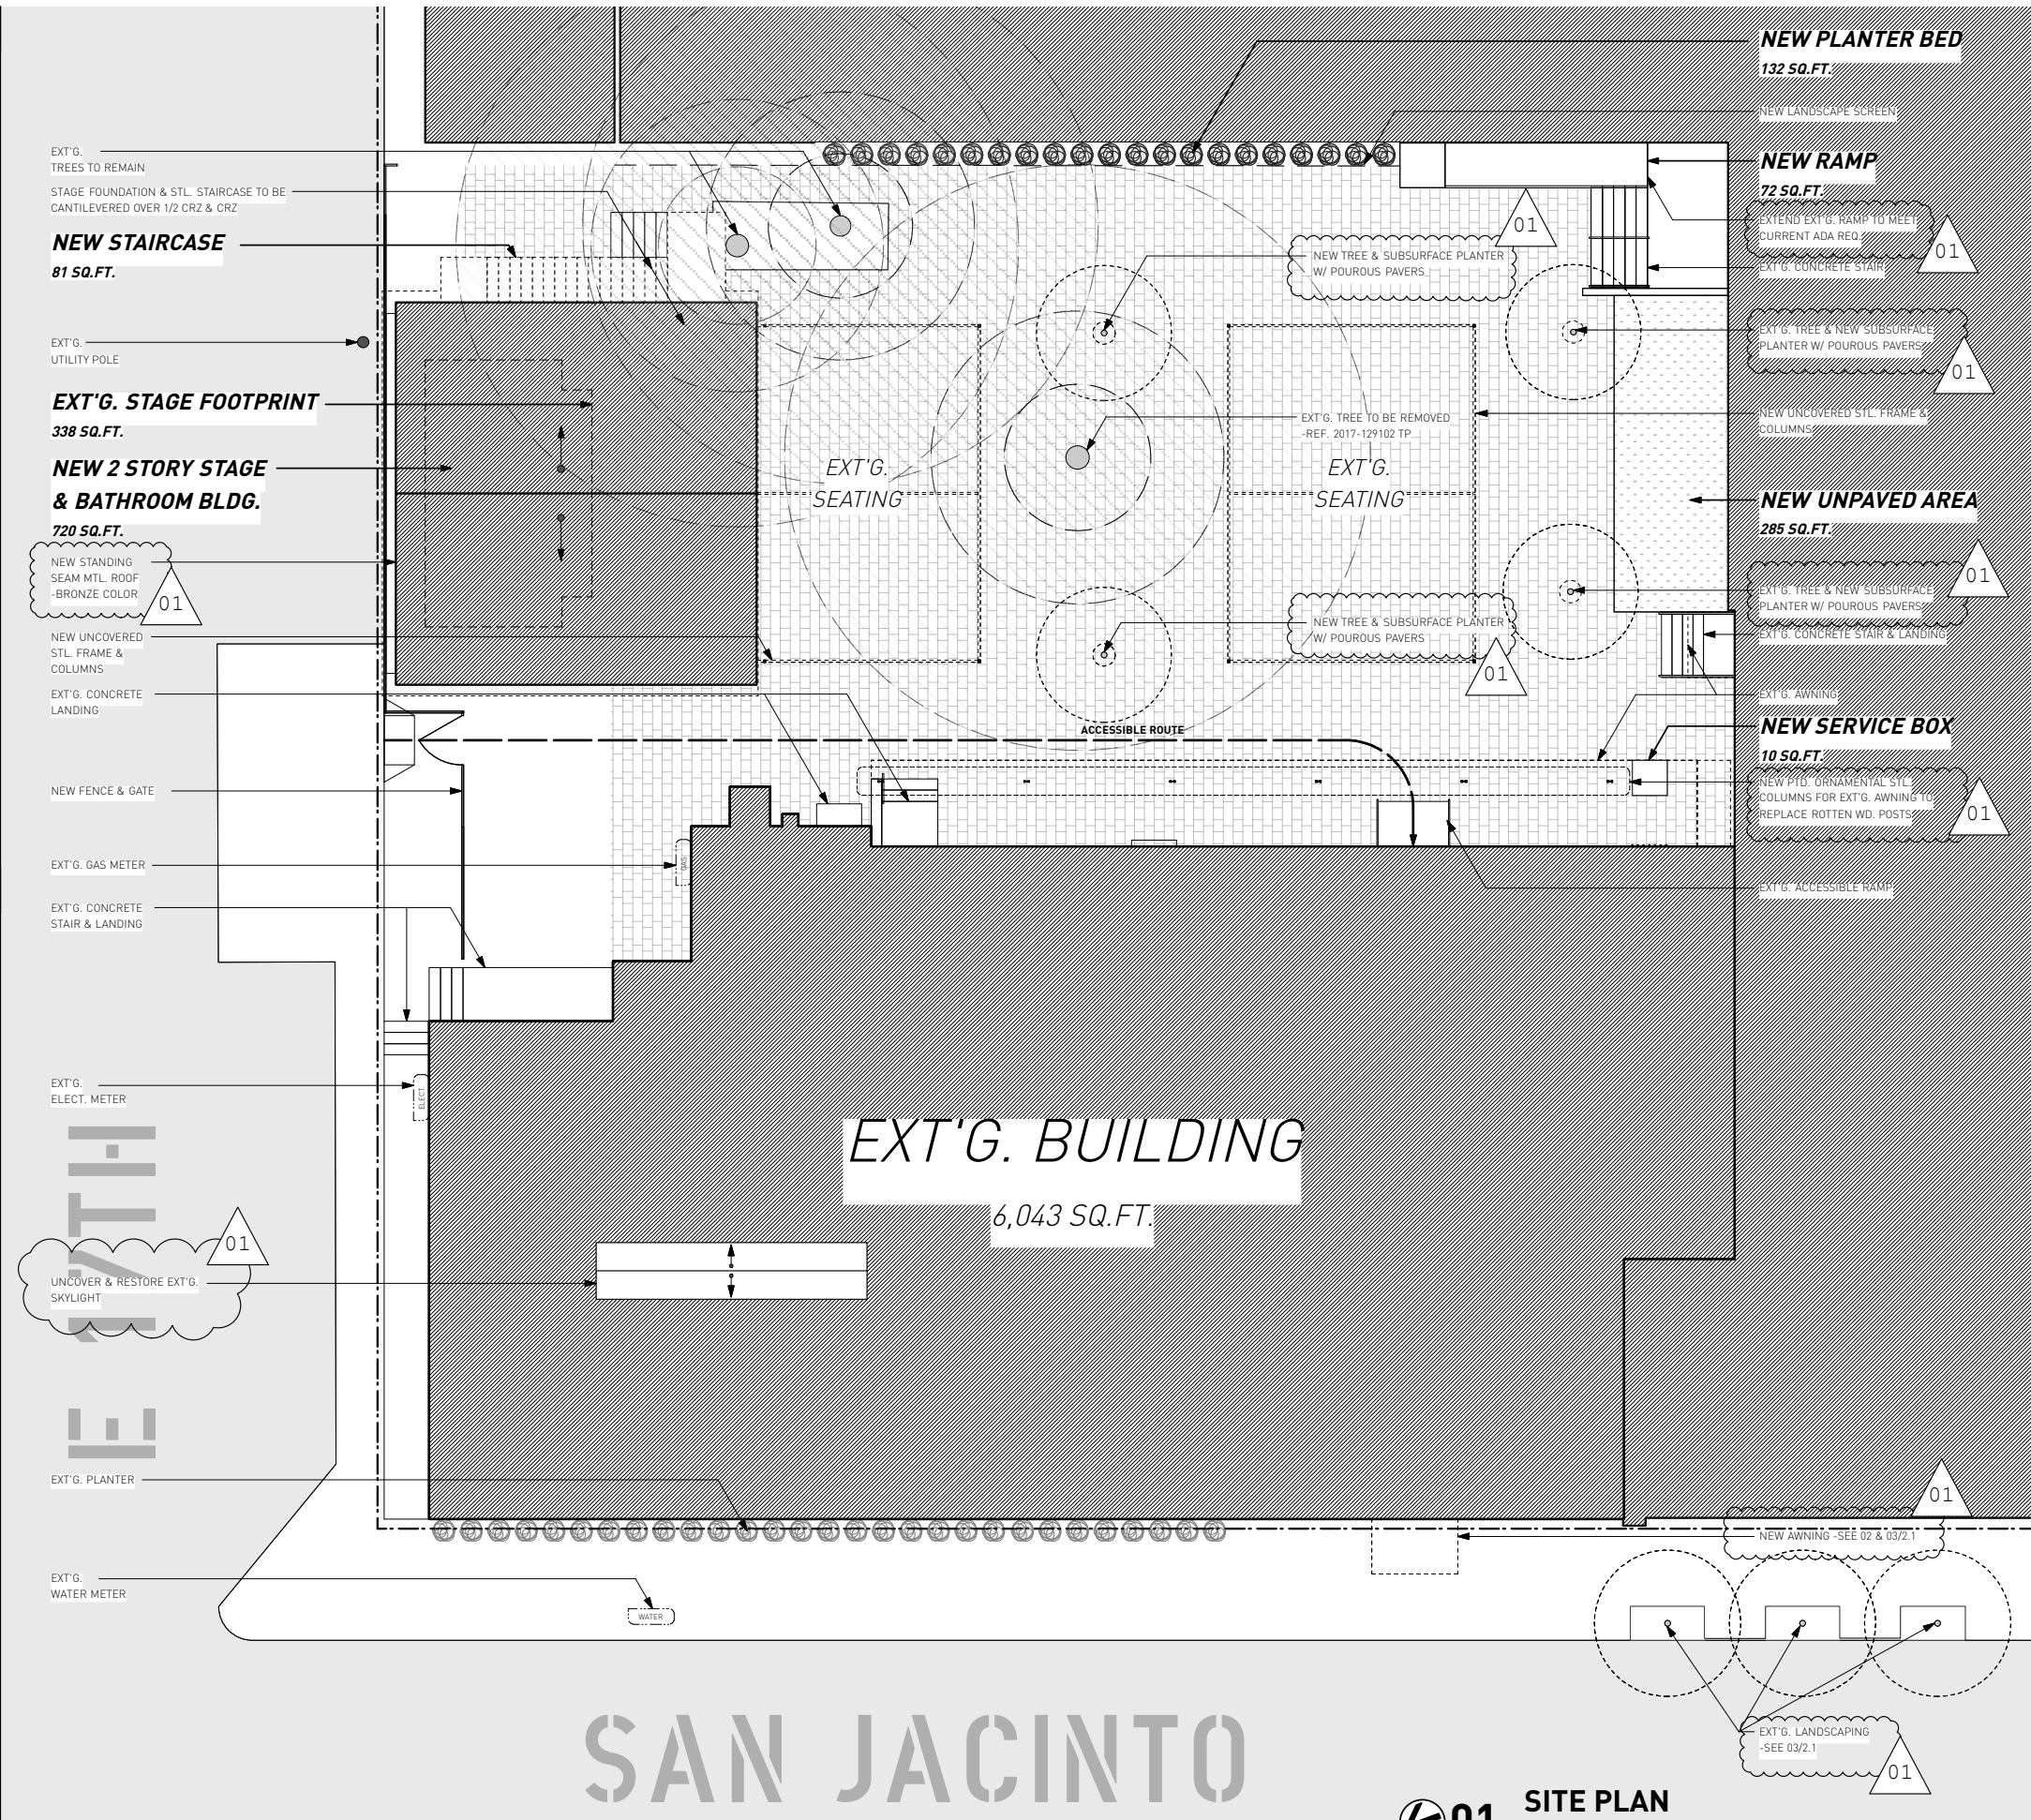

NORTH
ARROW
STUDIO

NORTHARROWSTUDIO.COM
INFO@NORTHARROWSTUDIO.COM
512.956.0644

SEAL

PROJECT

SCHOLZ
BEER
GARTEN

1607 SAN JACINTO BLVD.
AUSTIN, TX 78701

REVISIONS

01 HLC REVISION 2017-11-21

SET ISSUED

TITLE OF SHEET

SITE PLAN

NUMBER OF SHEET

1.0

CAUTION


DO NOT SCALE DRAWINGS

THESE DRAWINGS ARE THE
PROPERTY OF THE
DESIGNER & MAY ONLY BE
USED IN CONJUNCTION
WITH THIS PROJECT

01

SITE PLAN

1/8" = 1'-0"

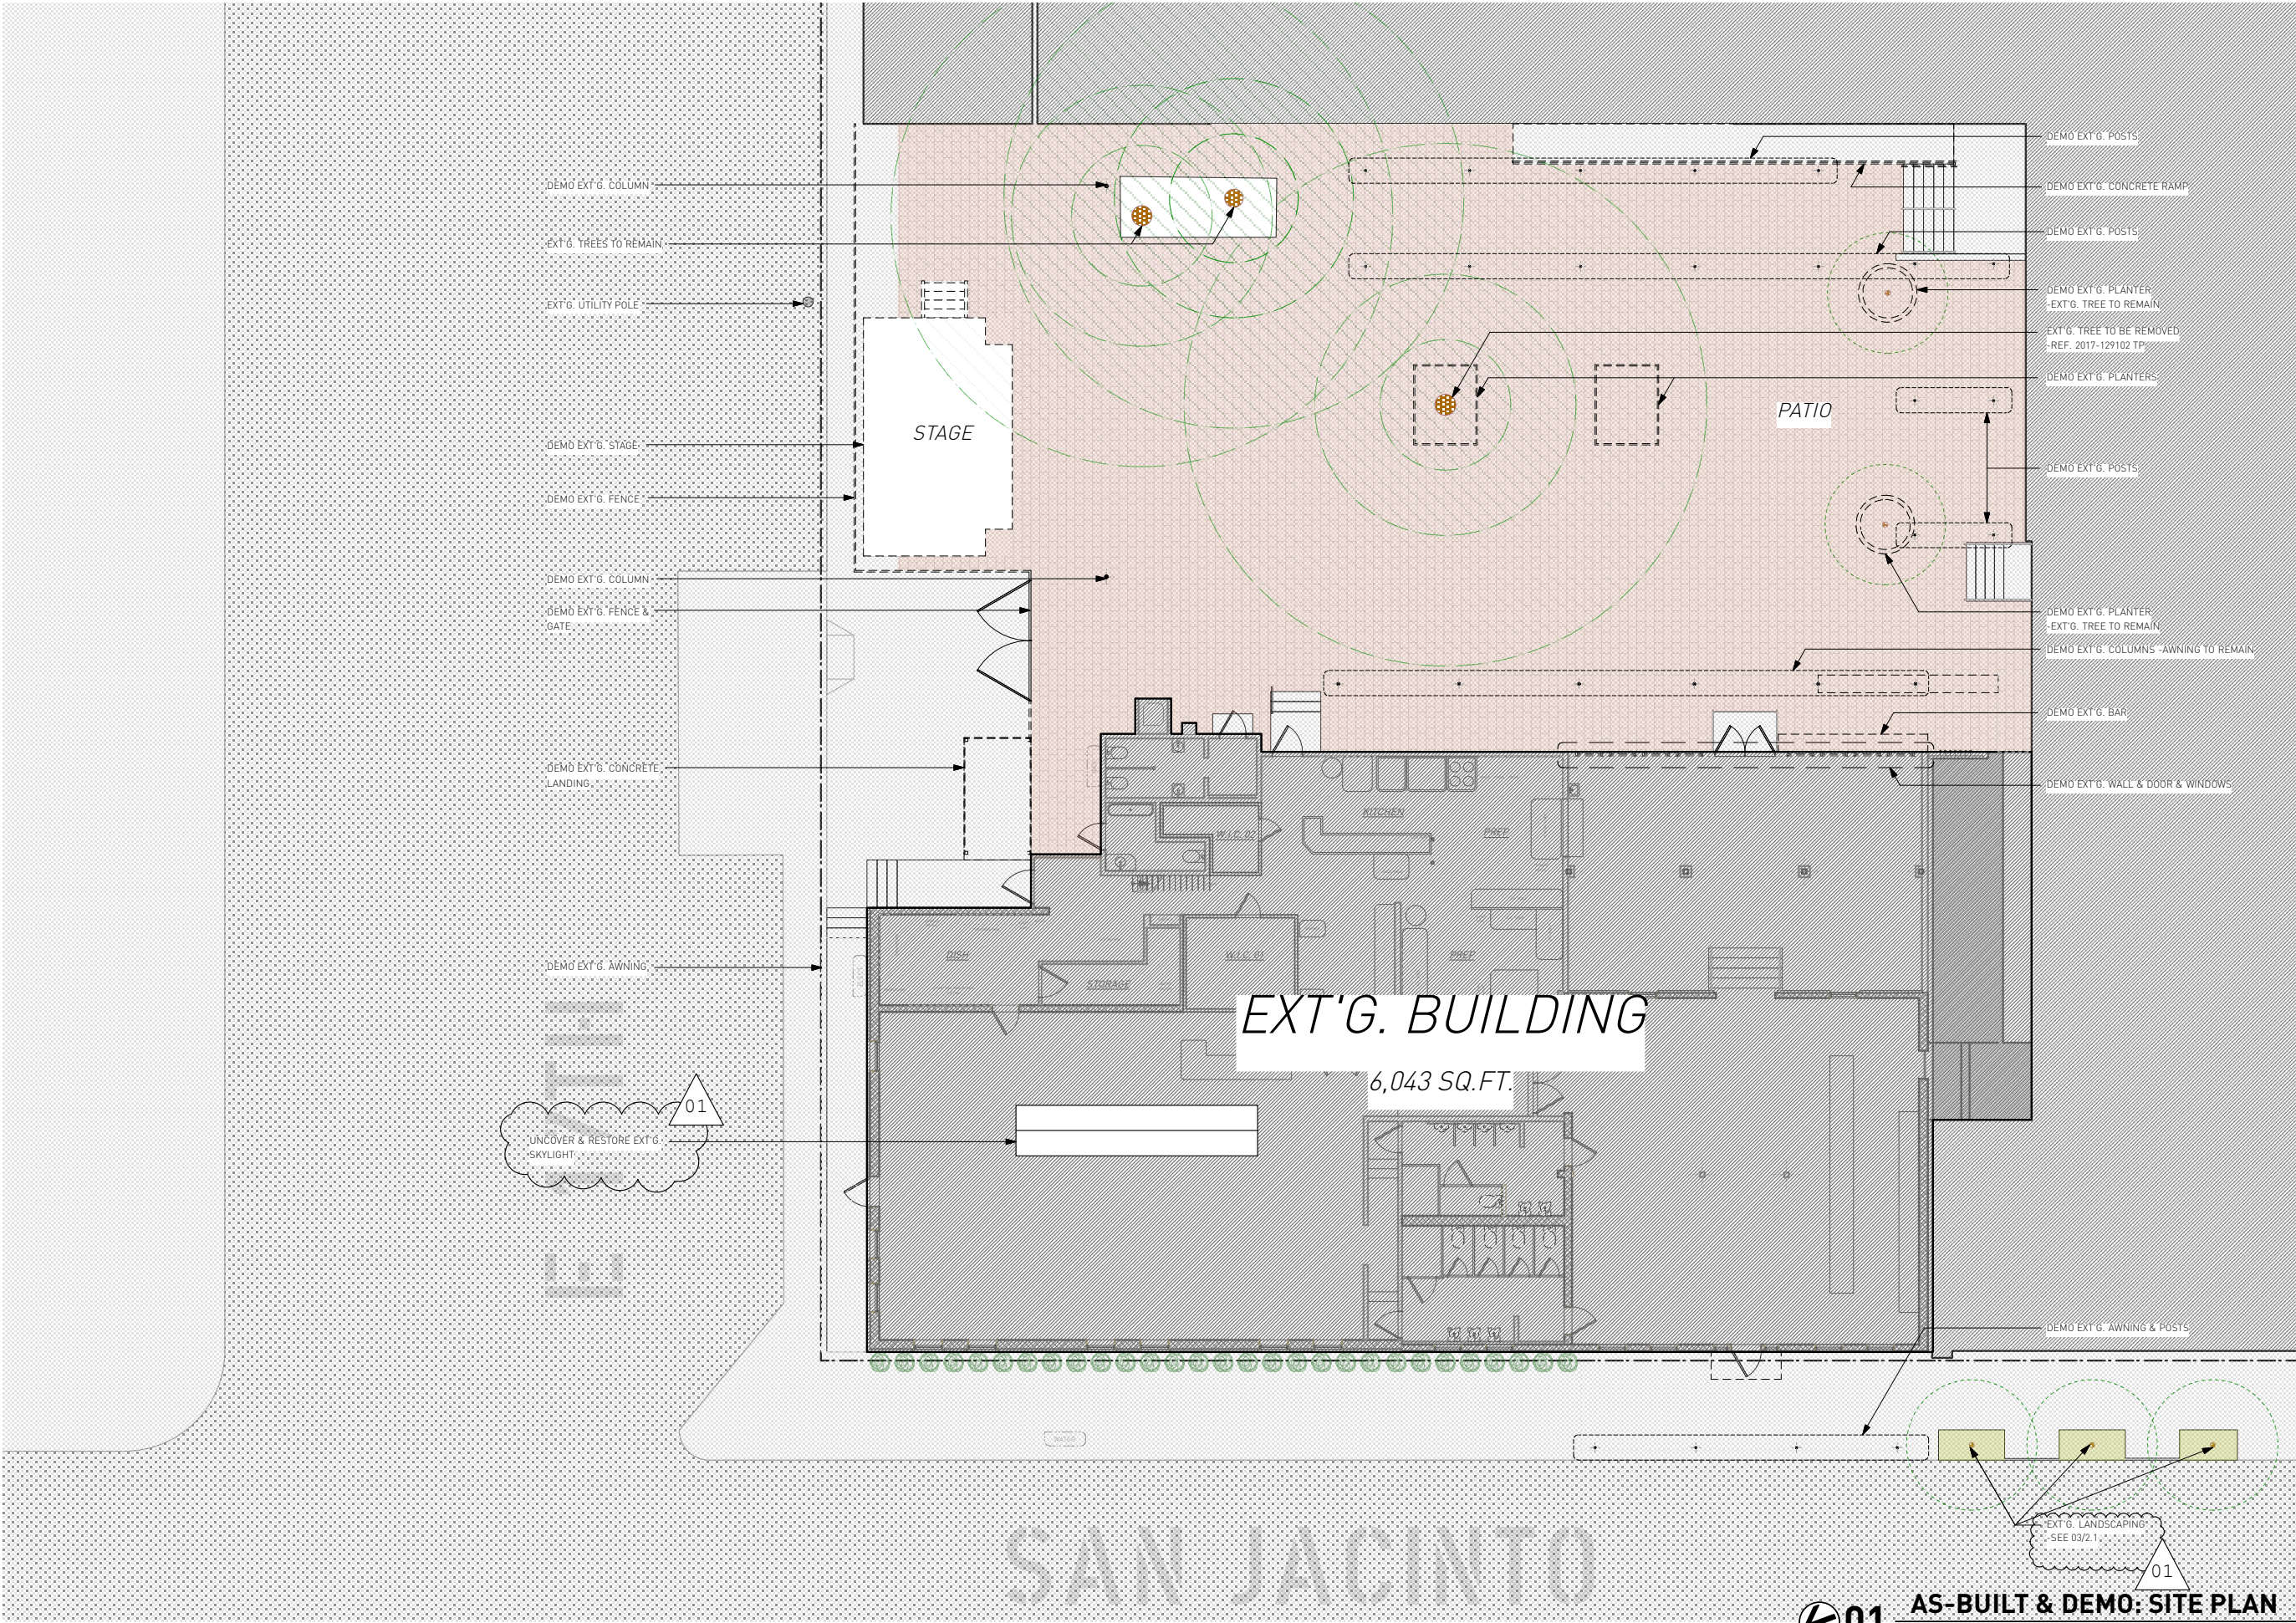

NORTH
ARROW
STUDIO

NORTHARROWSTUDIO.COM
INFO@NORTHARROWSTUDIO.COM
512.956.0644

SEAL

PROJECT

**SCHOLZ
BEER
GARDEN**

1607 SAN JACINTO BLVD.
AUSTIN, TX 78701

REVISIONS

01 HLC REVISION 2017-11-21

SET ISSUED

TITLE OF SHEET

**AS-BUILT &
DEMO: SITE
PLAN**

NUMBER OF SHEET

1.1

CAUTION


DO NOT SCALE DRAWINGS

THESE DRAWINGS ARE THE
PROPERTY OF THE
DESIGNER & MAY ONLY BE
USED IN CONJUNCTION
WITH THIS PROJECT

01

AS-BUILT & DEMO: SITE PLAN

1/8" = 1'-0"

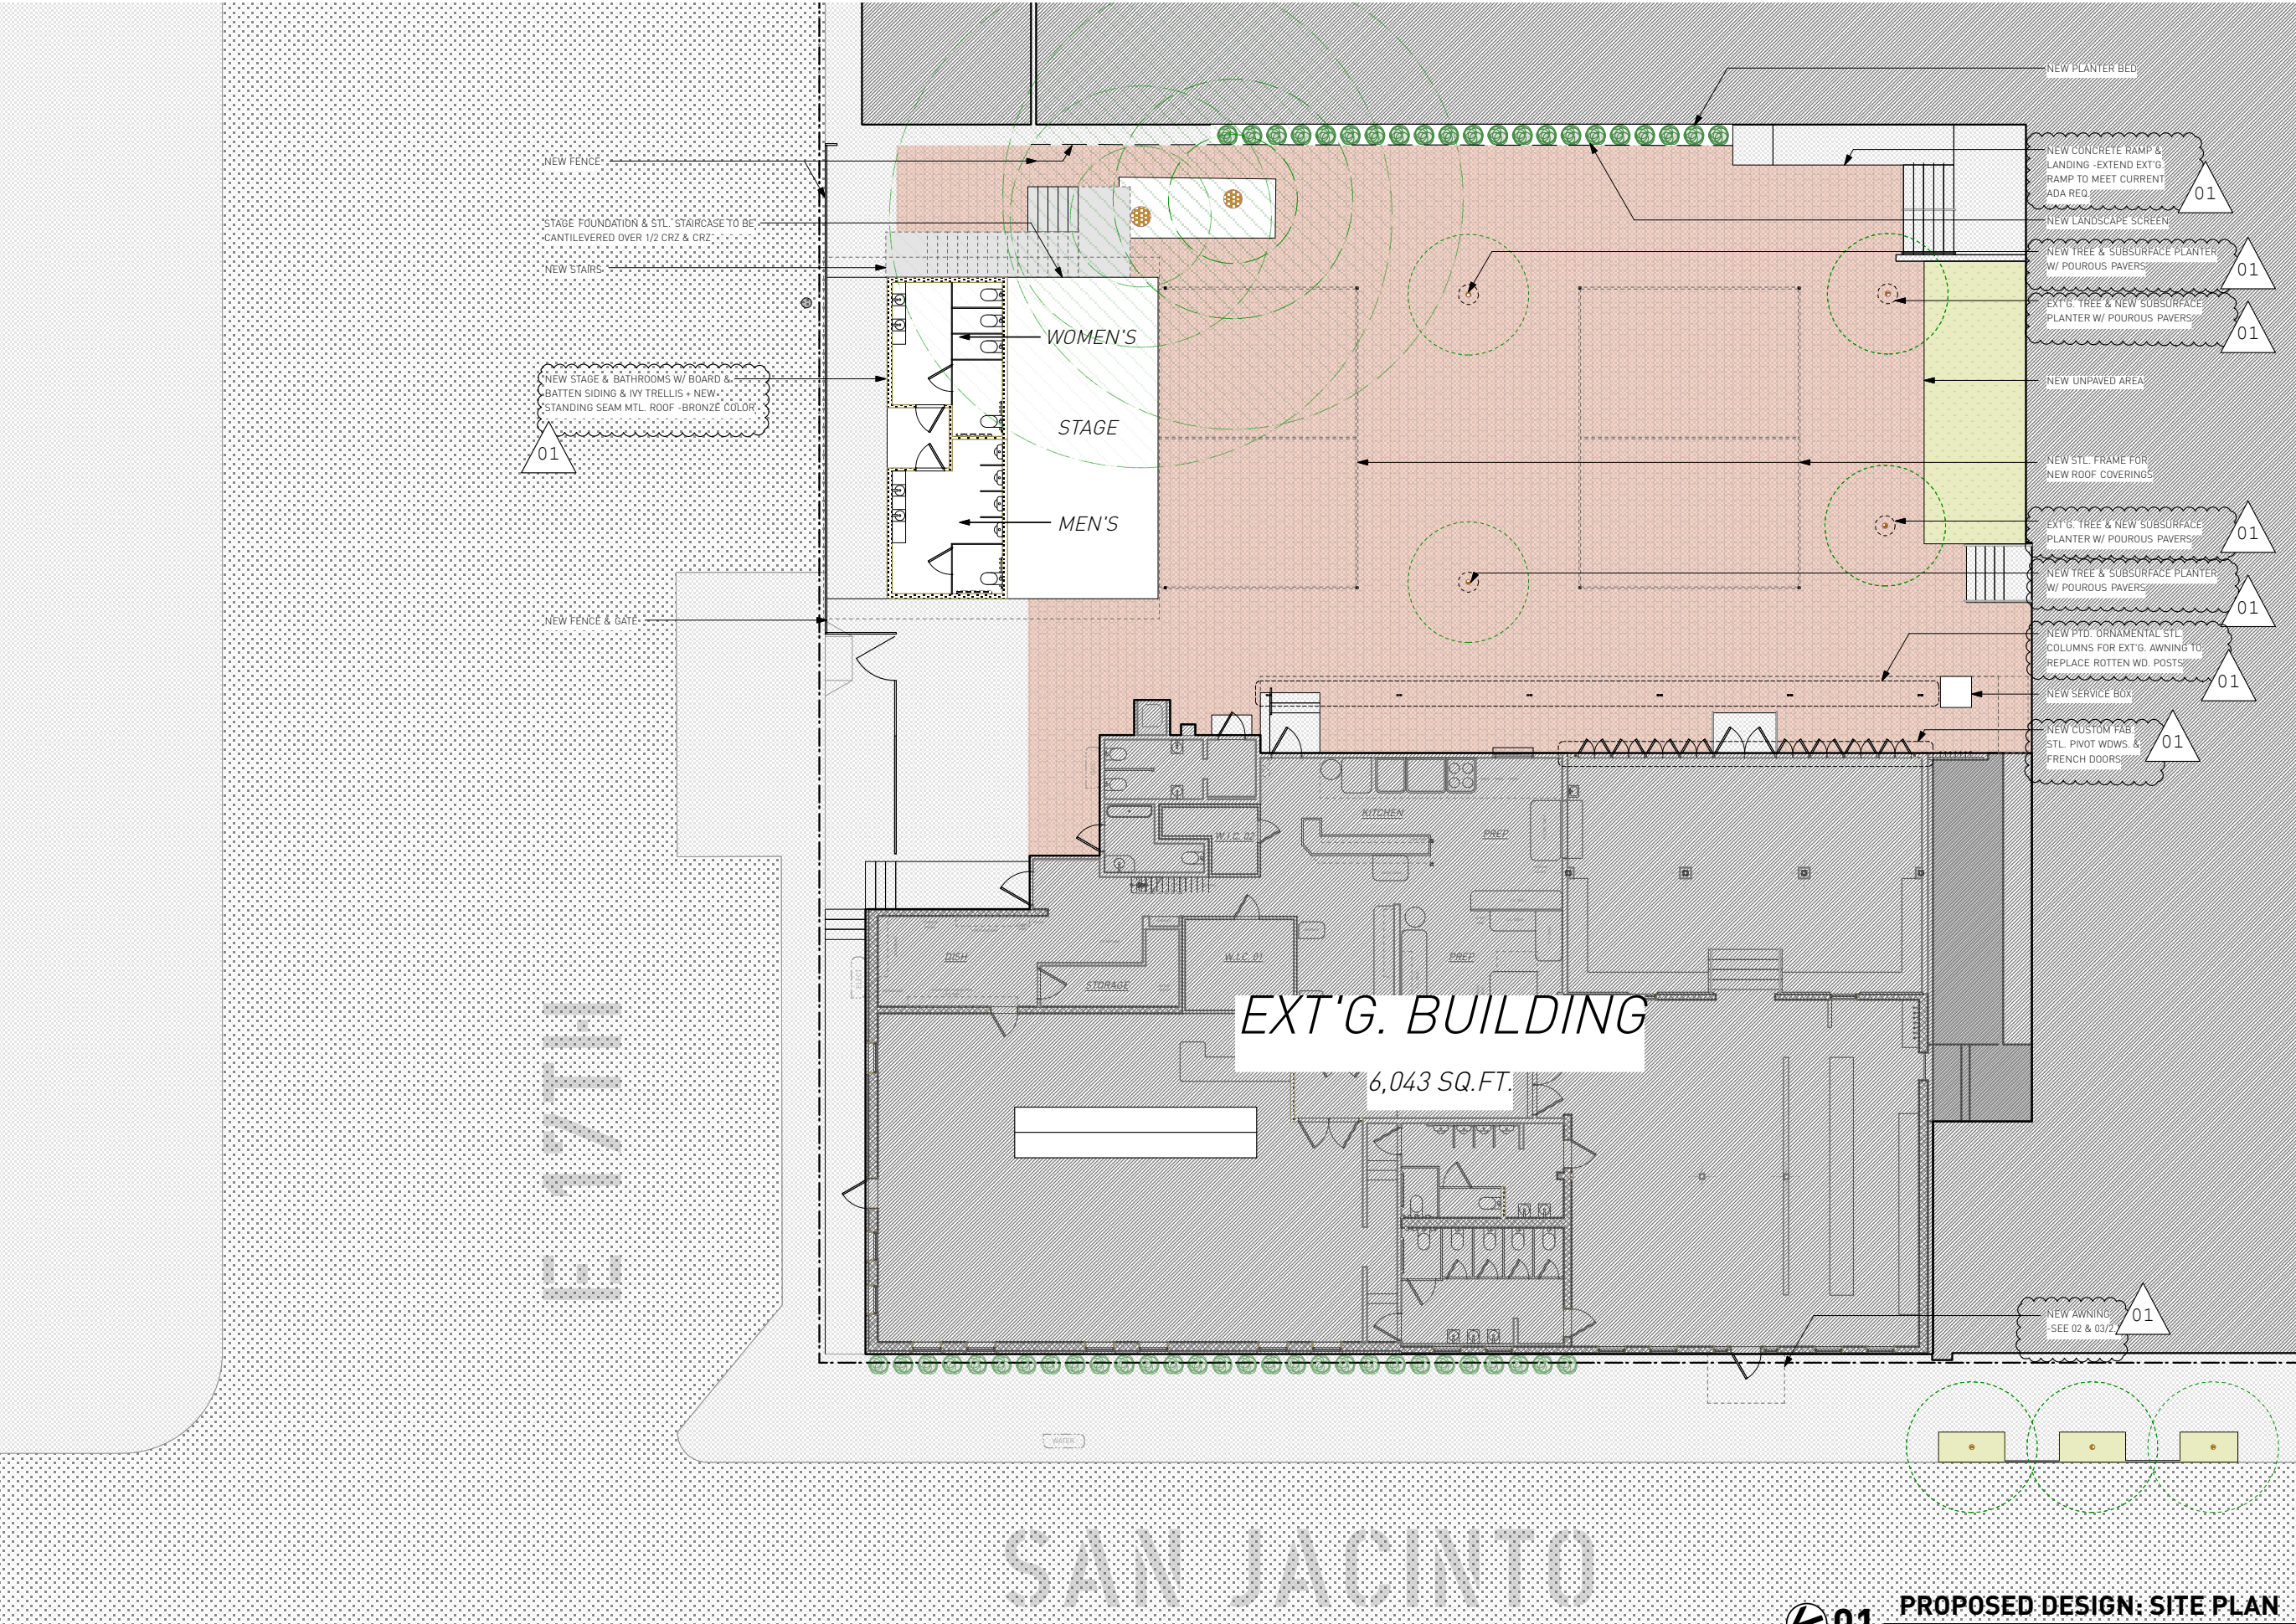

NORTH
ARROW
STUDIO

NORTHARROWSTUDIO.COM
INFO@NORTHARROWSTUDIO.COM
512.956.0644

SEAL

PROJECT

**SCHOLZ
BEER
GARDEN**

1607 SAN JACINTO BLVD.
AUSTIN, TX 78701

REVISIONS

01 HLC REVISION 2017-11-21

SET ISSUED

TITLE OF SHEET

**PROPOSED
DESIGN: SITE
PLAN**

NUMBER OF SHEET

1.2

CAUTION

DO NOT SCALE DRAWINGS

THESE DRAWINGS ARE THE
PROPERTY OF THE
DESIGNER & MAY ONLY BE
USED IN CONJUNCTION
WITH THIS PROJECT



01 EXT'G. SAN JACINTO AWNING: 1965
1/2" = 1'-0"



02 PROPOSED SAN JACINTO AWNING: 2017
1/2" = 1'-0"



03 PROPOSED SAN JACINTO AWNING: 2017
3/8" = 1'-0"

NORTH
ARROW
STUDIO

NORTHARROWSTUDIO.COM
INFO@NORTHARROWSTUDIO.COM
512.956.0644

SEAL

PROJECT

SCHOLZ
BEER
GARTEN

1607 SAN JACINTO BLVD.
AUSTIN, TX 78701

REVISIONS

01 HLC REVISION 2017-11-21

SET ISSUED

TITLE OF SHEET

PROPOSED
AWNING
DESIGN

NUMBER OF SHEET

2.1

CAUTION

DO NOT SCALE DRAWINGS

THESE DRAWINGS ARE THE
PROPERTY OF THE
DESIGNER & MAY ONLY BE
USED IN CONJUNCTION
WITH THIS PROJECT



01 **PROPOSED STAGE DESIGN: E 17TH ELEVATION**
3/8" = 1'-0"

01

NORTH
ARROW
STUDIO

NORTHARROWSTUDIO.COM
INFO@NORTHARROWSTUDIO.COM
512.956.0644

SEAL

PROJECT

**SCHOLZ
BEER
GARTEN**

1607 SAN JACINTO BLVD.
AUSTIN, TX 78701

REVISIONS

01 HLC REVISION 2017-11-21

SET ISSUED

TITLE OF SHEET

**PROPOSED
STAGE DESIGN:
E 17TH
ELEVATION**


NUMBER OF SHEET

2.2

CAUTION

DO NOT SCALE DRAWINGS

THESE DRAWINGS ARE THE
PROPERTY OF THE
DESIGNER & MAY ONLY BE
USED IN CONJUNCTION
WITH THIS PROJECT

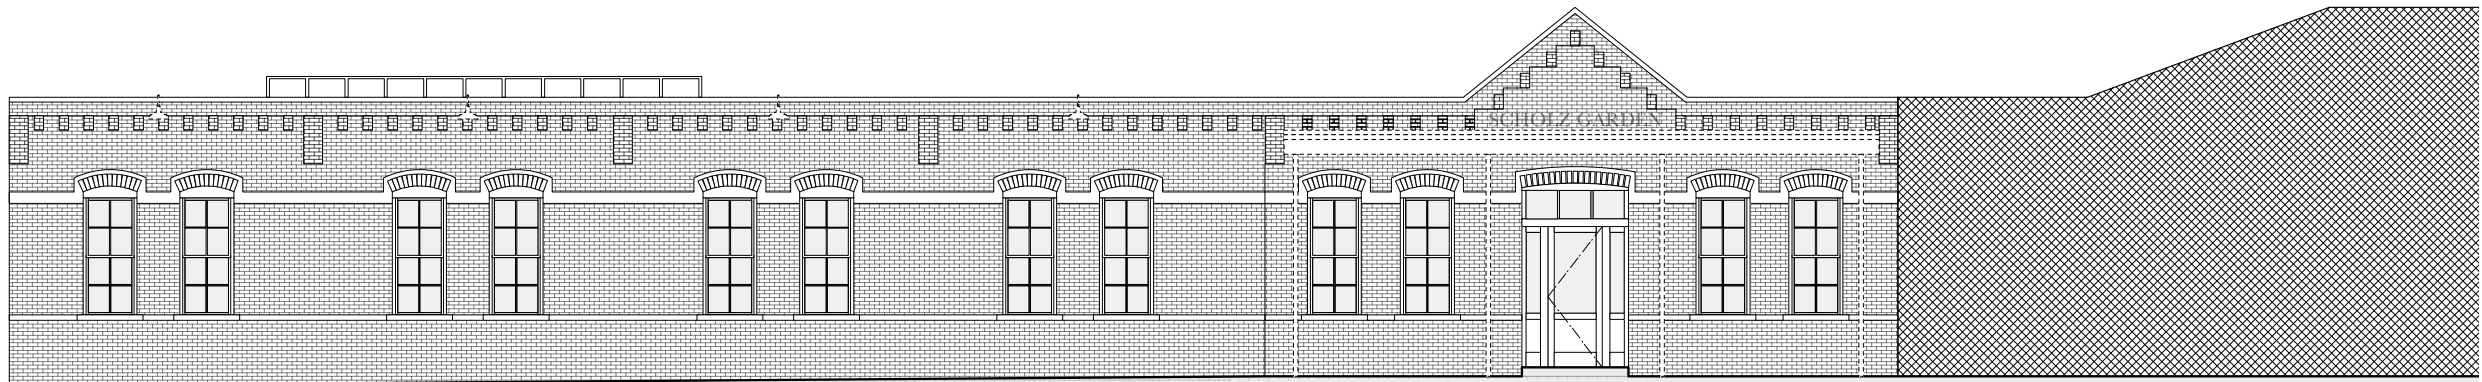

01 WEST ELEVATION: AS-BUILT & DEMO
3/16" = 1'-0"

ALL EXT'G. WINDOWS TO REMAIN UNCHANGED
UNCOVER & RESTORE EXT'G. SKYLIGHT
ALL EXT'G. BRICK TO REMAIN UNCHANGED


NEW AWNING -SEE 02 & 03/2.1



02 WEST ELEVATION: PROPOSED DESIGN
3/16" = 1'-0"



03 WEST ELEVATION: EXT'G. PHOTOGRAPH
3/16" = 1'-0"

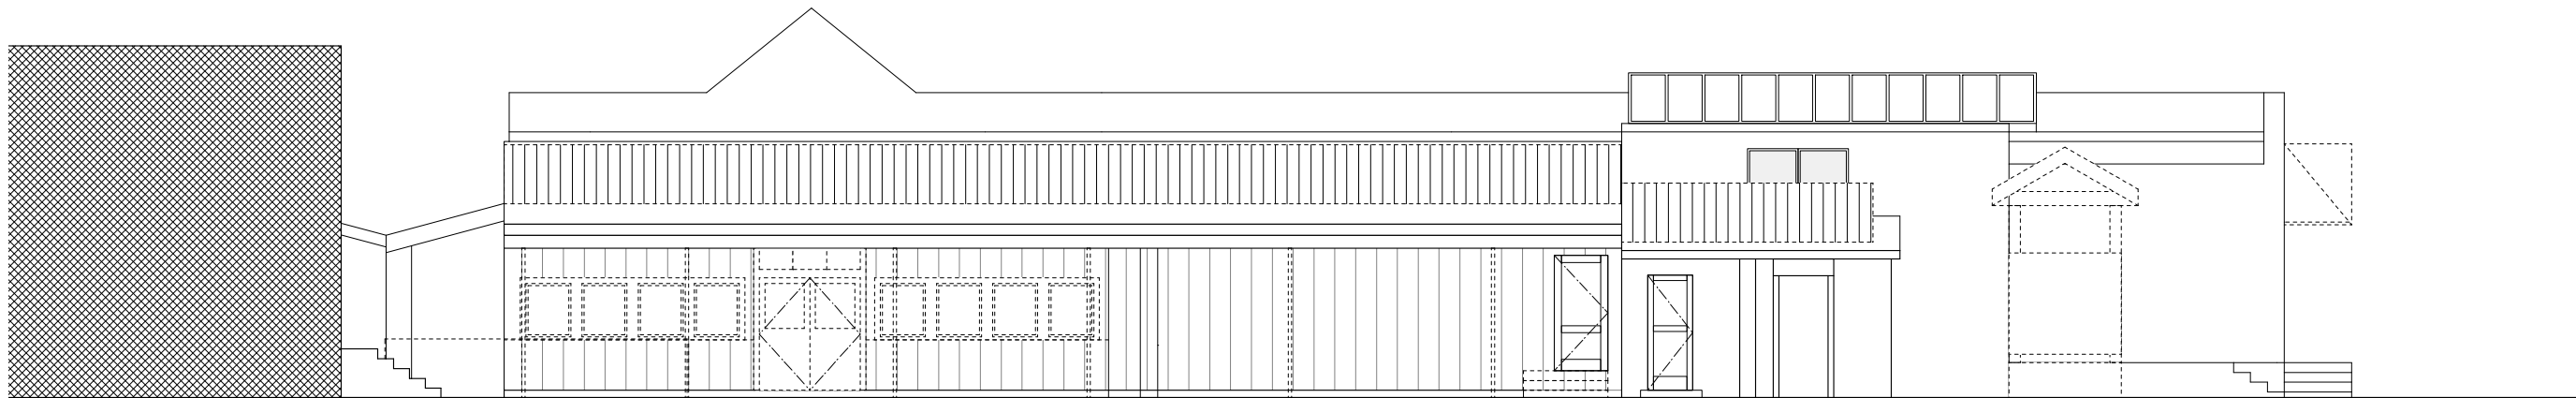

01 BOARD & BATTEN SIDING TO BE REPAINTED
REPLACE EXT'G. WD. PICKET MECH. EQUIP.
SCREEN W/ NEW PTD. LIGHT GAUGE STL. SCREEN

01 UNCOVER & RESTORE EXT'G. SKYLIGHT
EXT'G. WDWS. TO REMAIN UNCHANGED

01 EAST ELEVATION: AS-BUILT & DEMO
3/16" = 1'-0"


01 NEW CUSTOM FAB. STL. PIVOT
WDWS. & FRENCH DOORS

NEW PTD. ORNAMENTAL STL.
COLUMNS FOR EXT'G. AWNING
TO REPLACE ROTTEN WD.
POSTS


02 EAST ELEVATION: PROPOSED DESIGN
3/16" = 1'-0"



03 EAST ELEVATION: EXT'G. PHOTOGRAPH
3/16" = 1'-0"

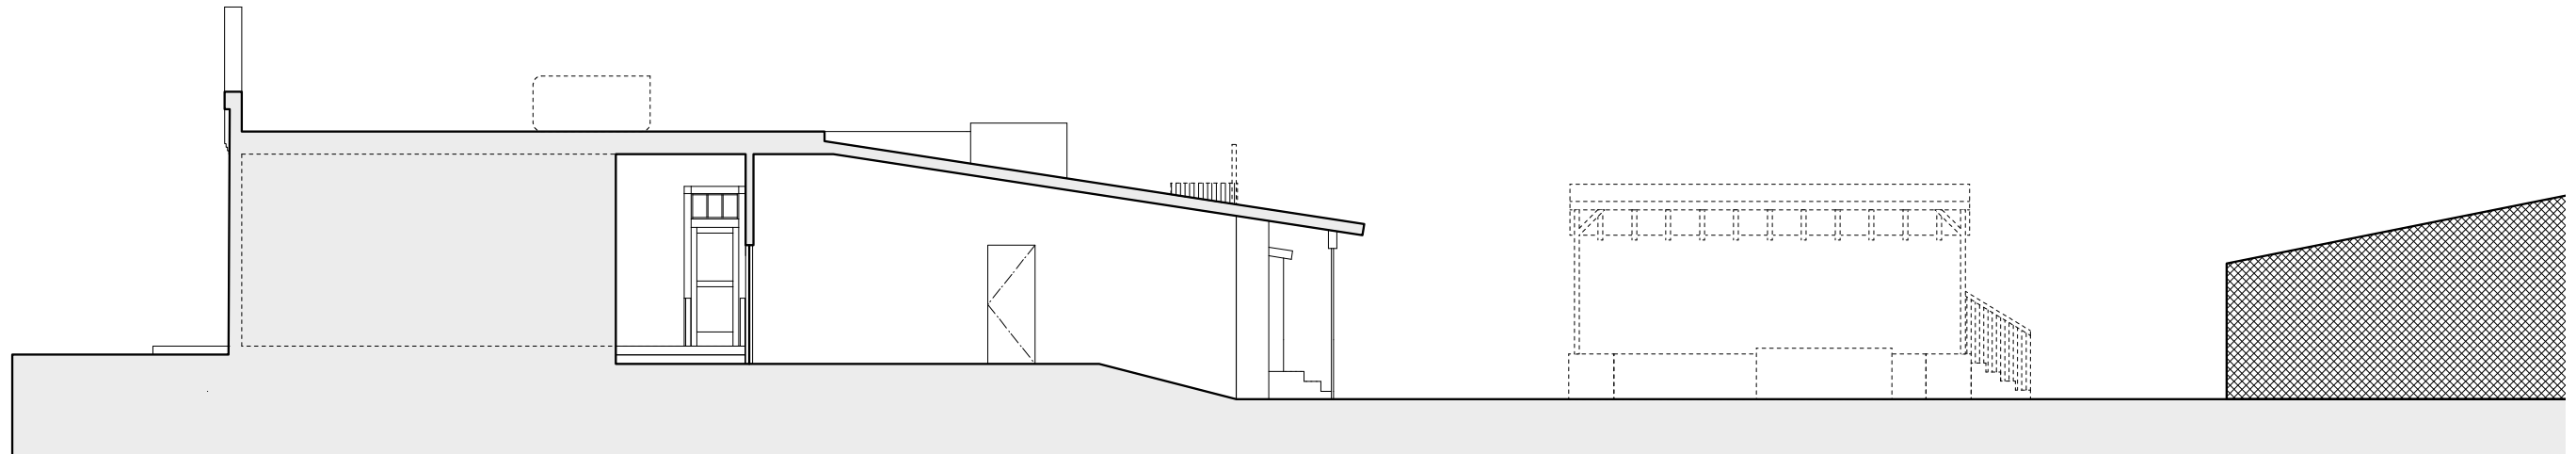

01 SOUTH ELEVATION: AS-BUILT & DEMO
3/16" = 1'-0"

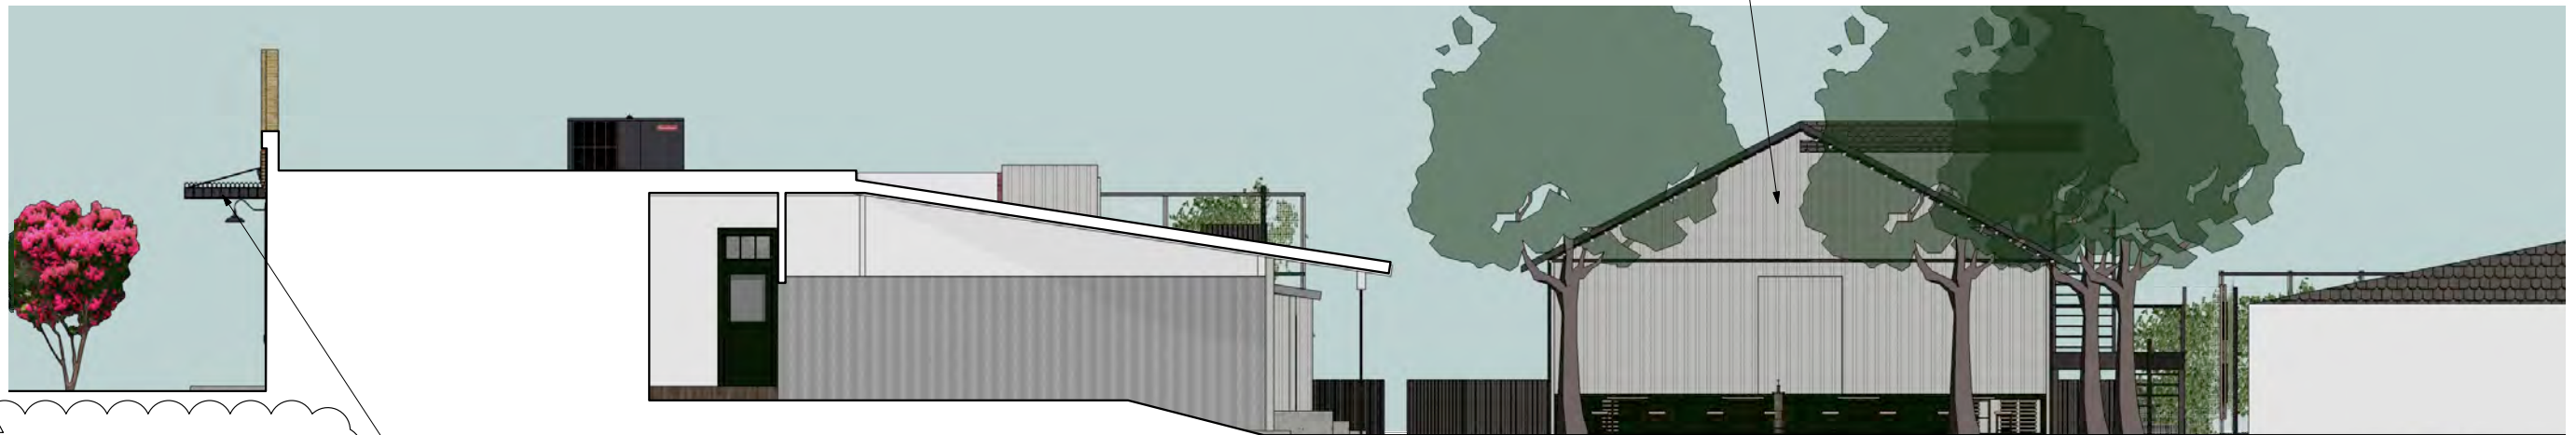


02 SOUTH ELEVATION: PROPOSED DESIGN
3/16" = 1'-0"



03 SOUTH ELEVATION: EXT'G. PHOTOGRAPH
3/16" = 1'-0"

01 NEW STAGE & BATHROOMS W/ BOARD & BATTEN SIDING & IVY
TRELLIS + NEW STANDING SEAM MTL. ROOF -BRONZE COLOR

01 NEW AWNING -SEE 02 & 03/2.1

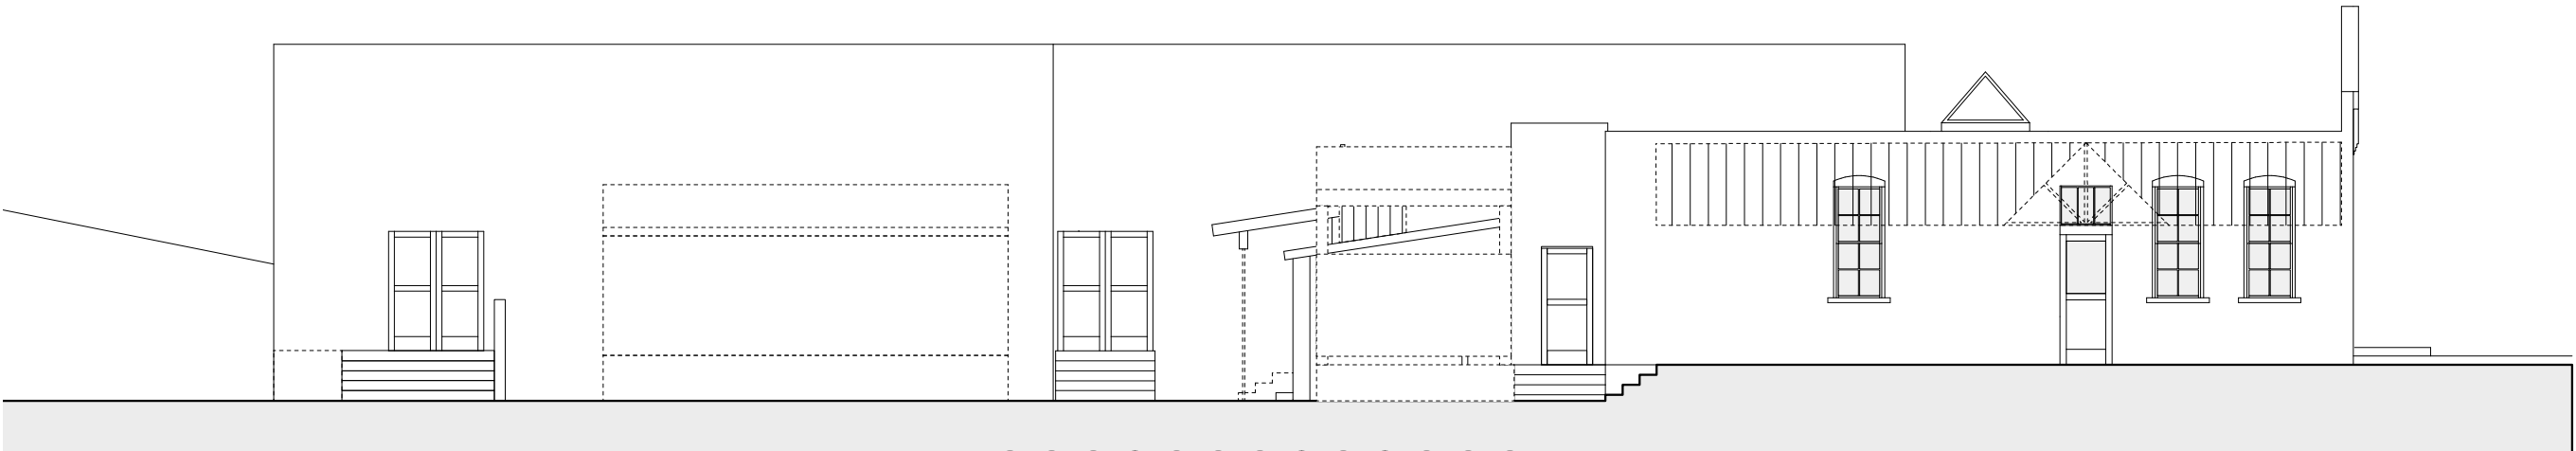

01 NEW STAGE & BATHROOMS W/ BOARD & BATTEN SIDING & IVY TRELLIS + NEW STANDING SEAM MTL. ROOF -BRONZE COLOR

01 UNCOVER & RESTORE EXT'G. SKYLIGHT
ALL EXT'G. BRICK TO REMAIN UNCHANGED
ALL EXT'G. WINDOWS TO REMAIN UNCHANGED

01 NORTH ELEVATION: AS-BUILT & DEMO
3/16" = 1'-0"
01 NEW AWNING -SEE 02 & 03/2.1



02 NORTH ELEVATION: PROPOSED DESIGN
3/16" = 1'-0"



03 NORTH ELEVATION: EXT'G. PHOTOGRAPH
3/16" = 1'-0"

NORTH
ARROW
STUDIO

NORTHARROWSTUDIO.COM
INFO@NORTHARROWSTUDIO.COM
512.956.0644

SEAL

PROJECT
**SCHOLZ
BEER
GARTEN**
1607 SAN JACINTO BLVD.
AUSTIN, TX 78701

REVISIONS
01 HLC REVISION 2017-11-21

SET ISSUED

TITLE OF SHEET
**NORTH
ELEVATION**

NUMBER OF SHEET
2.6

CAUTION
DO NOT SCALE DRAWINGS
THESE DRAWINGS ARE THE
PROPERTY OF THE
DESIGNER & MAY ONLY BE
USED IN CONJUNCTION
WITH THIS PROJECT



01 **SAN JACINTO ELEVATION: 1866**
3/16" = 1'-0"



02 **PATIO: EARLY 1900's**
3/16" = 1'-0"



03 **SAN JACINTO ELEVATION: 1960's**
3/16" = 1'-0"



02 **SAN JACINTO ELEVATION: 1965**
3/16" = 1'-0"



05 **SAN JACINTO ELEVATION: 1965**
3/16" = 1'-0"

NORTH
ARROW
STUDIO

NORTHARROWSTUDIO.COM
INFO@NORTHARROWSTUDIO.COM
512.956.0644

SEAL

PROJECT

SCHOLZ
BEER
GARTEN

1607 SAN JACINTO BLVD.
AUSTIN, TX 78701

REVISIONS

01 HLC REVISION 2017-11-21

SET ISSUED

TITLE OF SHEET

HISTORICAL
PHOTOGRAPHS


NUMBER OF SHEET

3.1


CAUTION

DO NOT SCALE DRAWINGS


THESE DRAWINGS ARE THE
PROPERTY OF THE
DESIGNER & MAY ONLY BE
USED IN CONJUNCTION
WITH THIS PROJECT

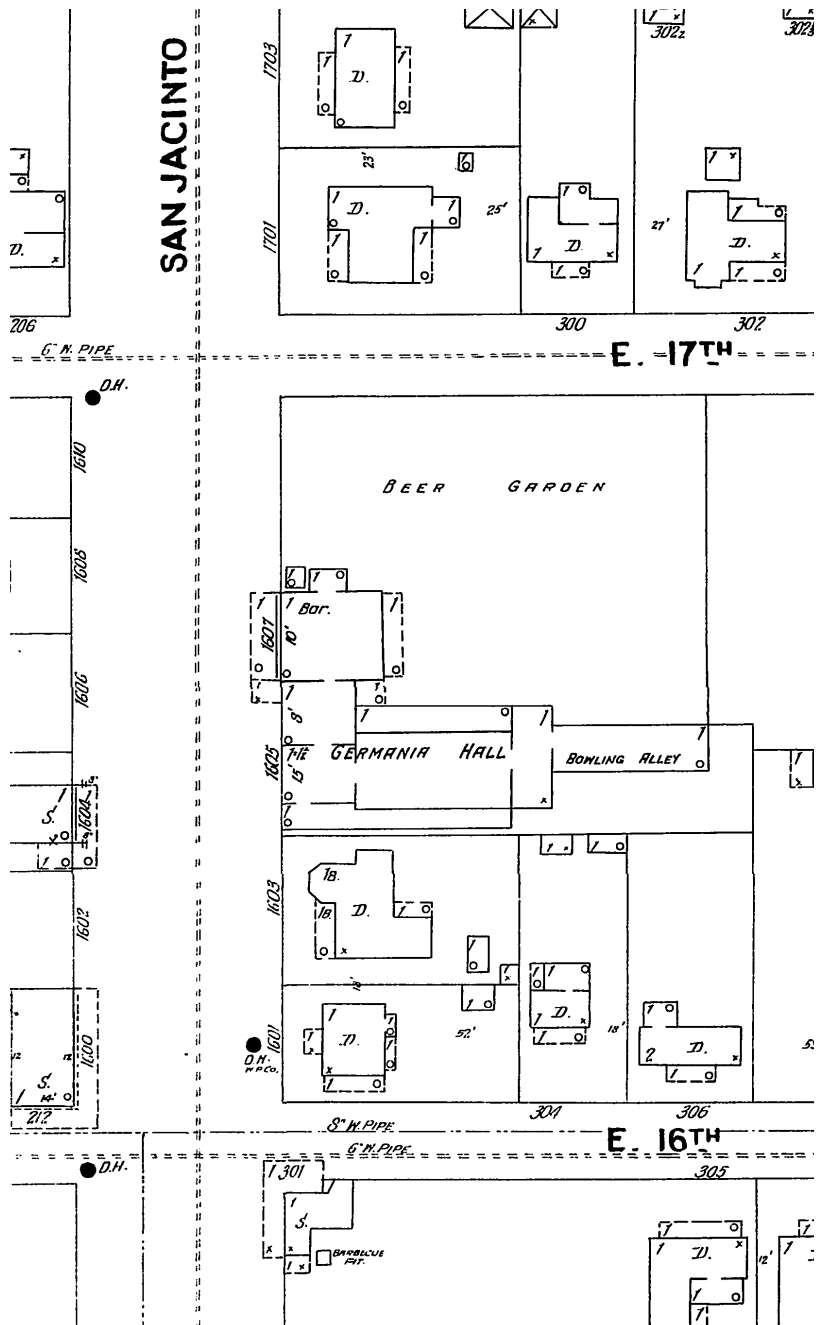

01 SANBORN MAP: 1900
3/8" = 1'-0"

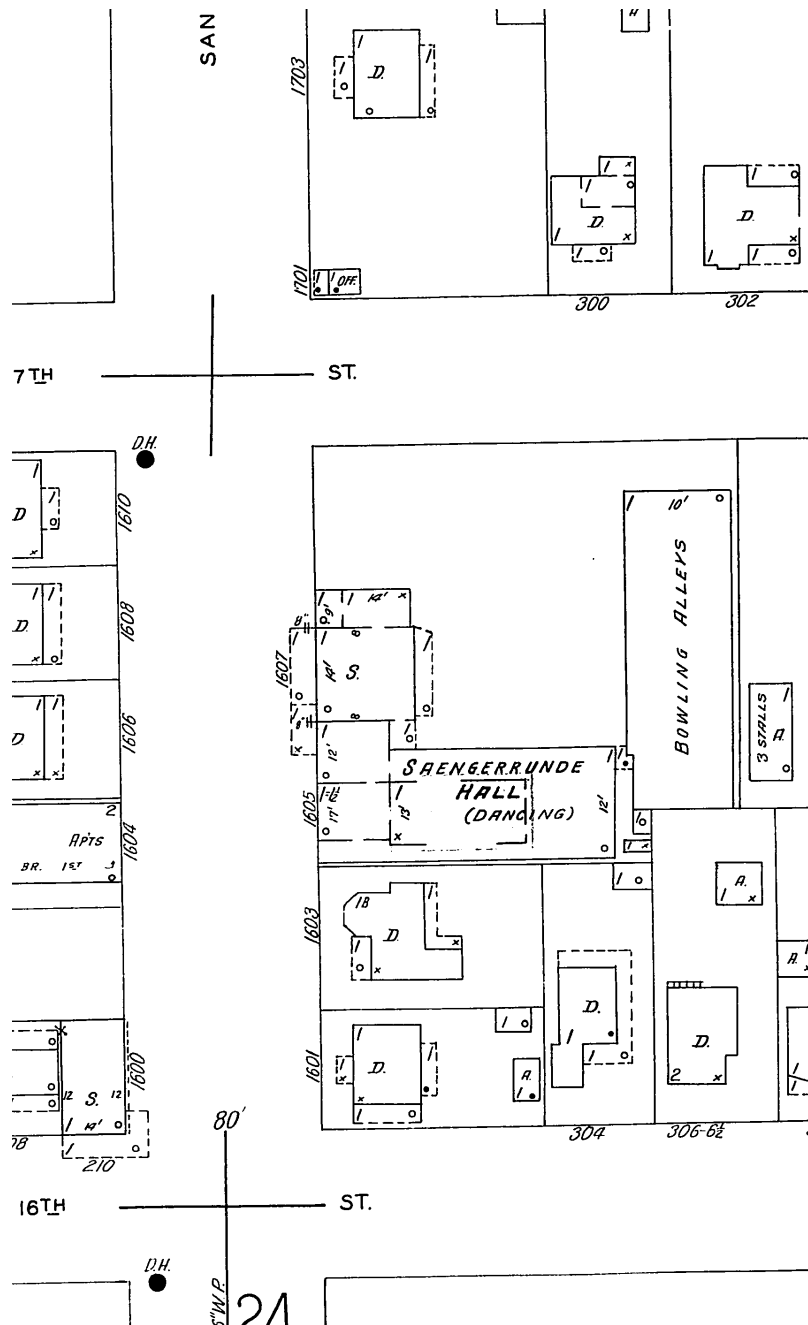

02 SANBORN MAP: 1935
3/8" = 1'-0"

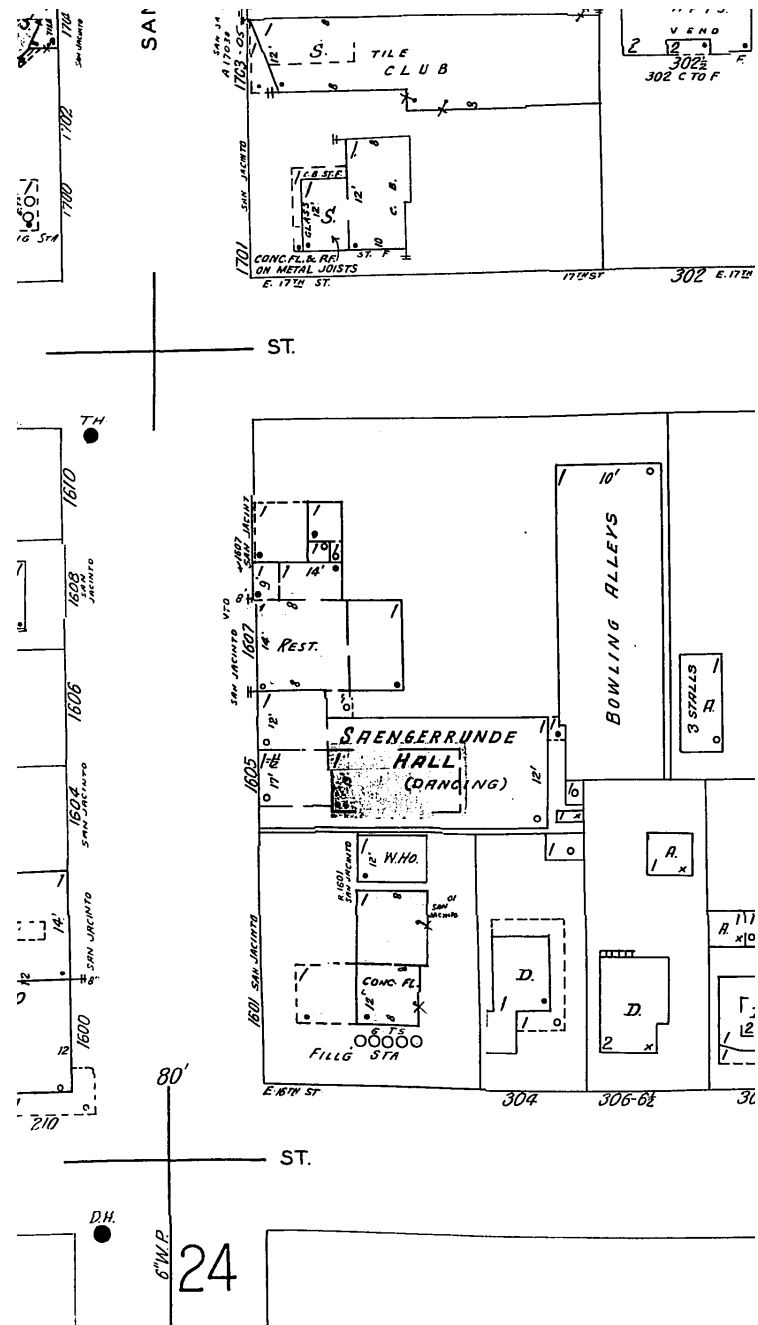

03 SANBORN MAP: 1961
3/8" = 1'-0"

NORTH
ARROW
STUDIO

NORTHARROWSTUDIO.COM

INFO@NORTHARROWSTUDIO.COM

512.956.0644

SEAL

PROJECT

SCHOLZ
BEER
GARTEN

1607 SAN JACINTO BLVD.
AUSTIN, TX 78701

REVISIONS

01

HLC REVISION 2017-11-21

SET ISSUED

TITLE OF SHEET

SANBORN
MAPS

NUMBER OF SHEET

3.2

CAUTION

DO NOT SCALE DRAWINGS

THESE DRAWINGS ARE THE
PROPERTY OF THE
DESIGNER & MAY ONLY BE
USED IN CONJUNCTION
WITH THIS PROJECT