

N:\Revit 2014\Mueller Observation Tower\ACAD\SURVEY 222010927EX1.dwg
2017/11/01 1:12 PM By: DDC

ORIGINAL SHEET - ANSI A

August, 2017
222010942



221 West Sixth Street, Suite 600
Austin, TX 78701
TBPE # F-6324 TBPLS # 10194230
www.stantec.com

Client/Project

Catellus
Mueller Control Tower
As-Built Survey

Figure No.


1.0

Title

As-built Survey


Basement

$\frac{3}{16}'' = 1'-0''$

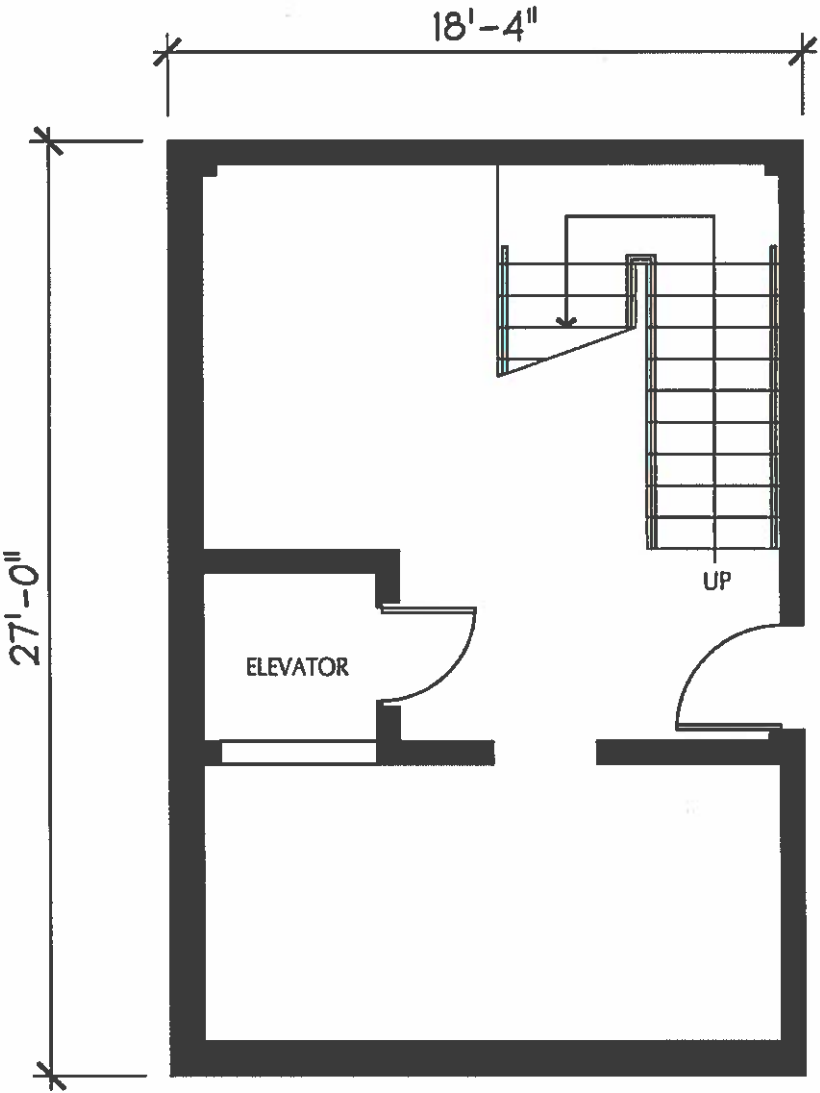


1st Floor

$\frac{3}{16}'' = 1'-0''$

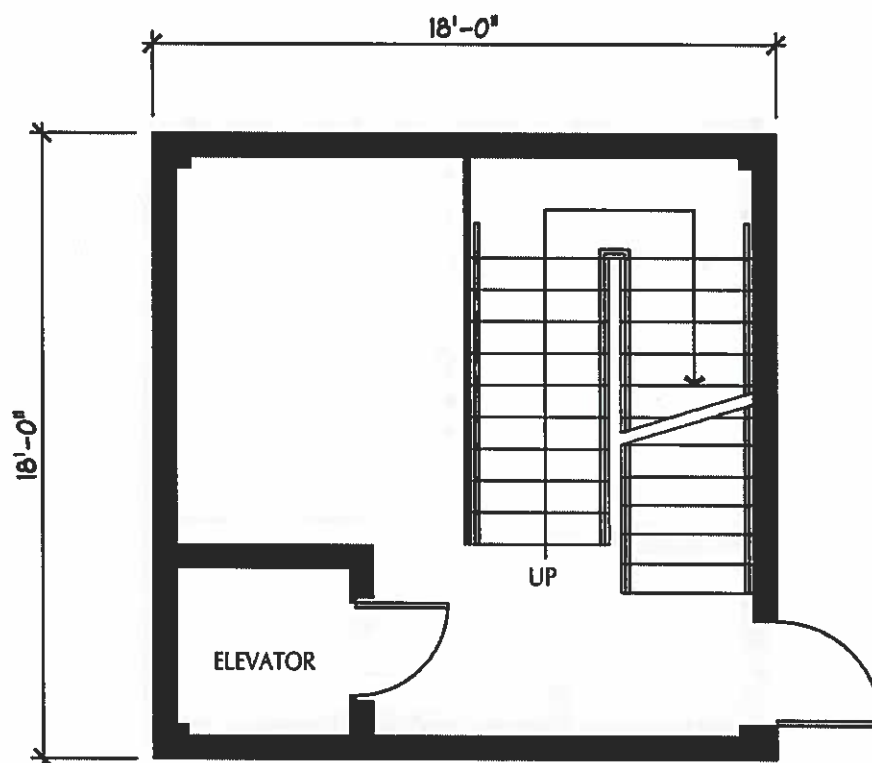


2nd Floor

$\frac{3}{16}'' = 1'-0''$

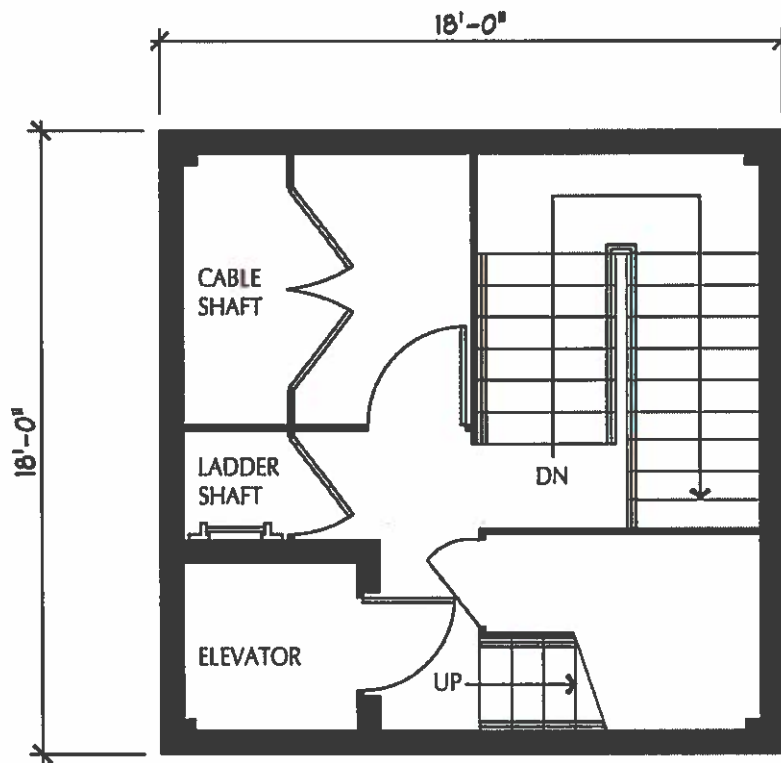


3rd Floor

$\frac{3}{16}'' = 1'-0''$

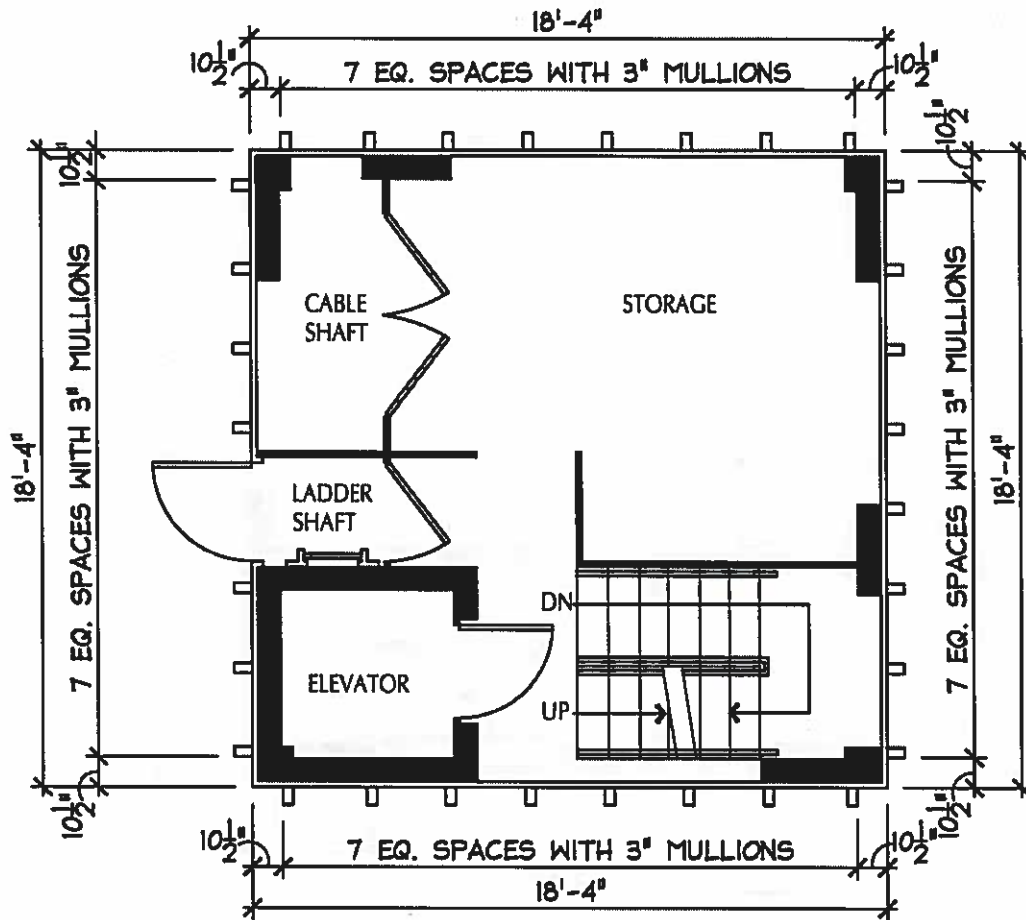


4th Floor

$\frac{3}{16}'' = 1'-0''$

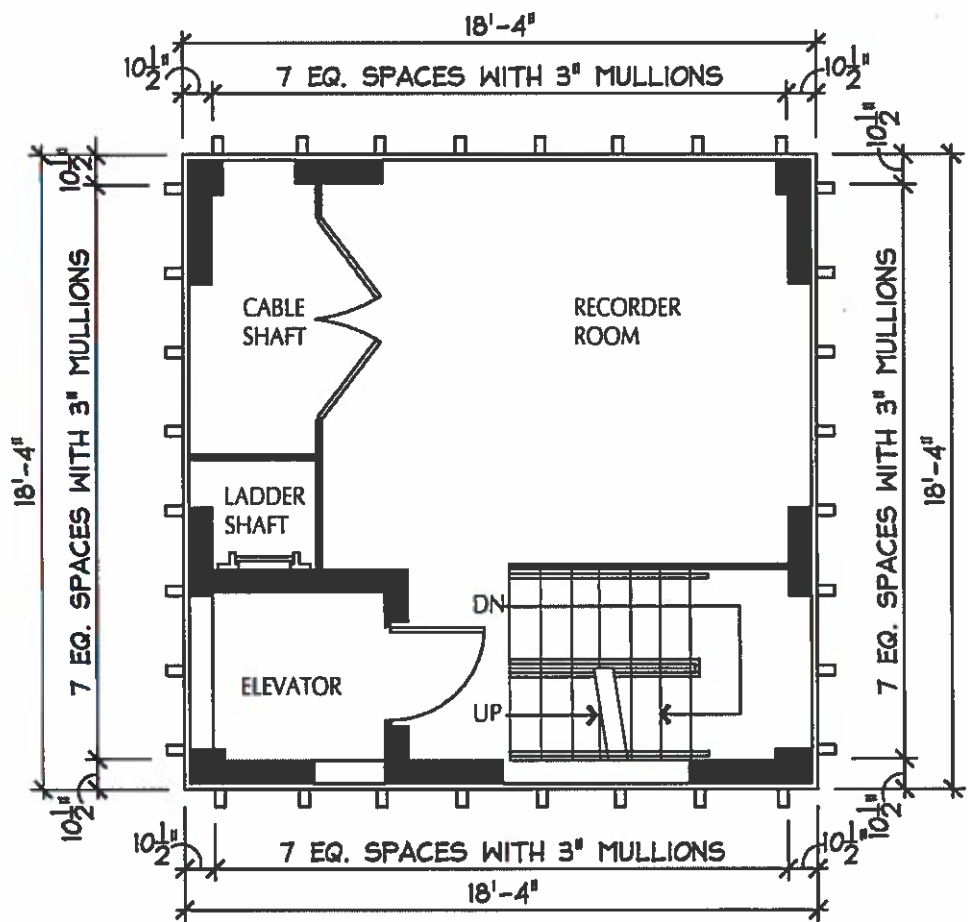


5th Floor

$\frac{3}{16}" = 1'-0"$

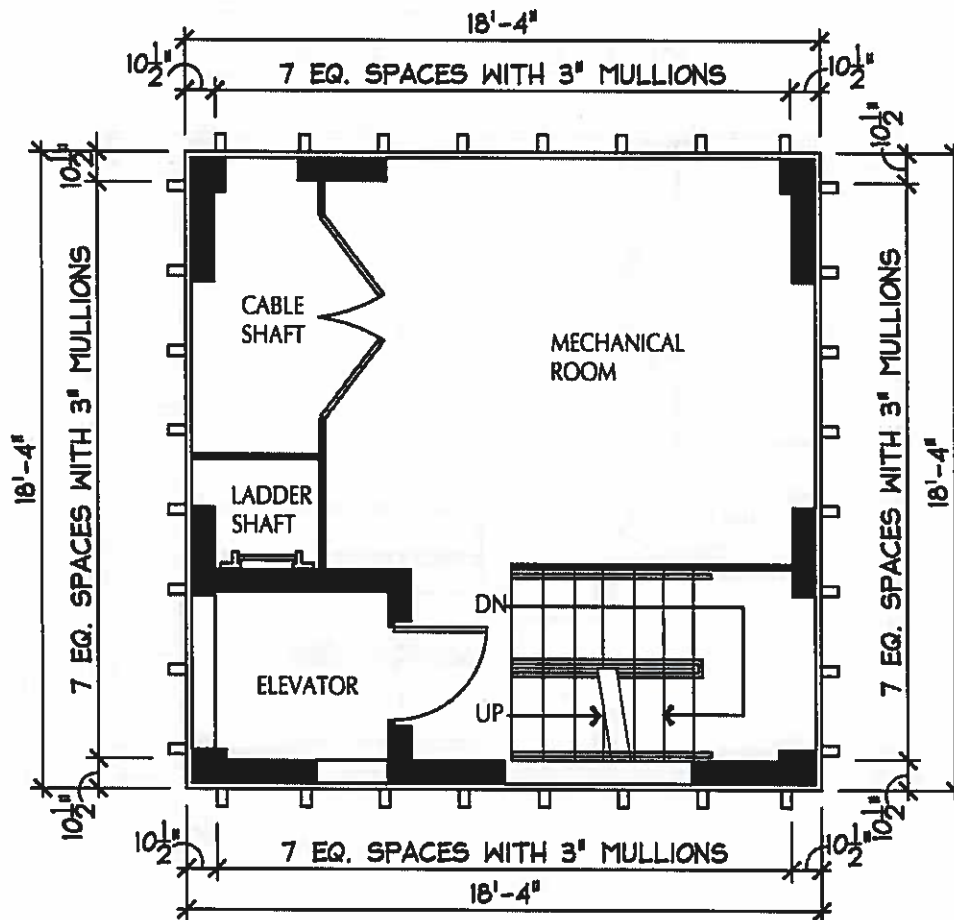


6th Floor

$\frac{3}{16}" = 1'-0"$

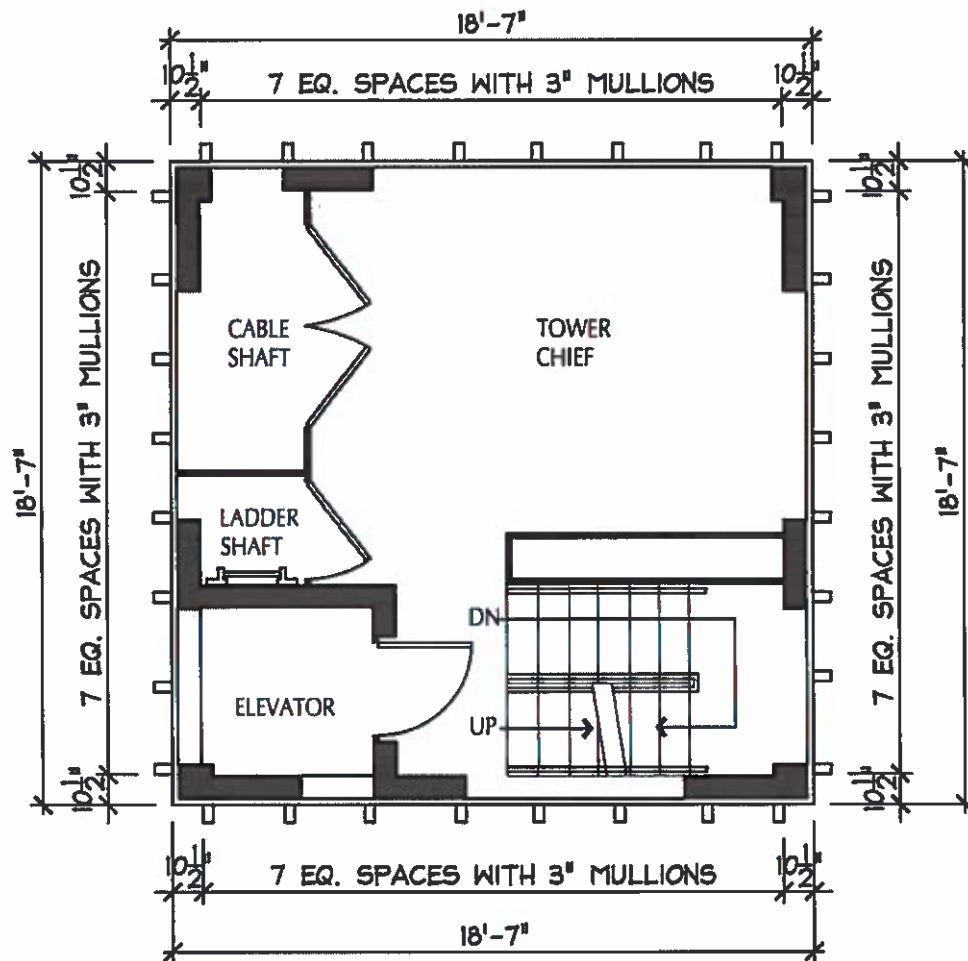


7th Floor

$\frac{3}{16}" = 1'-0"$

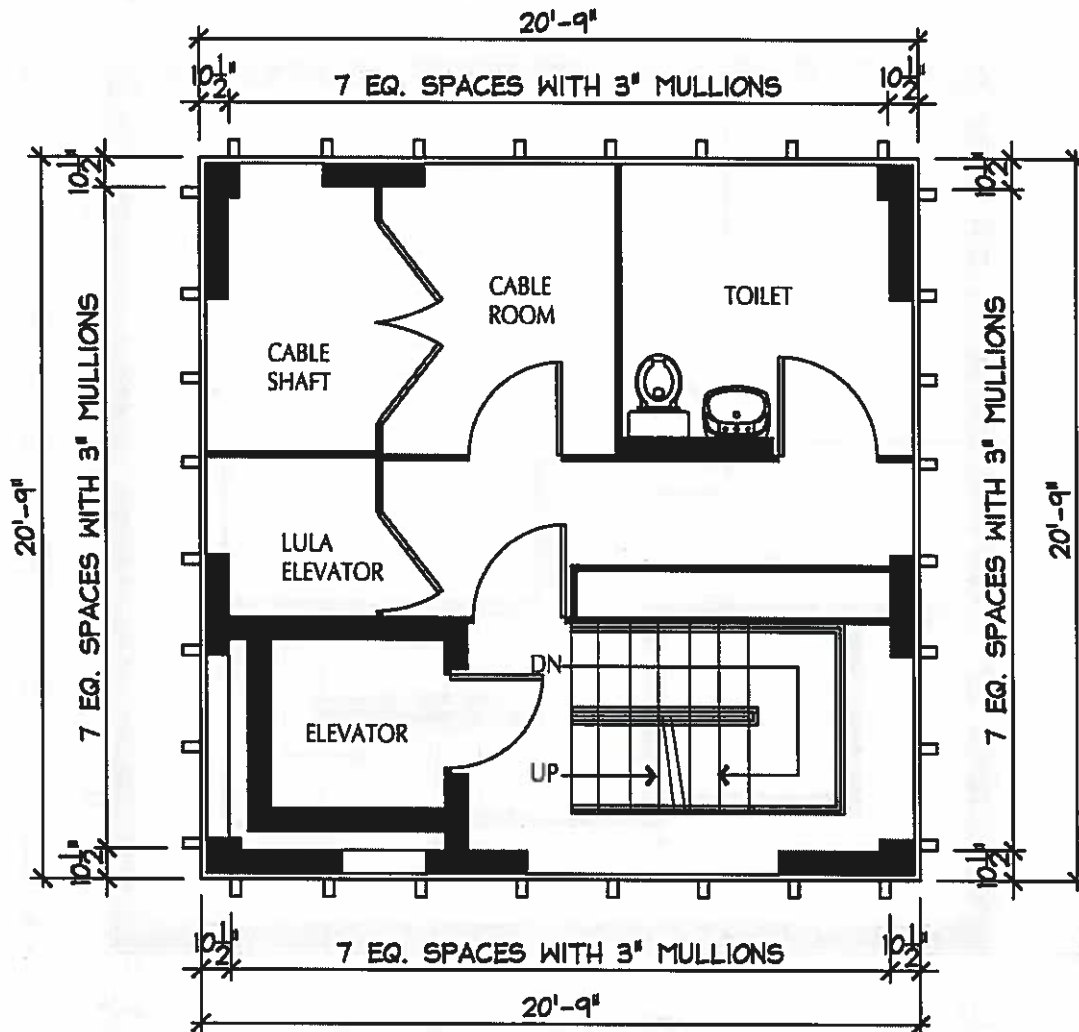

8th Floor
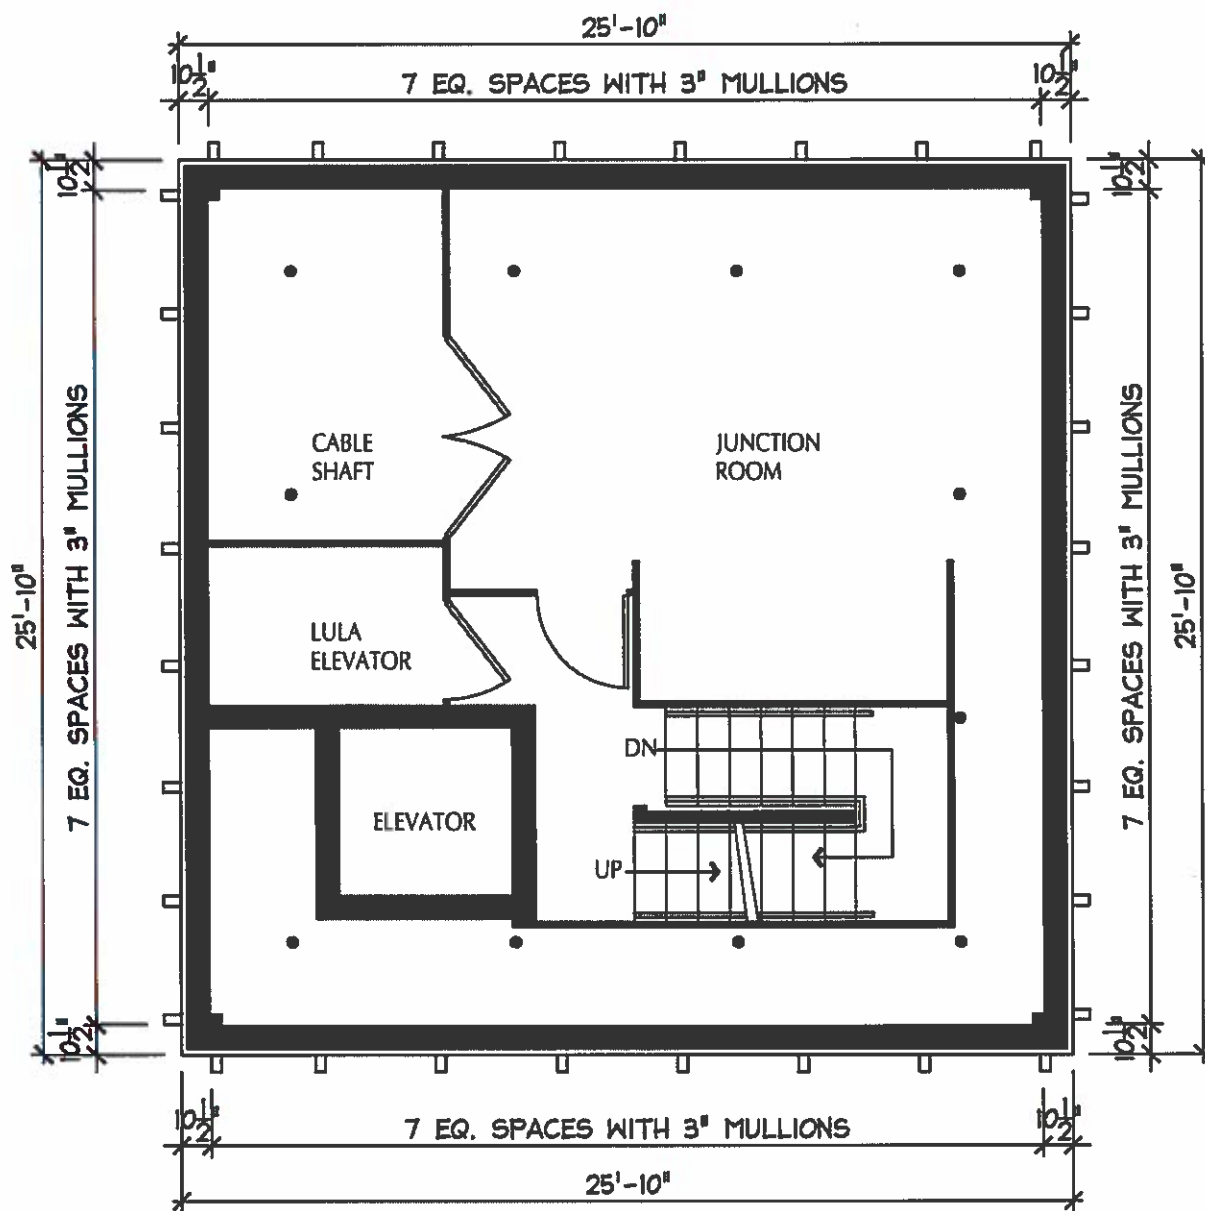
$$\frac{3}{16} = 1 - 0$$


9th Floor

