Item C-07

ZONING AND PLATTING COMMISSION SITE PLAN EXTENSION REVIEW SHEET

CASE NUMBER:	SP-2014-0190D(XT2)	ZAP COMMISSION DATE:	Jan 29, 2019
PROJECT NAME:	Parke North – Site Plan Exte	ension	
ADDRESS:	9100 N FM 620 Rd		
AREA:	49.28 acres		
WATERSHED:	Lake Travis (Water Supply)	Rural)	
COUNCIL DISTRICT:	6		
JURISDICTION:	Full Purpose		
<u>APPLICANT</u> :	Taylor Morrison of Texas, In 11200 Lakeline Blvd Suite I Austin, Texas 78717		
<u>AGENT</u> :	Texas Engineering Solution Connor Overby, P.E. 3815 S Capital of Texas Hw Austin, Texas 78704		

EXISTING ZONING: I-RR

<u>PROPOSED DEVELOPMENT</u>: The applicant has proposed the construction of 143 condominium residences with associated improvements. The extension would allow the completion of the condominium development.

STAFF RECOMMENDATION: Staff recommends approval of the requested 3-year extension to January 22, 2022. Staff previously granted a one year administratively-approved extension from January 22, 2018 to January 22, 2019.

PLANNING COMMISSION ACTION: N/A

<u>CASE MANAGER</u>: Jonathan Davila jonathan.davila@austintexas.gov Telephone: 974-2414

PREVIOUS APPROVALS: The site plan was granted a one year administratively approved extension from January 22, 2018 to January 22, 2019.

PROJECT INFORMATION: 49.28 acres EXIST. ZONING: I-RR MAX. BLDG. COVERAGE: N/A MAX. IMPERV. CVRG: 40%

PROP. BLDG CVRG: 7.519 acres (22.42%) **PROP. IMP. CVRG**: 12.233 acres (36.23%)

A COMPARISON OF THE APPROVED PROJECT WITH CURRENT REGULATIONS

WATERSHED ORDINANCE: This project complies with current watershed regulations.

LAND USE: The site plan complies with all zoning regulations.

ENVIRONMENTAL: All environmental comments have been cleared.

TRANSPORTATION: All transportation comments have been cleared.

SURROUNDING CONDITIONS:

Zoning/ Land Use

North: GR-CO (commercial)

South: SF-6-CO (condominium)

East: MF-2-CO, GR-CO, MF-1-CO, I-RR, MF-3, GR (FM 620 Rd, then multifamily, private educational facilities, convenience storage, religious assembly)

West: N/A - ETJ (undeveloped)

STREET:	R.O.W.	SURFACING	CLASSIFICATION
N FM 620 Rd	150'	80'	Highway

NEIGHBORHOOD ORGANIZATION:

2222 Coalition of Neighborhood Associations, Inc. Bike Austin **Bull Creek Foundation** Canyon Creek H.O.A. Friends of Austin Neighborhoods Leander ISD Population and Survey Analysts Long Canyon Homeowners Assn. Long Canyon Phase II & III Homeowners Assn Inc. Mountain Neighborhood Association (MNA) Neighborhood Empowerment Foundation Northwest Austin Coalition SELTexas Sierra Club, Austin Regional Group The Parke HOA TNR BCP – Travis County Natural Resources Volente Neighborhood Assn.

Item C-07 TEXAS ENGINEERING SOLUTIONS 3815 S. Capital of Texas Highway, STE 300 Austin, Texas 78704 P: (512) 904-0505 F: (512) 904-0509



TBPE Firm #11206

City of Austin Land Use Review Division 505 Barton Springs Road Austin, TX 78704

December 4, 2018

RE: Site Plan Extension Request #2 for Parke North Condominiums (SP-2014-0190D(XT))

To Whom It May Concern:

On behalf of Taylor Morrison of Texas, Texas Engineering Solutions would like to request a second site plan extension for the Site Plan Construction Permit for Parke North Condominiums. The site plan expiration date is currently set for January 22, 2019, which was extended from the previous deadline of January 22, 2018. We would like to request an additional extension of <u>three years</u> to the deadline (January 22, 2022) to complete the project.

Construction has been continuous since the permit was issued. The last phase of civil infrastructure improvements is currently under construction and projected to be completed prior to the current permit expiration date of January 22, 2019. As building permits for condominiums need an active site plan for construction, a site plan extension will allow the owner to be able to sell and construct units in accordance with a fluctuating housing market.

This condominium project consists of 143 single family home units. As of the date of this letter, 63 units have been constructed, 20 units are under construction, and 60 units remain to be permitted and built.

Please contact me if you have any questions regarding this request. Thanks for your time and consideration.

Sincerely.

Connor J Overby, P.E., CPESC Project Manager

UTILITIES

WATER & WASTEWATER

AUSTIN WATER UTILITY AVANTE PLAZA, SUITE 300 625 EAST 10TH STREET AUSTIN, TEXAS 78734 CONTACT: ALFREDO TORRES PHONE: 512.972.0238

ELECTRIC PEDERNALES ELECTRIC 4503 RANCH ROAD 620 NORTH AUSTIN, TX 78732 PHONE: 512.394.9136

CONSULTANTS/CONTRACTORS

CIVIL ENGINEER TEXAS ENGINEERING SOLUTIONS 5000 BEE CAVES ROAD, SUITE 206 AUSTIN, TX 78746 CONTACT: STEPHEN DELGADO, P.E. PHONE: 512.904.0505

SURVEYOR AUSTIN SPATIAL TECHNOLOGIES P.O. BOX 1528 AUSTIN, TEXAS 78767 CONTACT: PAUL SAUVE JR., R.P.L.S. PHONE: 512.573.6730

GAS

TEXAS GAS SERVICES

UTILITY LOCATING SERVICE CONTRACTOR TO CALL BEFORE DIGGING!!!

5613 AVENUE F AUSTIN, TEXAS 78751

PHONE: 512.465.1130

PHONE: 1.800.245.4545

ONE-CALL

CONTACT: MIKE DeVILBISS

OWNER

NOOTSIE LTD. 12750 MERIT DRIVE, SUITE 1175 DALLAS, TX 75251

DEVELOPER

TAYLOR WOODROW COMMUNITIES / STEINER RANCH LTD. 805 LAS CIMAS PARKWAY SUITE 350 AUSTIN, TEXAS 78746

CONTACT: ROBERT LONG PHONE: 512-328-8860

BENCHMARK INFORMATION

PRESSURE ZONE

"PRESSURE ZONE DESIGNATION FOR SUBJECT TRACT" NW PRESSURE ZONE 'C'

LEGAL DESCRIPTION

49.281 ACRES OF LAND, TO BE KNOWN AS PARKE NORTH SUBDIVISION, AND RECORDED AS DOCUMENT NO. 201400167 IN THE OFFICIAL PUBLIC RECORDS OF TRAVIS COUNTY, TEXAS

NOTES

RELEASE OF THIS APPLICATION DOES NOT CONSTITUTE A VERIFICATION OF ALL DATA, INFORMATION AND CALCULATIONS SUPPLIED BY THE APPLICANT, THE ENGINEER OF RECORD IS SOLELY RESPONSIBLE FOR THE COMPLETENESS, ACCURACY, AND ADEQUACY OF HIS/HER SUBMITTAL, WHETHER OR NOT THE APPLICATION IS REVIEWED FOR CODE COMPLIANCE BY CITY ENGINEERS.

2. CITY OF AUSTIN WILL NOT RECEIVE ANY SEWAGE AND/OR EFFLUENT UNTIL THE WHOLESALE WASTEWATER AGREEMENT WITH THE CITY OF AUSTIN HAS BEEN EXECUTED. ONCE THE AGREEMENT IS SIGNED ANY WASTEWATER DISCHARGED TO THE CITY OF AUSTIN WILL BE IN ACCORDANCE WITH THE WHOLESALE WASTEWATER. AGREEMENT FOR THE CITY OF AUSTIN.

3. THIS SUBDIVISION IS NOT AFFECTED BY 100 YEAR FLOOD PLAIN AS SHOWN ON THE FLOOD INSURANCE RATE MAP FOR TRAVIS COUNTY, TEXAS AND INCORPORATED AREAS, No. FM48453C0230H & FM48453C0240H, EFFECTIVE DATE SEPTEMBER 26, 2008 PREPARED BY THE FEDERAL EMERGENCY MANAGEMENT AGENCY.

4. THIS PROJECT IS LOCATED IN THE LAKE TRAVIS WATERSHED, AND IS CLASSIFIED AS A WATER SUPPLY RURAL WATERSHED BY THE CITY OF AUSTIN AND WILL BE DEVELOPED, CONSTRUCTED, AND MAINTAINED IN COMPLIANCE WITH CHAPTER 25-8 OF THE AUSTIN CITY CODE. LOT 1 BLOCK A AND LOT 2 BLOCK A OF THIS PROJECT AS INDICATED ON THE REVISED PRELIMINARY PLAN FOR PARKE NORTH WILL BE SUBJECT TO THE LAKE TRAVIS WATERSHED ORDINANCE No. 840308-K.

THIS PROJECT IS LOCATED OVER THE NORTH EDWARDS AQUIFER RECHARGE ZONE IN ACCORDANCE WITH THE CITY OF AUSTIN AND IS OUTSIDE OF THE EDWARDS AQUIFER RECHARGE ZONE ACCORDING TO TCEQ.

6. POND WALLS ARE GREATER THAN 6'.

7. A COPY OF THE IPM PLAN SHALL BE PROVIDED TO THE OWNER OF EACH INDIVIDUAL UNIT.

8. THIS PROJECT IS SUBJECT TO THE VOID AND WATER FLOW MITIGATION RULE (COA ECM1.12.0 AND COAITEM No. 658S OF THE SSM) PROVISION THAT, ALL TRENCHING GREATER THAT 5 FEET DEEP MUST BE INSPECTED BY A GEOLOGIST (TEXAS P.G.) OR A GEOLOGIST'S REPRESENTATIVE.

9. THE DISTURBED AREAS WITHIN THIS PROJECT SHALL BE REVEGETATED AND ALL PERMANENT EROSION/SEDIMENTATION CONTROLS COMPLETED PRIOR TO THE RELEASE OF FISCAL SURETY FOR THAT PHASE. TEMPORARY EROSION/SEDIMENTATION CONTROLS SHALL BE ADJUSTED AS NEEDED PRIOR TO THIS RELEASE TO ENSURE THAT SUBSEQUENT PHASE DISTURBED AREAS ARE ADEQUATELY COVERED. ANY AREA WITHIN THE LIMIT OF DISTURBANCE OF THE PROJECT WHICH IS NOT ADEQUATELY REVEGETATED SHALL BE BROUGHT INTO COMPLIANCE PRIOR TO THE RELEASE OF THE FINAL PHASE.

10. ALL IMPROVEMENTS SHALL BE MADE IN ACCORDANCE WITH THE RELEASED SITE PLAN. ANY ADDITIONAL IMPROVEMENTS WILL REQUIRE SITE PLAN AMENDMENT AND APPROVAL OF THE PLANNING AND DEVELOPMENT REVIEW DEPARTMENT

11. APPROVAL OF THIS SITE PLAN DOES NOT INCLUDE BUILDING AND FIRE CODE APPROVAL NOR BUILDING PERMIT APPROVAL.

12. ALL SIGNS MUST COMPLY WITH REQUIREMENTS OF THE LAND DEVELOPMENT CODE (CHAPTER 25-10).

13. ADDITIONAL ELECTRIC EASEMENTS MAY BE REQUIRED AT A LATER DATE.

14. WATER AND WASTEWATER SERVICE WILL BE PROVIDED BY THE CITY OF AUSTIN.

15. ALL EXISTING STRUCTURES SHOWN TO BE REMOVED WILL REQUIRE A DEMOLITION PERMIT FROM THE CITY O USTIN PLANNING AND DEVELOPMENT REVIEW DEPARTMENT.

16. A DEVELOPMENT PERMIT MUST BE ISSUED PRIOR TO AN APPLICATION FOR BUILDING PERMIT FOR ON-CONSOLIDATED OR PLANNING COMMISSION APPROVED SITE PLANS.

17. NO CERTIFICATE OF OCCUPANCY MAY BE ISSUED FOR THE PROPOSED RESIDENTIAL CONDOMINIUM PROJECT NTIL THE OWNER OR OWNERS OF THE PROPERTY HAVE COMPLIED WITH CHAPTER 81 AND 82 OF THE PROPERTY CODE OF THE STATE OF TEXAS OR ANY OTHER STATUTES ENACTED BY THE STATE CONCERNING CONDOMINIUMS. 18. FOR DRIVEWAY CONSTRUCTION: THE OWNER IS RESPONSIBLE FOR ALL COSTS FOR RELOCATION OF, OR

AMAGE TO UTILITIES. 19. FOR CONSTRUCTION WITHIN THE RIGHT-OF-WAY, A ROW EXCAVATION PERMIT IS REQUIRED.

20. ANY PROPOSED RETAINING WALLS SHALL REQUIRE A SEPARATE BUILDING PERMIT.

21. AN ADMINISTRATIVE WAIVER FROM THE REGULATIONS ON CUT/FILL LIMITS HAS BEEN GRANTED WITH THE APPROVAL OF THIS SITE PLAN FOR ONLY THOSE AREAS ASSOCIATED WITH THE WATER QUALITY AND DETENTION CONTROL FACILITIES. IN ACCORDANCE WITH LDC 28-8-42(B)(6). THE MAXIMUM AMOUNT OF CUT REQUESTED IS 9.76 FEET.


NOTE TO CONTRACTOR

BY THE ACT OF SUBMITTING A BID FOR THIS PROPOSED CONTRACT, THE BIDDER WARRANTS THAT THE BIDDER AND ALL SUBCONTRACTORS AND MATERIAL SUPPLIERS HE INTENDS TO USE, HAVE CAREFULLY AND THOROUGHLY REVIEWED THE DRAWINGS. SPECIFICATIONS AND ALL OTHER CONTRACT DOCUMENTS AND HAVE FOUND THEM COMPLETE AND FREE FROM ANY AMBIGUITIES AND SUFFICIENT FOR THE PURPOSE INTENDED. THE BIDDER FURTHER WARRANTS THAT TO THE BEST OF HIS OR HIS SUBGONTRACTORS' AND MATERIAL SUPPLIERS' KNOWLEDGE, ALL MATERIALS AND PRODUCTS SPECIFIED OR INDICATED HEREIN ARE ACCEPTABLE FOR ALL APPLICABLE CODES AND AUTHORITIES.

THE LOCATION OF ALL EXISTING UTILITIES SHOWN ON THESE PLANS HAS BEEN BASED UPON RECORD INFORMATION ONLY AND MAY NOT MATCH LOCATIONS AND/OR DEPTHS AS CONSTRUCTED. THE CONTRACTOR SHALL CONTACT THE AUSTIN AREA "ONE CALL" SYSTEM 1-800-245-4545, OR THE OWNER OF EACH INDIVIDUAL UTILITY, FOR ASSISTANCE IN DETERMINING EXISTING UTILITY LOCATIONS AND DEPTHS PRIOR TO BEGINNING ANY CONSTRUCTION. CONTRACTOR SHALL FIELD VERIFY LOCATIONS OF ALL UTILITY CROSSINGS PRIOR TO BEGINNING ANY CONSTRUCTION.

ENVIRONMENTAL INSPECTION HAS THE AUTHORITY TO MODIFY/CHANGE EROSION AND SEDIMENTATION CONTROLS TO KEEP THE PROJECT IN COMPLIANCE, AS PER SECTION 25-8-183 OF THE LAND DEVELOPMENT CODE.

		1	an a
		F	RALACEO 85.850 PMA
CITY OF AUSTIN 2-MILE FTJ			
CITY OI		\searrow	
		L	
		J	
	2-MILE ETJ CITY OF AUSTIN	3	
		vo	RM 620 NOR (R.O.W. 150 LUME 948, PAGE 90
and a second		alar na na ana	and the off of Common constrained by the Common sector of the Commo
SER APF	ROVALS		No.
	WATER AND WASTEWATER SERVICE EXTENSION REQUEST FOR CONSIDERATION		
Name: Nootsie: Tract		Service R	equested: Water
SER-3263 Ha	nsen Service Request Number 484454		Date Received: 04
Location: NFM 620 RD AUSTIN TX 78734	4- NOOTSIE TRACT		·····
Acres: 49.29	Land Use: CONDOMINIUMS		
Alt. Utility Service or S.E.R. Number: City of	of Austin Wastewater SER-3264		
Quad(s): D36 D37			DDZ: NO
		гс	DWPZ: YES
Drainage Basin: BULL	Pressure Zone: NORTHWES		
Drainage Basir: BULL Flow: (Estimated Peak Hour Flow, Gallons p			% Within City Li
Drainage Basir: BULL			% Within City Li
Flow: (Estimated Peak Hour Flow, Gallons p Cost Participation: \$0.00 Description of Improvements: Applicant shall construct approximately 2,500	er Minute) 337 GPM	ich water i ract, and t	% Within Limite

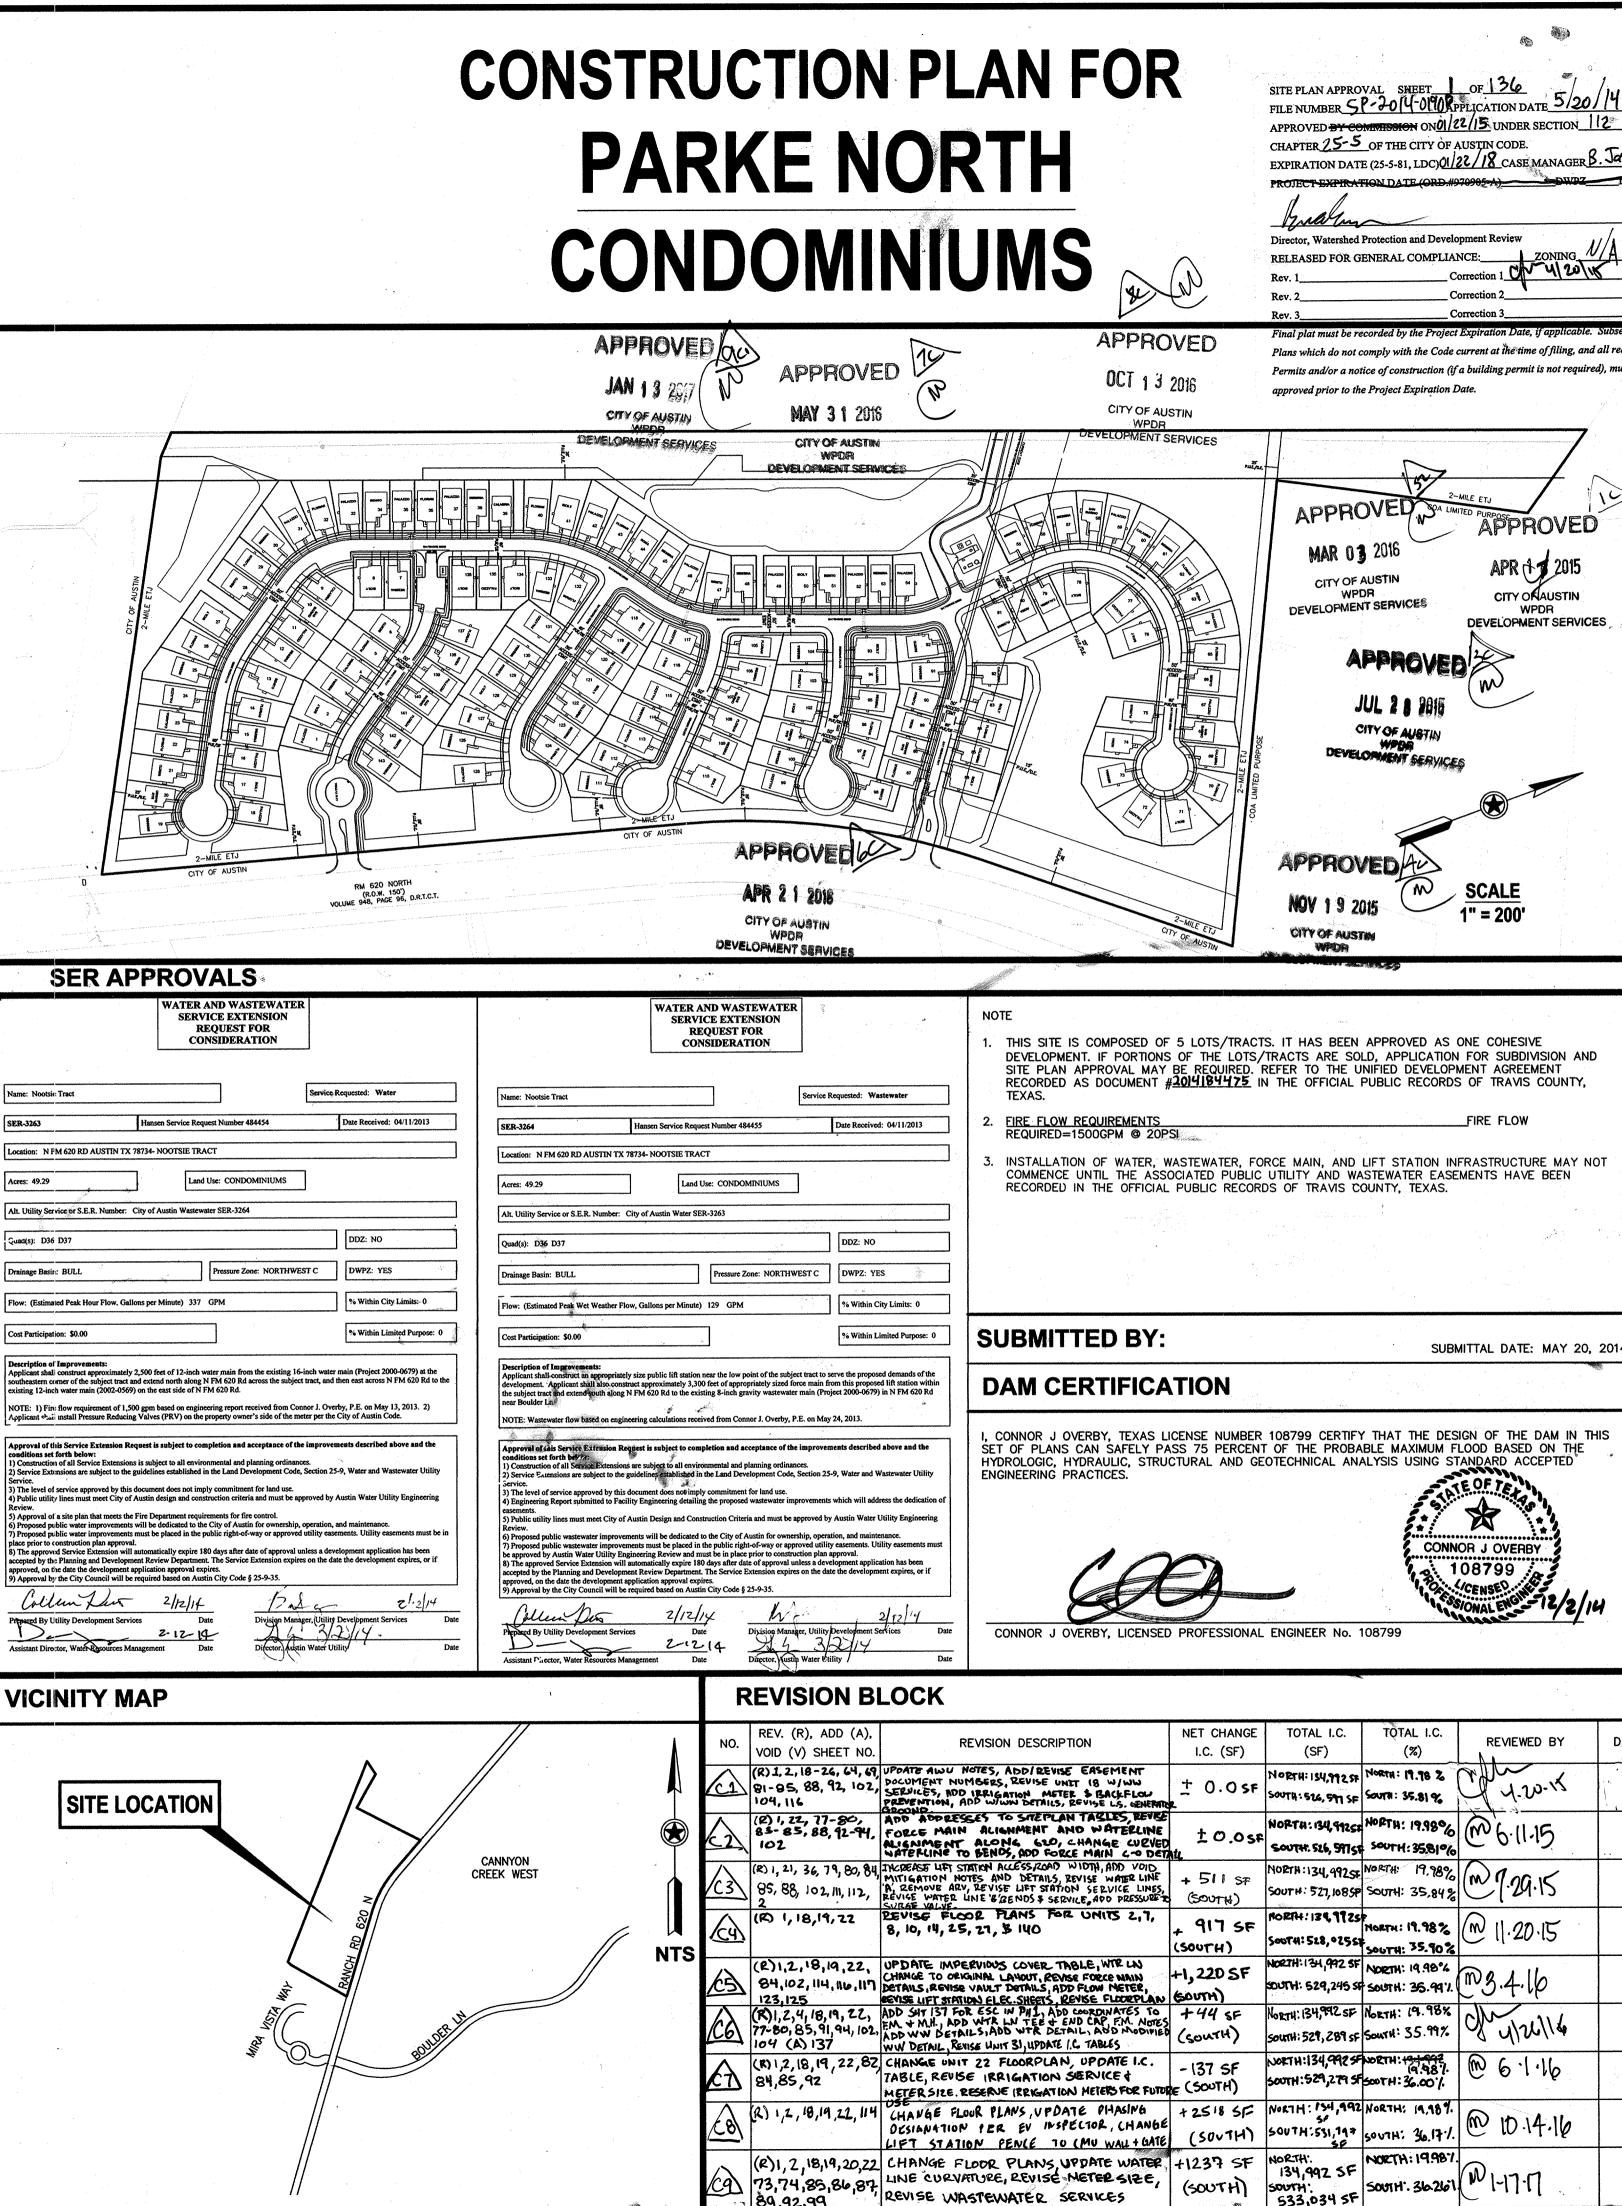


89.92.99


533,034 SF

and the second

						سيسد	
		1 And					
	*//		WATER PLAN & PROFILE LINE 'F'	74			
	ERBY	CONNOR J OVER					
		108799			3 GENERAL NOTES 2 OF 2)F	OF
	NONCE	MISS/ONAL C	RCE MAIN LINE 'A' STA. 9+00 - 20+50	78		Q1	tra
	12/2/10		RCE MAIN LINE 'A' STA. 20+50 - 30+50	79		1	
					7 EROSION SEDIMENTATION CONTROL PLAN 3 OF 4		
			- 2019년 1월 19일 - 1월 19일 - 2월 1				
			LINE PLAN & PROFILE LINE 'A' STA. 1+00 - 7+00	83			
	14. 1	Toyas		÷			
The second of the second	1.88						
	· · · · ·		LINE PLAN & PROFILE LINE 'A' STA. 27+00 - 32+50	87	14 GRADING PLAN 4 OF 4	14	
							12
Book at CAN Book at C							
			LINE PLAN & PROFILE LINE 'E'	91			
				1 altreat	19 SITE PLAN 1 OF 4	ŀ	
				94			1
1 medi frag p medi frag p 2 medi frag p medi frag p 3 medi frag p medi frag p 4 medi frag p medi frag p 5 medi frag medi frag p 6 medi frag medi frag p 7 medi frag medi frag p 8 medi frag medi frag p 9 medi frag medi frag p 9 medi frag medi frag p 10 medi frag medi frag medi frag 10 medi frag medi frag medi frag medi frag 10 medi frag medi frag medi frag medi frag 10 medi frag medi frag medi frag medi frag 10 medi frag medi frag medi frag medi frag 10 medi frag medi frag medi frag medi frag 10 medi frag medi frag medi frag medi frag me							-
Product Index Product	s Road	5000 Bee Caves F			23 PHASE 1 PLAN		
	5	Suite 206	DETAILS 2 OF 3	98			
2 Buildee Borlin, Lon, Landy, La		Austin, Texas 78 O: 512-904-050					
	509	F: 512-904-050					
Provided to a serie of the series of th			WATER DETAILS 2 OF 2	102			
Provement of the first of the second data of the data of the second data of the seco	ATA	PROJECT DAT	김 사람이 가지 않는 것 같아요. 이 가장 갑옷이 가지 않는 것 못했는 것				
Bedraff Ore & RUMER Control Contr	TRAVI			,			
A we dealer we	AUSTIN ET						
Be of tests av Be dest Be des	N/	NUMBER:	and a start of the second s			,	
$ \begin{array}{c} \begin{array}{c} \begin{array}{c} \begin{array}{c} \begin{array}{c} \begin{array}{c} \begin{array}{c} \begin{array}{c}$	8J-85-09		という ション・ション 人名英格兰 かんしょう ないしょう しょうしょう			2	
3 WHAT 2 3 3 III UI TRANS BE AM OD DUESS 4 WHAT 3 III UI TRANS BE AM OD DUESS 5 WHAT 3 III UI TRANS BE AM OD DUESS 6 WHAT 3 III UI TRANS BE AM OD DUESS 7 WHAT 3 III UI TRANS BE AM OD DUESS 8 WHAT 3 III UI TRANS BE AM OD DUESS 9 WHAT 3 III UI TRANS BE AM OD DUESS 9 WHAT 3 III UI TRANS BE AM OD DUESS 9 WHAT 3 III UI TRANS BE AM OD DUESS 9 BORD 4 III UI TRANS BE AM OD DUESS 9 BORD 4 III III III III III III III III III II	N FM 62 , TX 7872		the second s				
19 PML 4 10 UT RATE RULE 1000 20046 19 PML 4 UT RATE RULE 30 / 2 20046 19 PML 4 UT RATE RULE 30 / 2 20046 19 PML 4 UT RATE RULE 30 / 2 20046 10 La RETER RULE 30 / 2 10 La RETER RULE 30 / 2 20046 10 La RETER RULE 10 / RULE 30 / 2 10 La RETER RULE 10 / RULE 30 / 2 20046 10 La RETER RULE 10 / RULE 30 / 2 10 La RETER RULE 10 / RULE 30 / 2 20046 10 DEGRETER PLAI 10 / RULE 30 / 2 10 La RETER RULE 10 / RULE 30 / 2 20046 10 DEGRETER PLAI 10 / RULE 30 / 2 10 La RETER RULE 10 / RULE 30 / 2 20046 10 DEGRETER PLAI 10 / RULE 30 / 2 10 10 10 10 10 10 DEGRETER PLAI 10 / RULE 30 / 2 10	D36 & D3						
$\begin{array}{c} \label{eq: constraints} \begin{tabular}{l l l l l l l l l l l l l l l l l l l $							
	3453C0230	FEMA MAD DANEL 4845					
4 PHE 5 PT C 1 of Lie Kindle Chail 4 PHE 5 PHE 5 PHE 5 5 PHE 5 PHE 5 5 PHE 5 <th>3453C0240</th> <th>FEMA MAP FANEL: 4845</th> <th></th> <th></th> <th></th> <th></th> <th></th>	3453C0240	FEMA MAP FANEL: 4845					
			NE LINE DIAGRAM	117			
	DRIVE,	12750 MERIT DR					
		DALLAS, TX 75					
						-	
9 TORNEL OF Must 1 IN TURN & PORTE 19 L-10 Actimute TURNS 9 TORNEL OF Must 1 IN TURN & PORTE 19 L-10 Actimute TURNS 10 L-10 Actimute TURNS 9 TORNEL OF Must 2 I UV TURN & PORTE 10 L-10 Actimute TURNS 10 L-10 Actimute TURNS 10 TORNEL OF MUST 2 I UV TURN & PORTE 10 L-10 Actimute TURNS 10<			그렇게 잘 물었다. 영화 가지 않아? 이렇게 한 것 같아요. 이 가지 않는 것 같아요.		49 STORMSEWER PHASE 1 LN 'A' PLAN & PROFILE		
9 стоявления ниже з ци от нам и нижи 19 стоявления ниже з ци от нам и нижи 19 стоявления ниже з ци от нам и нижи 19 стоявления ниже з ци от нам и нижи 19 стоявления ниже з ци от нам и нижи 19 стоявления ниже з ци от нам и нижи 19 стоявления ниже з ци от нам и нижи 19 стоявления ниже з ци от нам и нижи 19 стоявления ниже з ци от нам и нижи 19 стоявления ниже з ци от нам и нижи 19 стоявления нижи з с л 19 стоявления нижи з с л 19 19 стоявления нижи з с л 19 19 19 19 19 стоявления нижи з с л 19 10 19 19 10 10 10 10 10 10 10 10 10 10 10 10	ER	DEVELOPER					
3 STRANSME PAUE 2 UN TA ALL PROFILE US LIS PO FORSE SCIONS LOKE PAUE AURINE ALL PAUE AURINE 4 STRANSME PAUE 2 UN TA ALL PROFILE US LIS PO FORSE SCIONS LOKE PAUE AURINE ALL PAUE AURINE 5 STRANSME PAUE 2 UN TA ALL PROFILE US LIS PO FORSE SCIONS LOKE PAUE AURINE ALL PAUE AURINE 5 STRANSME PAUE 2 UN TA ALL PROFILE US LIS POP FORSE SCIONS LOKE PAUE AURINE STRANSME PAUE AURINE 5 STRANSME PAUE 2 UN TA ALL PROFILE US LIS POP FORSE SCIONS LOKE PAUE AURINE STRANSME PAUE AURINE 5 STRANSMER PAUE 2 UN TA ALL PROFILE US DOWN MORE AURINE PAUE AURINE STRANSME PAUE AURINE STRANSME PAUE AURINE 5 STRANSMER PAUE AURINE PAUE AURINE STRANSME PAUE AURINE PAUE AURINE STRANSME PAUE AURINE S	OF TEXA	TAYLOR MORRISON O		1	PROFILE		
7 A CLARTY IF PAIL & TORNERINE PASE 2 OF 7 A CLARTY IF PAIL & TORNERINE PASE 2 OF 7 A CLARTY IF PAIL & TORNERINE PASE 2 OF 7 A CLARTY IF PAIL & TORNERINE PASE 2 OF 7 A CLARTY IF PAIL & TORNERINE PASE 2 OF 7 A CLARTY IF PAIL & TORNERINE PASE 2 OF 7 A CLARTY IF PAIL & TORNERINE PASE 2 OF 7 A CLARTY IF PAIL & TORNERINE PASE 2 OF 7 A CLARTY IF PAIL & TORNERINE PASE 2 OF 7 A CLARTY IF PAIL & TORNERINE PASE 2 OF 7 A CLARTY IF PAIL & TORNERINE PAIL A TO 7 A CLARTY IF PAIL & TORNERINE PAIL A TO 7 A CLARTY IF PAIL A TO 7 A CLARTY IF PAIL A PAIL OF 7 A CLARTY IF PAIL A PAIL OF 7 A CLARTY PAIL A PA		AUSITN, TEXAS 78 PHONE: 512-328-8	CONTROL PANEL DOOR WIRING	128	54 STORMSEWER PHASE 2 LN 'G' PLAN & PROFILE		
540 131 STRUCTURA NOTE: & CULUE 540 131 STRUCTURA NOTE: & CULUE 541 STRUCTURA NOTE: & CULUE 131 STRUCTURA NOTE: & CULUE 541 STRUCTURA NOTE: & CULUE 131 STRUCTURA NOTE: & CULUE 131 541 STRUCTURA NOTE: & CULUE 131 STRUCTURA NOTE: & CULUE 131 STRUCTURA NOTE: & CULUE 541 STRUCTURA NOTE: & CULUE STRUCTURA NOTE: & CULUE STRUCTURA NOTE: & CULUE 131 STRUCTURA NOTE: & CULUE STRUCTURA NOTE:						•	
133 NOTE 134 NOTE 134 NOTE 135 135 NOTE 135 NOTE 135 NOTE 135 136 NOTE 135 NOTE 135 NOTE 135 137 NOTE 135 NOTE 135 NOTE 135 138 NOTE 135 NOTE 135 NOTE 135 139 SOTE 135 NOTE 135 NOTE 135 130 NOTE 135 NOTE 135 NOTE 135 <th>NTS:</th> <th>CONSULTANT</th> <th></th> <th></th> <th>5+00</th> <th></th> <th>1.</th>	NTS:	CONSULTANT			5+00		1.
Percel					PROFILE		
30 SUITH WOP SECTIONS, & BETWELS 1 OF 2 31 SUITH WOP SECTIONS, & BETWELS 2 OF 2 30 SUITH WOP SECTIONS, & BETWELS 2 OF 2 <th></th> <th></th> <th></th> <th></th> <th>PROFILE</th> <th></th> <th></th>					PROFILE		
ADVIT MATCH ENDONERNO South ACTEMPTION FOOD South ACTEMPTION FOOD South ACTEMPTION FOOD South ACTEMPTION FORD South ACTEMPTION SouthACTEMPTION			WOP SECTIONS, & DETAILS 1 OF 2	135			
B3 SOUTH WREE OULLY FOOD B4 ORDALL WREEWARF RUM 2 OF 2 B5 ORDALL WREEWARF RUM 2 FOR 2 B5 OWNEEWARF RUM 2 FOR 2 B5 WREEWARF RUM 2 FOR 2 B5 WREEWED BY: B5 WREEWED BY: B5 WREEWED BY: B5 DATE B5 DATE B5 DATE B5 DATE B5 DATE B6 DATE B7 REVIEWED BY: B7 B7 B7 B7 B7 B7 B7 B7 B7 B7 B7 DATE B7 DATE B7 DATE B7 DATE B7 DATE	n de Britsen Gradie (Gradie) Frank de Gradie		WQP SECTIONS, & DETAILS 2 CF 2	136	61 NORTH WATER QUALITY POND		
e* OVERALL WASTERNER PLAN 2 OF 2 e*							
6 WASTENNER PLAN & PROFILE LINE 'X' STA, 1400 – 7400 0 WASTENNER PLAN & PROFILE LINE 'X' STA, 1400 – 1400 0 WASTENNER PLAN & PROFILE LINE 'X' STA 1400 – 19100 0 WASTENNER PLAN & PROFILE LINE 'X' STA 1400 – 19100 0 WASTENNER PLAN & PROFILE LINE 'X' STA 1400 – 19100 0 WASTENNER PLAN & PROFILE LINE 'X' STA 1400 – 19100 0 WASTENNER PLAN & PROFILE LINE 'X' STA 1400 – 19100 0 WASTENNER PLAN & PROFILE LINE 'X' STA 1400 – 19100 0 WASTENNER PLAN & PROFILE LINE 'X' STA 1400 – 19100 0 WASTENNER PLAN & PROFILE LINE 'X' STA 1400 – 19100 0 WASTENNER PLAN & PROFILE LINE 'X' STA 1400 – 19100 0 WASTENNER PLAN & PROFILE LINE 'X' STA 1400 – 19100 0 WASTENNER PLAN & PROFILE LINE 'X' STA 1400 – 19100 0 WASTENNER PLAN & PROFILE LINE 'X' STA 1400 – 19100 0 WASTENNER PLAN & PROFILE LINE 'X' STA 1400 – 19100 0 WASTENNER PLAN & PROFILE LINE 'X' STA 1400 – 19100 0 WASTENNER PLAN & PROFILE LINE 'X' STA 1400 – 19100 0 WASTENNER'Y' TENNSPORTATION AND NATURAL RESOURCES DATE 10 SEP – 2014 – 0190D OATE 0 SEY – 0190D DATE DATE<							
Inspection Inspection Inspection 91 HEAR INFORMATION AND NATURAL PRESOURCES DATE Inspection Inspection Inspection Inspection 91 HEAR INFORMATION TO INFORMATION Inspection Inspection Inspection Inspection Inspection Inspection Inspection Inspection 91 HEAR INFORMATION TERMIT NUMBER Inspection Inspection Inspection Inspection Inspection Inspection							
Bit WARTER WALE REWAIN & ROUTE LIKE Y STIL 14-00 - 19-00 Bit WARTER RUAL REWAIN & ROUTE LIKE Y STIL 19-00 - DID WINSTERATER PLAN & ROUTE LIKE Y STIL 19-00 - DID WINSTERATER PLAN & ROUTE LIKE Y STIL 19-00 - DID WINSTERATER PLAN & ROUTE LIKE Y WINSTERATER PLAN & ROUTE DEPARTMENT SP - 2014 - 0190D ARY OF AUSTIN DEVELOPMENT REVIEW DEPARTMENT SP - 2014 - 0190D ARY OF AUSTIN DEVELOPMENT REVIEW DEPARTMENT SP - 2014 - 0190D ARY OF AUSTIN DEVELOPMENT REVIEW DEPARTMENT SP - 2014 - 0190D ARY OF AUSTIN DEVELOPMENT REVIEW DEPARTMENT SP - 2014 - 0190D ARY OF AUSTIN DEVELOPMENT REVIEW DEPARTMENT SP - 2014 - 0190D ARY OF AUSTIN DEVELOPMENT REVIEW DEPARTMENT SP - 2014 - 0190D ARY OF AUSTIN DEVELOPMENT REVIEW DEPARTMENT SP - 2014 - 0190D ARY OF AUSTIN DEVELOPMENT REVIEW DEPARTMENT SP - 2014 - 0190D ARY OF AUSTIN DEVELOPMENT REVIEW DEPARTMENT SP - 2014 - 0190D ARY OF AUSTIN DEVELOPMENT REVIEW DEPARTMENT SP - 2014 - 0190D ARY OF AUSTIN DEVELOPMENT REVIEW DEPARTMENT ANU PPE LIKE ENGINEERING DATE DATE SP - 2014 - 0190D ARY OF AUSTIN DEVELOPMENT OF TRANSPORTATION ANU PPE LIKE ENGINEERING DATE DATE SP - 2014 - 0190D ARY OF AUSTIN DEVELOPMENT OF TRANSPORTATION ANU PPE LIKE ENGINEERING DATE DATE SP - 2014 - 0190D ARY OF AUSTIN DEVELOPMENT AD AUSTIN INDICATES COMPLIANCE WINT ADDITIONAL			on Notice: Please call Watershed Protection		(b) A second se second second sec		
70 NUSTERARE RAM & PROFILE LINE TO Inspection of the public utilise related to the area in programmed to the public utilise related to the area in programmed to the public utilise related to the area in programmed to the public utilise related to the area in programmed to the public utilise related to the area in programmed to the public utilise related to the area in programmed to the public utilise related to the area in programmed to the public utilise related to the area in programmed to the public utilise related to the area in programmed to the public utilise related to the area in programmed to the public utilise related to the area in programmed to the public utilise related to the area in programmed to the public utilise related to the public utilise related to the area in programmed public utilise related to the public utilise related to the area in programmed to the public utilise related to the area in programmed to the public utilise related to the area in public utilise related to the area in programmed to the public utilise areas in programmed to	IS .	REVISIONS	at 9,74 6360 for arrangements for	1		-	
Independing fees must be paid before any Pre-construction meeting can be held. REVIEWED BY: Interviewed to general be held. Iterviewed to general be held.	CRIPTION	NO DATE - DESCR	It of inspection fees and job assignment for on of the public utilities related to this site.				
REVIEWED BY: IZ: 4:2014 ITRAMS COUNTY TRANSPORTATION AND NATURAL RESOURCES DATE 12: 4:2014 DATE 14-4410 TRAMS COUNTY DEVELOPMENT PERMIT NUMBER DATE DATE DATE PLANNING & DEVELOPMENT REVIEW DEPARTMENT DATE DATE PLANNING & DEVELOPMENT PERMIT NUMBER MUCHTON DEVELOPMENT REVIEW DEPARTMENT DATE			on fees must be paid before any		WASIEWAIER PLAN & PROFILE LINE 'B'		
Image: Source of the second			Suddiph meeting can be new.				
Image: Country transportation and natural resources 12. 4. 2014 14-4410 Date TRAVIS COUNTY DEVELOPMENT PERMIT NUMBER 01/22/2015 PLAINING & DEVELOPMENT PERMIT NUMBER 01/22/2015 PLAINING & DEVELOPMENT PERMIT NUMBER 01/22/2015 PLAINING & DEVELOPMENT REVIEW DEPARTMENT DATE SP-2014-0190D DATE ORIZONTAL SCALE: 1* PROFEDER RAVU OF AUSTIN DEVELOPMENT PERMIT NUMBER AUSTIN WATER UTILITY EXPIRATION DATE 12/02/2014 OATE DATE COUNTY FIRE MARSHALL JAN 20 2018 AWU PAPE LINE ENGINEERING DATE MUL FACILITIES ENGINEERING DATE MUL FA			The second s	1.7	REVIEWED BY:		
TRAVIS COUNTY TRANSPORTATION AND NATURAL RESOURCES DATE 14-4410 TRAVIS COUNTY DEVELOPMENT PERMIT NUMBER UTION OF COUNTY DEVELOPMENT PERMIT NUMBER PLANNING & DEVELOPMENT PERMIT NUMBER PLANNING & DEVELOPMENT REVIEW DEPARTMENT SP-2014-0190D ONTO AUSTIN DEVELOPMENT PERMIT NUMBER AUSTIN WATER UTINTY EXPIRATION DATE TRAVIS COUNTY FIRE MARSHALL AWU OF AUSTIN DEVELOPMENT PERMIT NUMBER AUSTIN WATER UTINTY EXPIRATION DATE TRAVIS COUNTY FIRE MARSHALL AWU PRE LINE ENGINEERING AWU PRE LINE ENGINEERING TEXAS DEPARTMENT OF TRANSPORTATION UIR NUMBER AWU SACILITES ENGINEERING TEXAS DEPARTMENT OF TRANSPORTATION UIR NUMBER AWU SACILITES ENGINEERING TEXAS DEPARTMENT OF TRANSPORTATION UIR NUMBER AWU SACILITES ENGINEERING TEXAS DEPARTMENT OF TRANSPORTATION UIR NUMBER AWU SACILITES ENGINEERING AWU SACILITES ENGINEERING TEXAS DEPARTMENT OF TRANSPORTATION UIR NUMBER AWU SACILITES ENGINEERING A					1 In.	8	:0151
TRAVIS COUNTY TRANSPORTATION AND NATURAL RESOURCES DATE 14-4410 TRAVIS COUNTY DEVELOPMENT PERMIT NUMBER UTION OF CONTRAL SCALE I PLANNING & DEVELOPMENT PERMIT NUMBER PLANNING & DEVELOPMENT PERMIT NUMBER PLANNING & DEVELOPMENT REVIEW DEPARTMENT PLANNING & DEVELOPMENT REVIEW DEPARTMENT PLANNING & DEVELOPMENT PERMIT NUMBER PLANNING WITH PERMIT P			12.4.2014				
TRAVIS COUNTY DEVELOPMENT PERMIT NUMBER			DATE	S		ſ	
TRAVIS COUNTY DEVELOPMENT PERMIT NUMBER 01/22/20/5 PLOTTED: December PERMIT BY PLANNING & DEVELOPMENT REVIEW DEPARTMENT DATE 01/22/20/5 PLANNING & DEVELOPMENT REVIEW DEPARTMENT DATE SP-2014-0190D DATE 12/02/20/4 CHY OF AUSTIN DEVELOPMENT PERMIT NUMBER AUSTIN WATER UTILITY EXPIRATION DATE 12/02/20/4 TRAVIS COUNTY FIRE/MARSHALL JAN 20 2018 DATE CONDUCT AWU PIPE LINE ENGINEERING DATE 12/01/15 CONDUCT AWU SACILITIES ENGINEERING DATE 12/01/14 COVER SI TEXAS DEPARTMENT OF TRANSPORTATION UIR NUMBER DATE 12/0/04 COVER SI TEXAS DEPARTMENT OF TRANSPORTATION UIR NUMBER DATE 12/0/04 COVER SI TEXAS DEPARTMENT OF TRANSPORTATION 01-14-34452-0P DATE 12/0/04 COVER SI "APPROVAL OF THESE PLANS BY THE CITY OF AUSTIN INDICATES COMPLIANCE WITH APPLICABLE CITY REVIEWED SING APPROVAL SI ARE POINT ADDITIONAL APPROVAL MAY 12/0/04 1 JAN 22 2015 M JUN 10 2015 OF 13 0F 13	12/2/1	EDITED:			14-4410		
Image: Second State Planning & DEVELOPMENT REVIEW DEPARTMENT DATE SP-2014-0190D DATE Image: Specific Spec		PLOTTED: December			RAVIS COUNTY DEVELOPMENT PERMIT NUMBER		_
PLANNING & DEVELOPMENT REVIEW DEPARTMENT SP-2014-0190D CHTY OF AUSTIN DEVELOPMENT PERMIT NUMBER AUSTIN WATER UTILITY EXPIRATION DATE 12/02/2014 TRAVIS COUNTY FIRE MARSHALL AWU PARE LINE ENGINEERING AWU PARE LINE ENGINEERING AWU PARE LINE ENGINEERING AWU SACILITIES ENGINEERING TEXAS DEPARTMENT OF TRANSPORTATION TEXAS DEPARTMENT OF TRANSPORTATION TI-14-284452-DP TEXAS DEPARTMENT OF TRANSPORTATION OII-14-284452-DP TATE TEXAS DEPARTMENT OF TRANSPORTATION OII-14-284452-DP TATE T	' = 10.00		AI IND L		1 And	1	
SP-2014-0190D SPTY OF AUSTIN DEVELOPMENT PERMIT NUMBER AUSTIN WATER UTILITY EXPIRATION DATE 12/02/2014 TRAVIS COUNTY FIRE MARSHALL AWU PRE LINE ENGINEERING AWU PRE LINE ENGINEERING AWU FACILITIES ENGINEERING AWU FACILITIES ENGINEERING TEXAS DEPARTMENT OF TRANSPORTATION TEXAS DEPARTMENT OF TRANSPORTATION AWU S20141002165640 AWU MO MO TEXAS DEPARTMENT OF TRANSPORTATION AWU S20141002165640 AWU MO AWU MO TEXAS DEPARTMENT OF TRANSPORTATION AWU S20141002165640 AWU MO AWU MO AWU TEXAS DEPARTMENT OF TRANSPORTATION TEXAS DEPARTMENT OF TRANSPORTATION AWU MO AWU TEXAS DEPARTMENT OF TRANSPORTATION AWU TEXAS DEPARTMENT OF TRANSPORTATION AWU AWU TEXAS DEPARTMENT OF TRANSPORTATION AWU AWU AWU AWU AWU AWU AWU AWU	' = 10,00	HORIZONIAL SCALE: 1 = VERTICAL SCALE: 1" =				1	
PHY OF AUSTIN DEVELOPMENT PERMIT NUMBER AUSTIN WATER UTILITY Image: Construction date 2/02/2014 TRAVIS COUNTY FIRE MARSHALL JAN 20 2018 DATE DATE AWU PACILITIES ENGINEERING DATE Jan 20/018 DATE AWU FACILITIES ENGINEERING DATE Jan 20/018 DATE TEXAS DEPARTMENT OF TRANSPORTATION UIR NUMBER DATE Jane TEXAS DEPARTMENT OF TRANSPORTATION UIR NUMBER DATE Jane COVER SH TEXAS DEPARTMENT OF TRANSPORTATION UIR NUMBER DATE Jane COVER SH TEXAS DEPARTMENT OF TRANSPORTATION OII-14-384953-DP DATE Jane COVER SH TAM Work OII-14-384953-DP Jane 12/n/m Cover Sh TAM Work GOVERNEE COMPLIANCE WITH APP							E
AUSTIN WATER UTILITY EXPIRATION DATE 12/02/2014 TRAVIS COUNTY FIRE MARSHALL, JAN 20 2018 TRAVIS COUNTY FIRE MARSHALL, JAN 20 2018 AWU PARE LINE ENGINEERING AWU FACILITIES ENGINEERING AWU FACILITIES ENGINEERING AWU FACILITIES ENGINEERING TEXAS DEPARTMENT OF TRANSPORTATION TEXAS DEPARTMENT OF TRANSPORTATION OII-14-34453-DP OII-14-34452-DP OIII-14-34452-DP OIII-14-34452-DP OIII-14-34452-							, Ś.
TRAVIS COUNTY FIRE MARSHALL JAN 20 2018 Date Correcture Date Date AWU PAPE LINE ENGINEERING Date Date AWU SACILITIES ENGINEERING Date Date TEXAS DEPARTMENT OF TRANSPORTATION UIR NUMBER Date Date TEXAS DEPARTMENT OF TRANSPORTATION UIR NUMBER Date Date TEXAS DEPARTMENT OF TRANSPORTATION UIR NUMBER Date Date JUM Mom Date Date Date JUM Mom Date Date Date JUM Mom DI-14-34153-DP Date Date Date JAM Work OI-14-34153-DP Date Date 12/n/m COVER SH Approval of These Plans By THE CITY OF AUSTIN INDICATES COMPLIANCE WITH APPLICABLE CITY REGULATIONS ONLY. APPROVAL BY OTHER GOVERNMENT ENTITIES MAY BE REQUIRED PRIOR TO THE START OF AUSTIN APPROVED Mo 1 JAN 22 2015 JUN 10 2015 JUN 10 2015 OF 113 0F 13	E	ARKE			AUSTIN W	J	
AWU PARE LINE ENGINEERING FO/O M 1/20/15 AWU FACILITIES ENGINEERING DATE AWU FACILITIES ENGINEERING DATE AWU FACILITIES ENGINEERING DATE TEXAS DEPARTMENT OF TRANSPORTATION UIR NUMBER AUS 2014/1202165640 DATE JAM W Mown 12/n/14 TEXAS DEPARTMENT OF TRANSPORTATION 011-14-34452-DP JAM W Mown 011-14-34452-DP JAN 22 2015 JUN 10 2015 OF CONSTRUCTION. THE APPLICANT IS RESPONSIBLE FOR DETERMINING WHAT ADDITIONAL APPROVALS MAY JAN 22 2015 JUN 10 2015 JAN 22 2015 JUN 10 2015 OF TY OF AUSTIN OTY OF AUSTIN		NORTH	1.02/2014		17 18	V	-
AWU PIPE LINE ENGINEERING AWU FACILITIES ENGINEERING AWU FACILITIES ENGINEERING TEXAS DEPARTMENT OF TRANSPORTATION TEXAS DEPARTMENT OF TRANSPORTATION TEXAS DEPARTMENT OF TRANSPORTATION TEXAS DEPARTMENT OF TRANSPORTATION TEXAS DEPARTMENT OF TRANSPORTATION TH4 - 344153 - DP OII - 14 - 2	MUMS	COLDOMINI	ral a la la	20		_	
AWU FACILITIES ENGINEERING	f i i			16000		┠	
TEXAS DEPARTMENT OF TRANSPORTATION UIR NUMBER AUS 2014/1002165640 DATE TEXAS DEPARTMENT OF TRANSPORTATION DIT-14-34453-DP DATE TEXAS DEPARTMENT OF TRANSPORTATION DIT-14-34453-DP DATE TEXAS DEPARTMENT OF TRANSPORTATION DIT-14-34453-DP DATE Amy W More 011-14-34453-DP DATE Amy W More 011-14-34452-DP DATE Approval of These Plans By THE CITY OF AUSTIN INDICATES COMPLIANCE WITH APPLICABLE CITY PREGULATIONS ONLY. APPROVAL BY OTHER GOVERNMENT ENTITIES MAY BE REQUIRED PRIOR TO THE START OF CONSTRUCTION. THE APPLICANT IS RESPONSIBLE FOR DETERMINING WHAT ADDITIONAL APPROVALS MAY MAY BE NECESSARY. City of Austin APPROVED JAN 22 2015 JUN 10 2015 JUN 10 2015 Reviewed for General Compliance CITY OF AUSTIN OTY OF AUSTIN	а 1915 — 1916 — 1917 — 1917 — 1917 — 1917 — 1917 — 1917 — 1917 — 1917 — 1917 — 1917 — 1917 — 1917 — 1917 — 1917 —						
TEXAS DEPARTMENT OF TRANSPORTATION UR NUMBER AUS 2014/10/22/65640 TEXAS DEPARTMENT OF TRANSPORTATION TEXAS DEPARTMENT OF TRANSPORTATION Momenal Momenal TEXAS DEPARTMENT OF TRANSPORTATION Momenal				,	WU FACILITIES ENGINEERING	Γ	
Aus 2014/1002/65640 12/1/14 COVER SI TEXAS DEPARTMENT OF TRANSPORTATION DRIVEWAY DATE Jame W Mom 011-14-344/53-0P DATE Jame W Mom 011-14-344/53-0P 12/1/14 *APPROVAL OF THESE PLANS BY THE CITY OF AUSTIN INDICATES COMPLIANCE WITH APPLICABLE CITY 12/1/14 COVER SI *APPROVAL OF THESE PLANS BY THE CITY OF AUSTIN INDICATES COMPLIANCE WITH APPLICABLE CITY 12/1/14 COVER SI *APPROVAL OF THESE PLANS BY THE CITY OF AUSTIN INDICATES COMPLIANCE WITH APPLICABLE CITY 12/1/14 COVER SI *APPROVAL OF THESE PLANS BY THE CITY OF AUSTIN INDICATES COMPLIANCE WITH APPLICABLE CITY 12/1/14 COVER SI *APPROVAL OF THESE PLANS BY THE CITY OF AUSTIN AUSTING WHAT ADDITIONAL APPROVALS MAY 12/1/14 BE NECESSARY. City of Austin APPROVED Mo 1 JAN 22 2015 JUN 10 2015 JUN 10 2015 OF 13 Reviewed for General Compliance CITY OF AUSTIN OTY OF AUSTIN OF 13		an a		RNI	EXAS DEPARTMENT OF TRANSPORTATION	_	
IEXAS DEPARTMENT OF TRANSPORTATION OII - 14 - 34453 - DP DATE *APPROVAL OF THESE PLANS BY THE CITY OF AUSTIN INDICATES COMPLIANCE WITH APPLICABLE CITY 12/n/m *APPROVAL OF THESE PLANS BY THE CITY OF AUSTIN INDICATES COMPLIANCE WITH APPLICABLE CITY 11 - 14 - 34452 - DP 12/n/m *APPROVAL OF THESE PLANS BY THE CITY OF AUSTIN INDICATES COMPLIANCE WITH APPLICABLE CITY 12 / n/m 14 - 34452 - DP 12 / n/m *APPROVAL OF THESE PLANS BY THE CITY OF AUSTIN INDICATES COMPLIANCE WITH APPLICABLE CITY Frequencial Compliance 14 - 34452 - DP 12 / n/m *APPROVAL SOLUTION. THE APPLICANT IS RESPONSIBLE FOR DETERMINING WHAT ADDITIONAL APPROVALS MAY 10 - 0015 11 - 0015 BE NECESSARY. City of Austin APPROVED 10 - 0015 11 - 0015 JAN 22 2015 JUN 10 2015 OF 13 0F 13	uee.		40	202	AUS 20141		
Image W Mong OIT-14-34452-DP 12/1/4 *APPROVAL OF THESE PLANS BY THE CITY OF AUSTIN INDICATES COMPLIANCE WITH APPLICABLE CITY REGULATIONS ONLY. APPROVAL BY OTHER GOVERNMENT ENTITIES MAY BE REQUIRED PRIOR TO THE START OF CONSTRUCTION. THE APPLICANT IS RESPONSIBLE FOR DETERMINING WHAT ADDITIONAL APPROVALS MAY BE NECESSARY. City of Austin JAN 22 2015 JUN 10 2015 JUN 10 2015 Reviewed for General Compliance CITY OF AUSTIN		LOVER SH	DATE	RIVEN	EXAS DEPARTMENT OF TRANSPORTATION		
REGULATIONS ONLY. APPROVAL BY OTHER GOVERNMENT ENTITIES MAY BE REQUIRED PRIOR TO THE START OF CONSTRUCTION. THE APPLICANT IS RESPONSIBLE FOR DETERMINING WHAT ADDITIONAL APPROVALS MAY BE NECESSARY. City of Austin JAN 22 2015 H/ Reviewed for General Compliance CITY OF AUSTIN CITY OF AUSTIN				457	Lang W Mon 011-14-32	-[
OF CONSTRUCTION. THE APPLICANT IS RESPONSIBLE FOR DETERMINING WHAT ADDITIONAL APPROVALS MAY DE NECESSARY. City of Austin JAN 22 2015 // Reviewed for General Compliance CITY OF AUSTIN			BE REQUIRED PRIOR TO THE START	TITIE	REGULATIONS ONLY. APPROVAL BY OTHER GOVERNMENT EN		
JAN 22 2015 K/ JUN 1 0 2015 Reviewed for General Compliance CITY OF AUSTIN			WHAT ADDITIONAL APPROVALS MAY	ETER	OF CONSTRUCTION. THE APPLICANT IS RESPONSIBLE FOR D		
Reviewed for General Compliance CITY OF AUSTIN		1	HUVELLOUX	1			
Reviewed for General Compliance CITY OF AUSTIN			1 0 2015	ar Ar an Ar an	JAN 22 2015 4		
	16	OIF 136			Reviewed for General Compliance		
DEVELOPMENT SERVICES COA CASE NO: SP-2014-0	0400). SD_2044 A		DE			

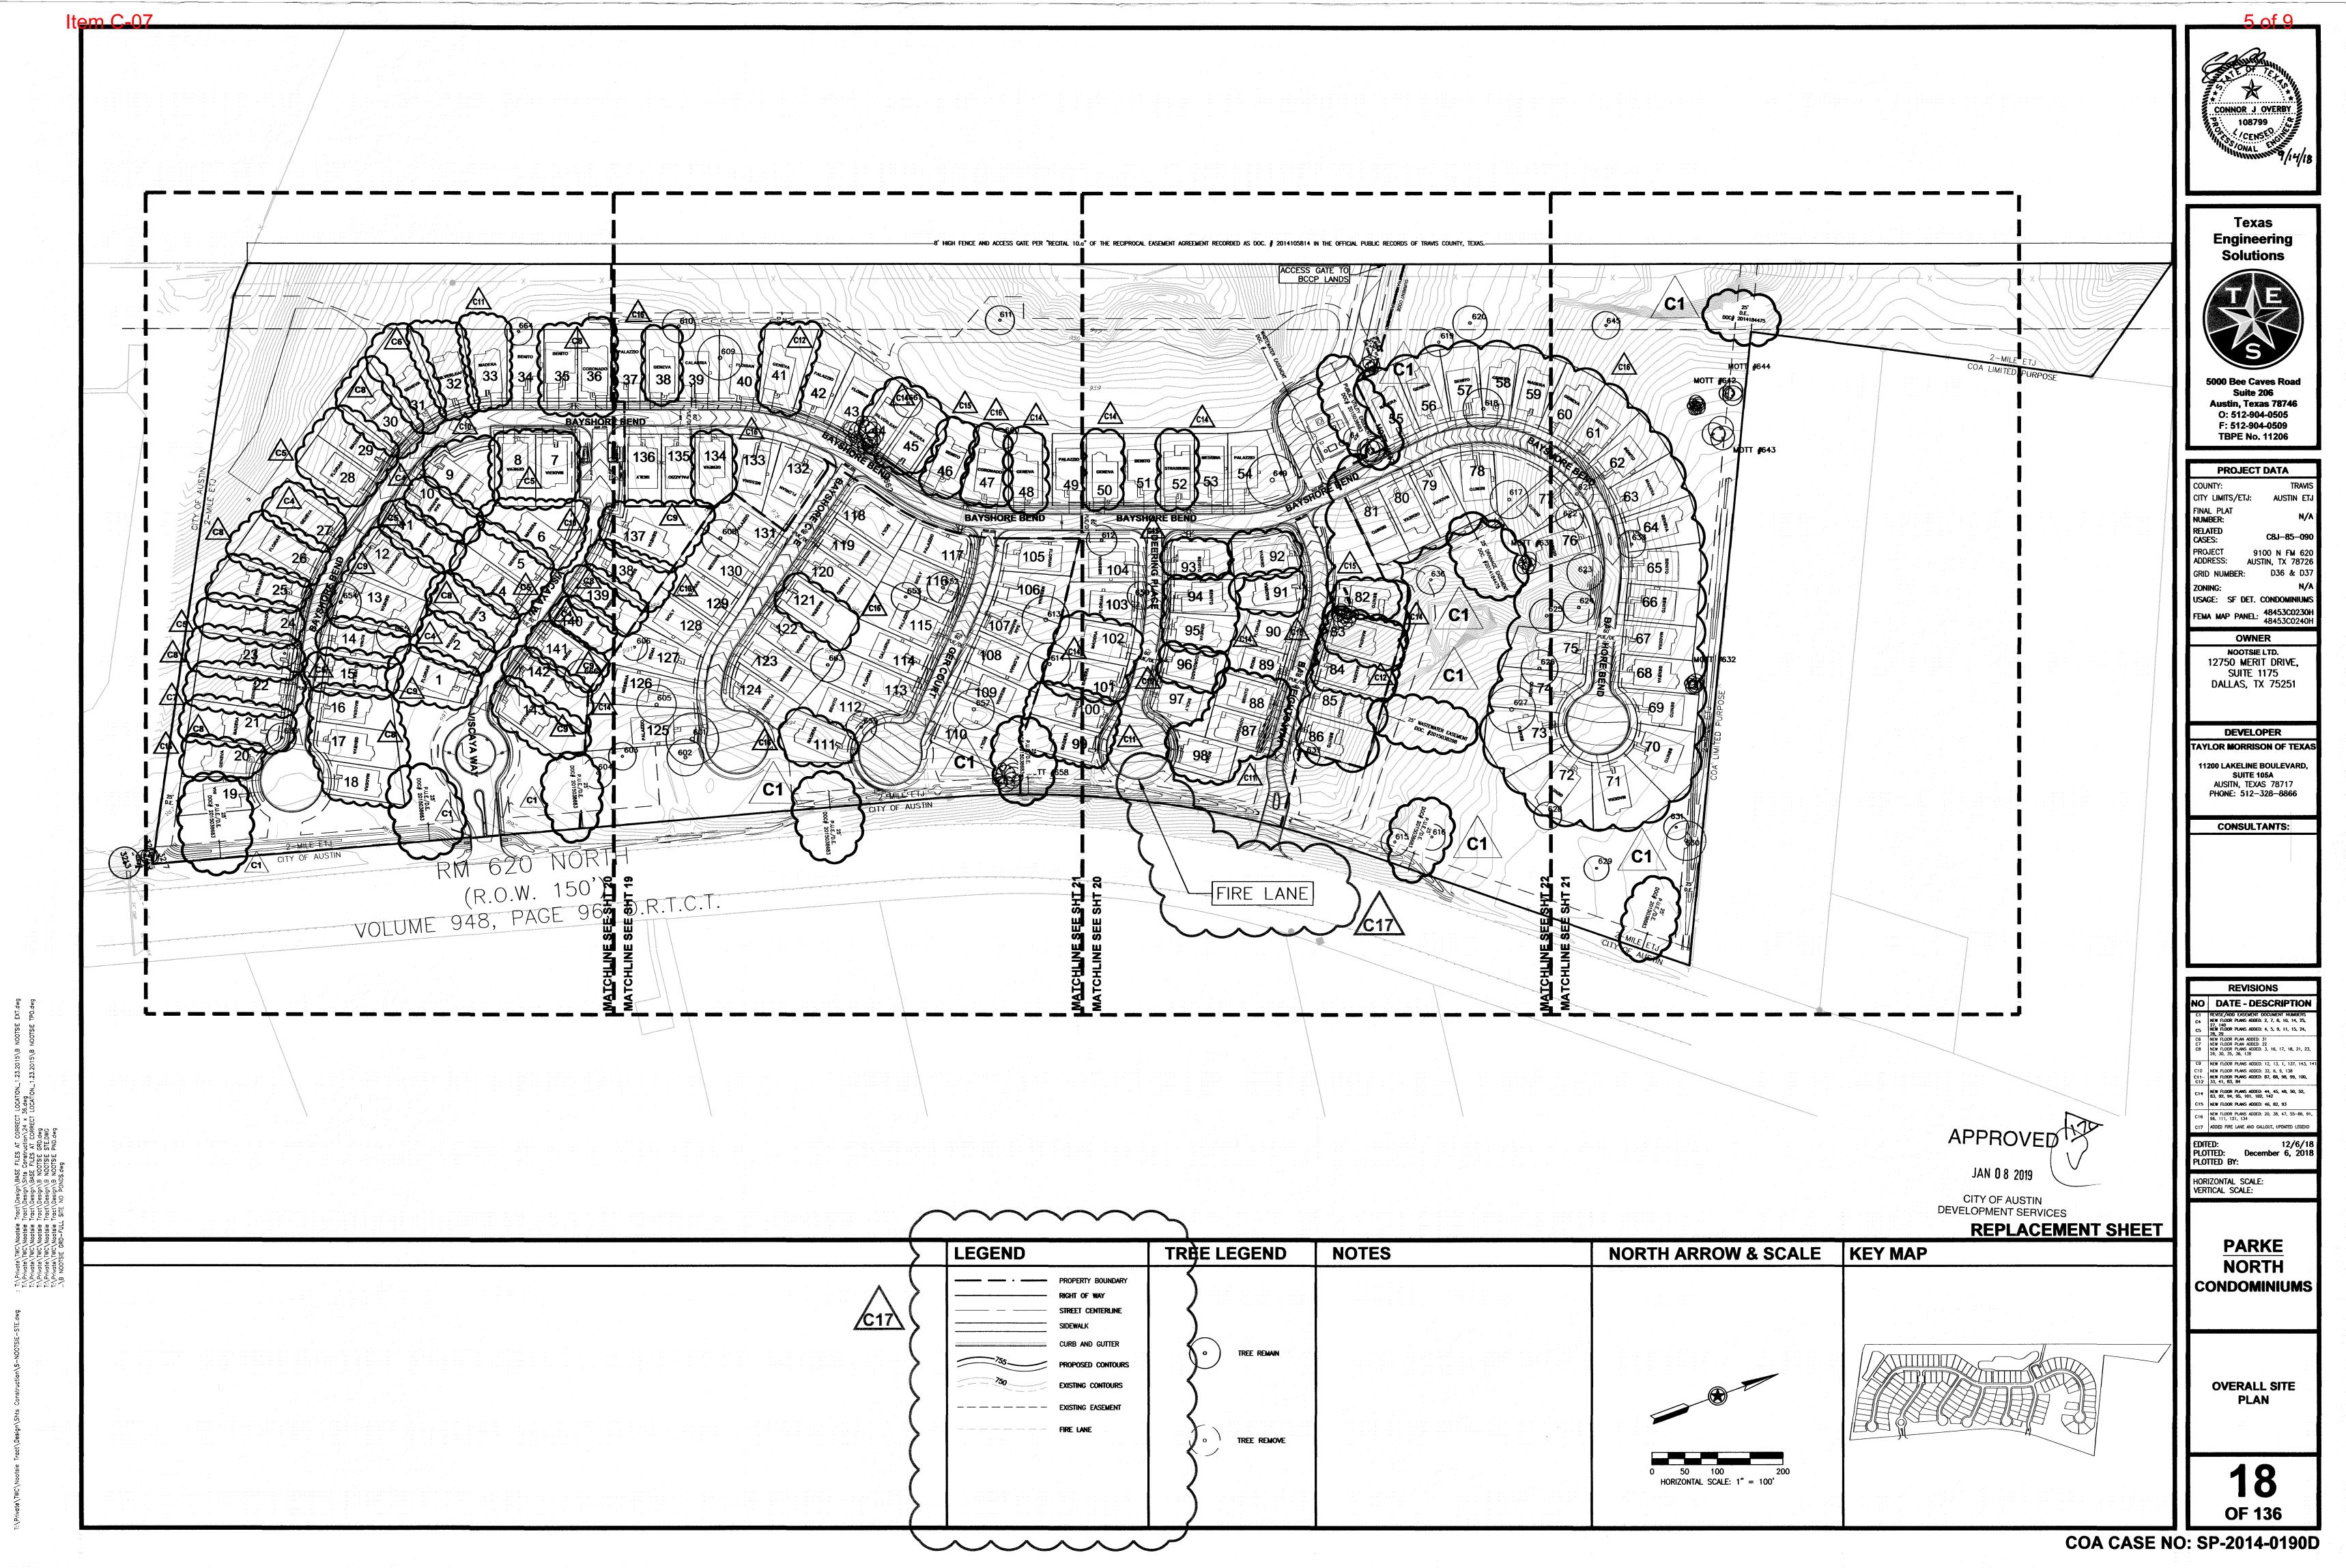


			ار این میں اور اور میں میں میں ایک اور		ير المراجع من المراجع وي التي ويرو المراجع المراجع أن التي وي التي ويرو
	LEGEND	TR	ÈE LEGEND	NOTES	NOR
<u>C17</u>	PROPERTY BOUNDARY RIGHT OF WAY STREET CENTERLINE SIDEWALK				
	CURB AND GUTTER CURB AND GUTTER PROPOSED CONTOURS 750 EXISTING CONTOURS		• TREE REMAIN		
	EXISTING EASEMENT	: 	• TREE REMOVE		

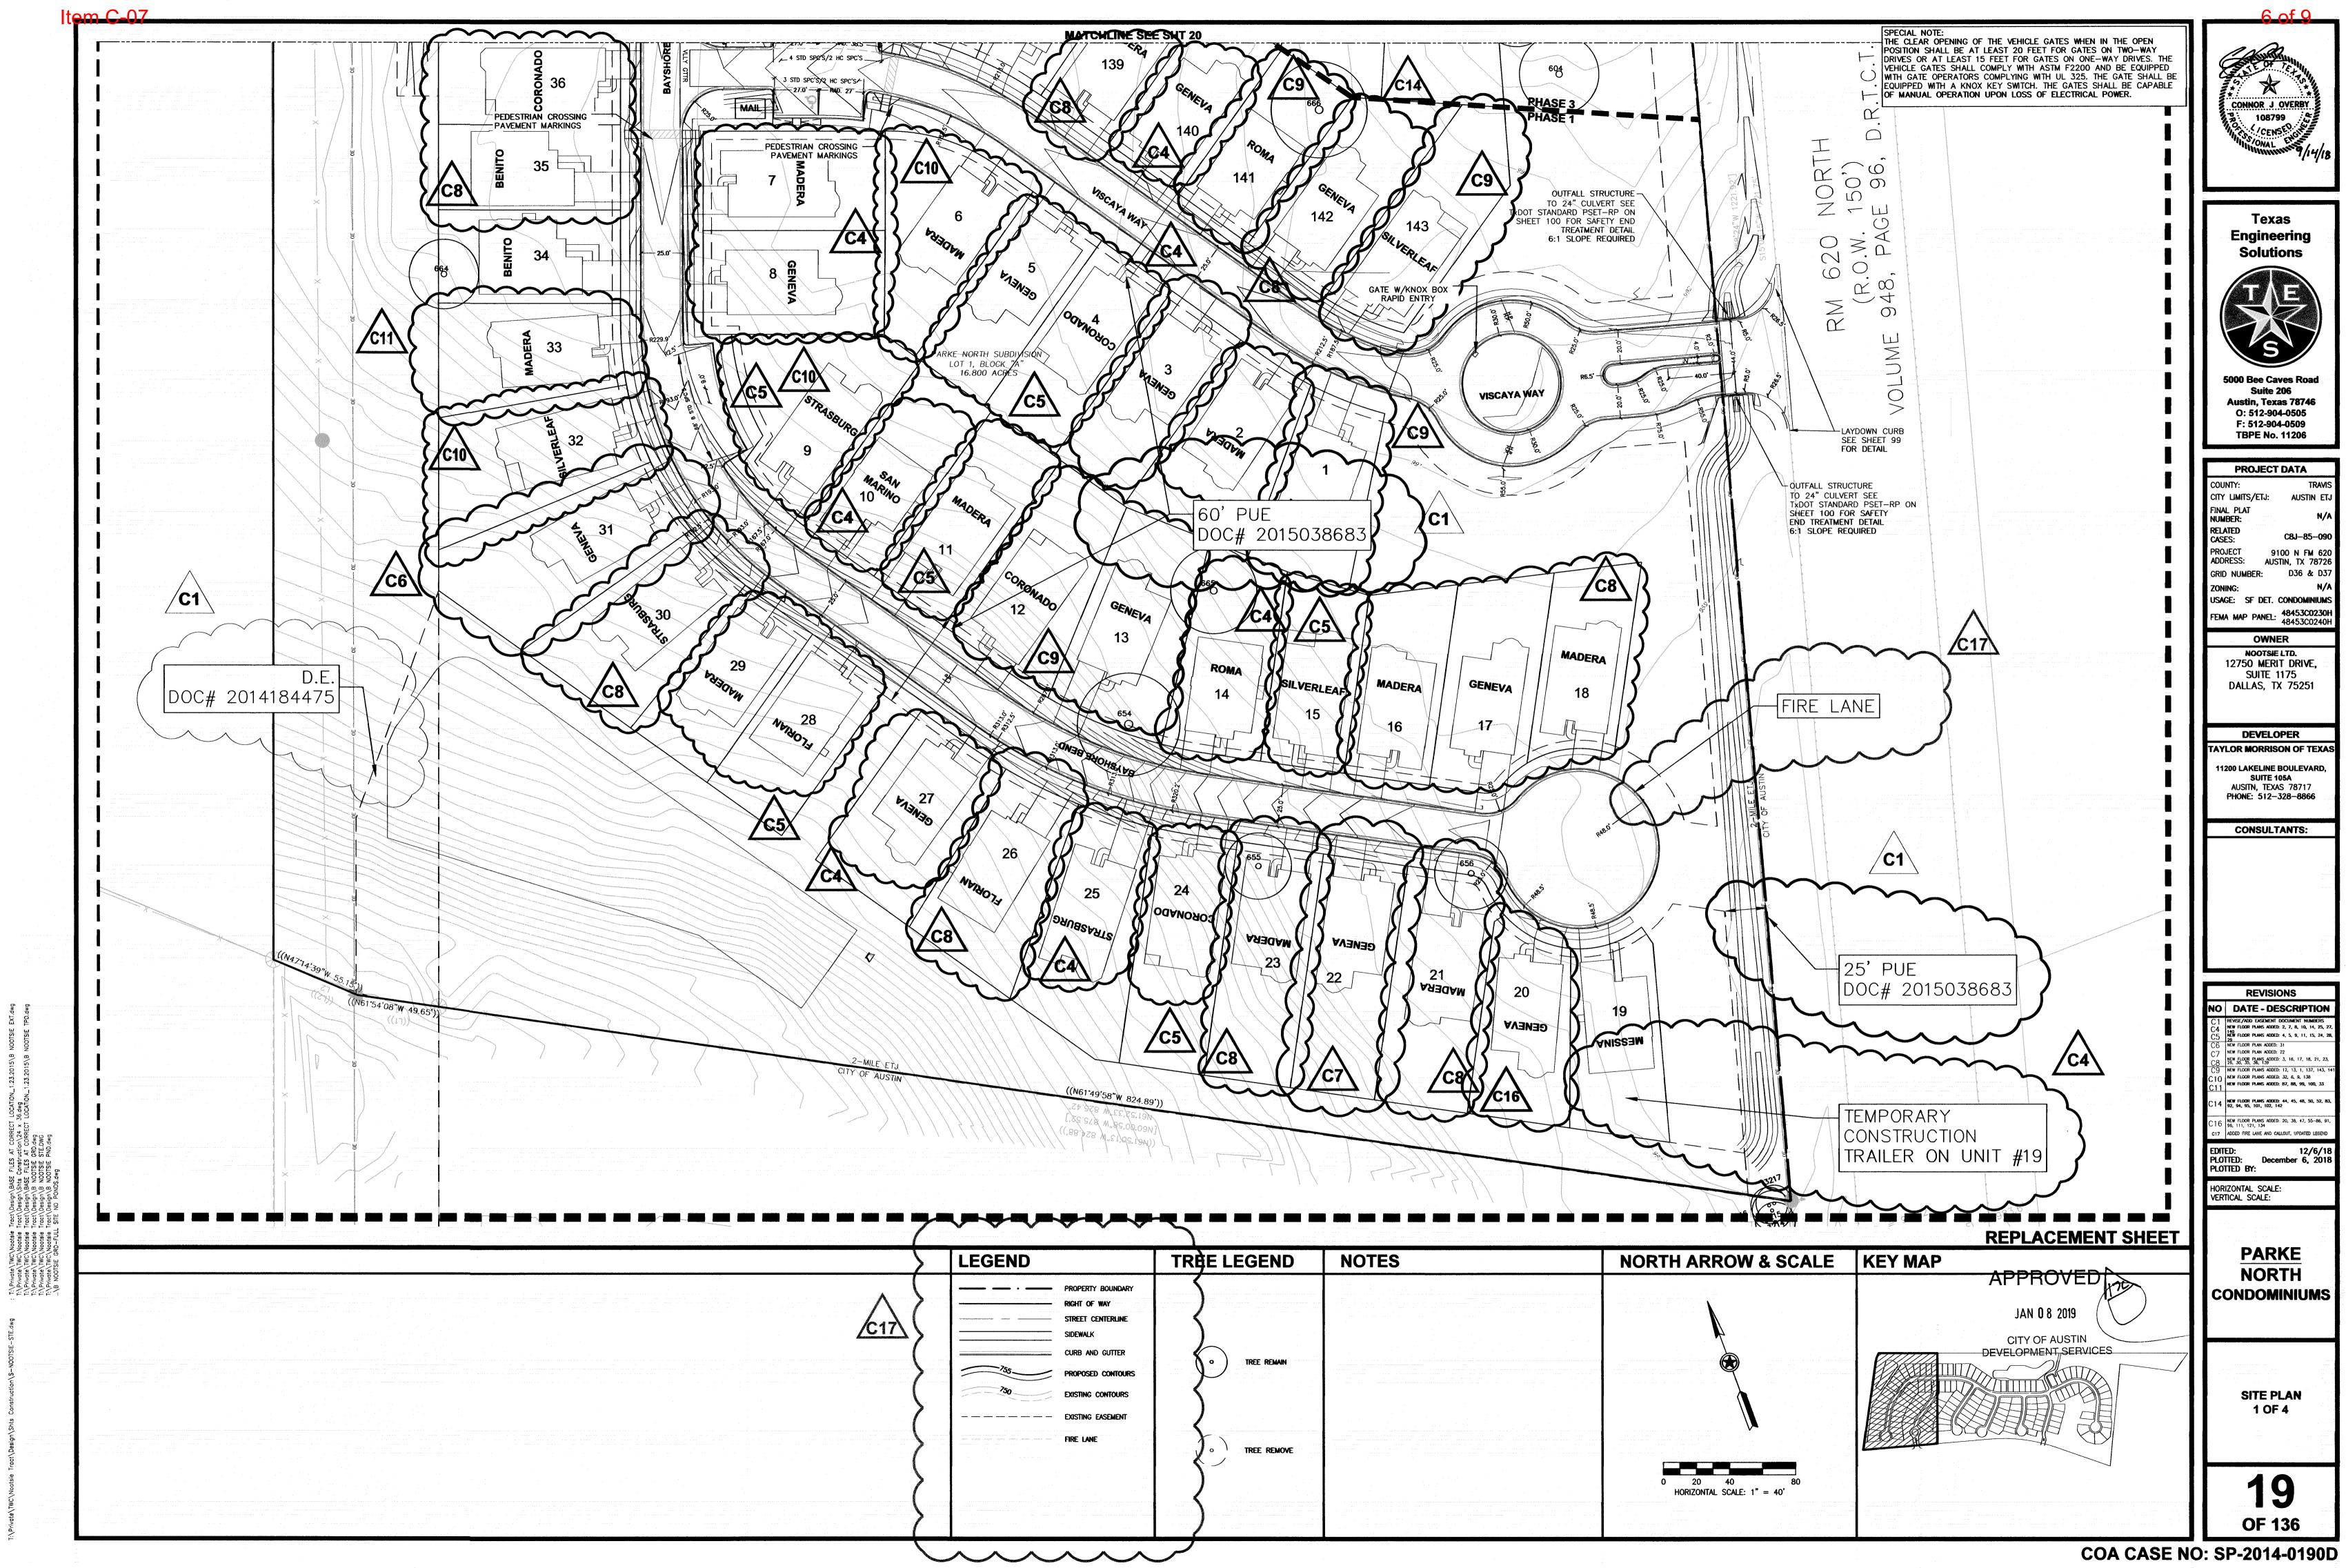

1				· · · · · · · · · · · · · · ·
$\boldsymbol{\boldsymbol{\succ}}$	LEGEND	TREE LEGEND	NOTES	NOR
	PROPERTY BOUNDARY RIGHT OF WAY STREET CENTERLINE SIDEWALK CURB AND GUTTER			
	EXISTING CONTOURS			
		CONTREE REMOVE		



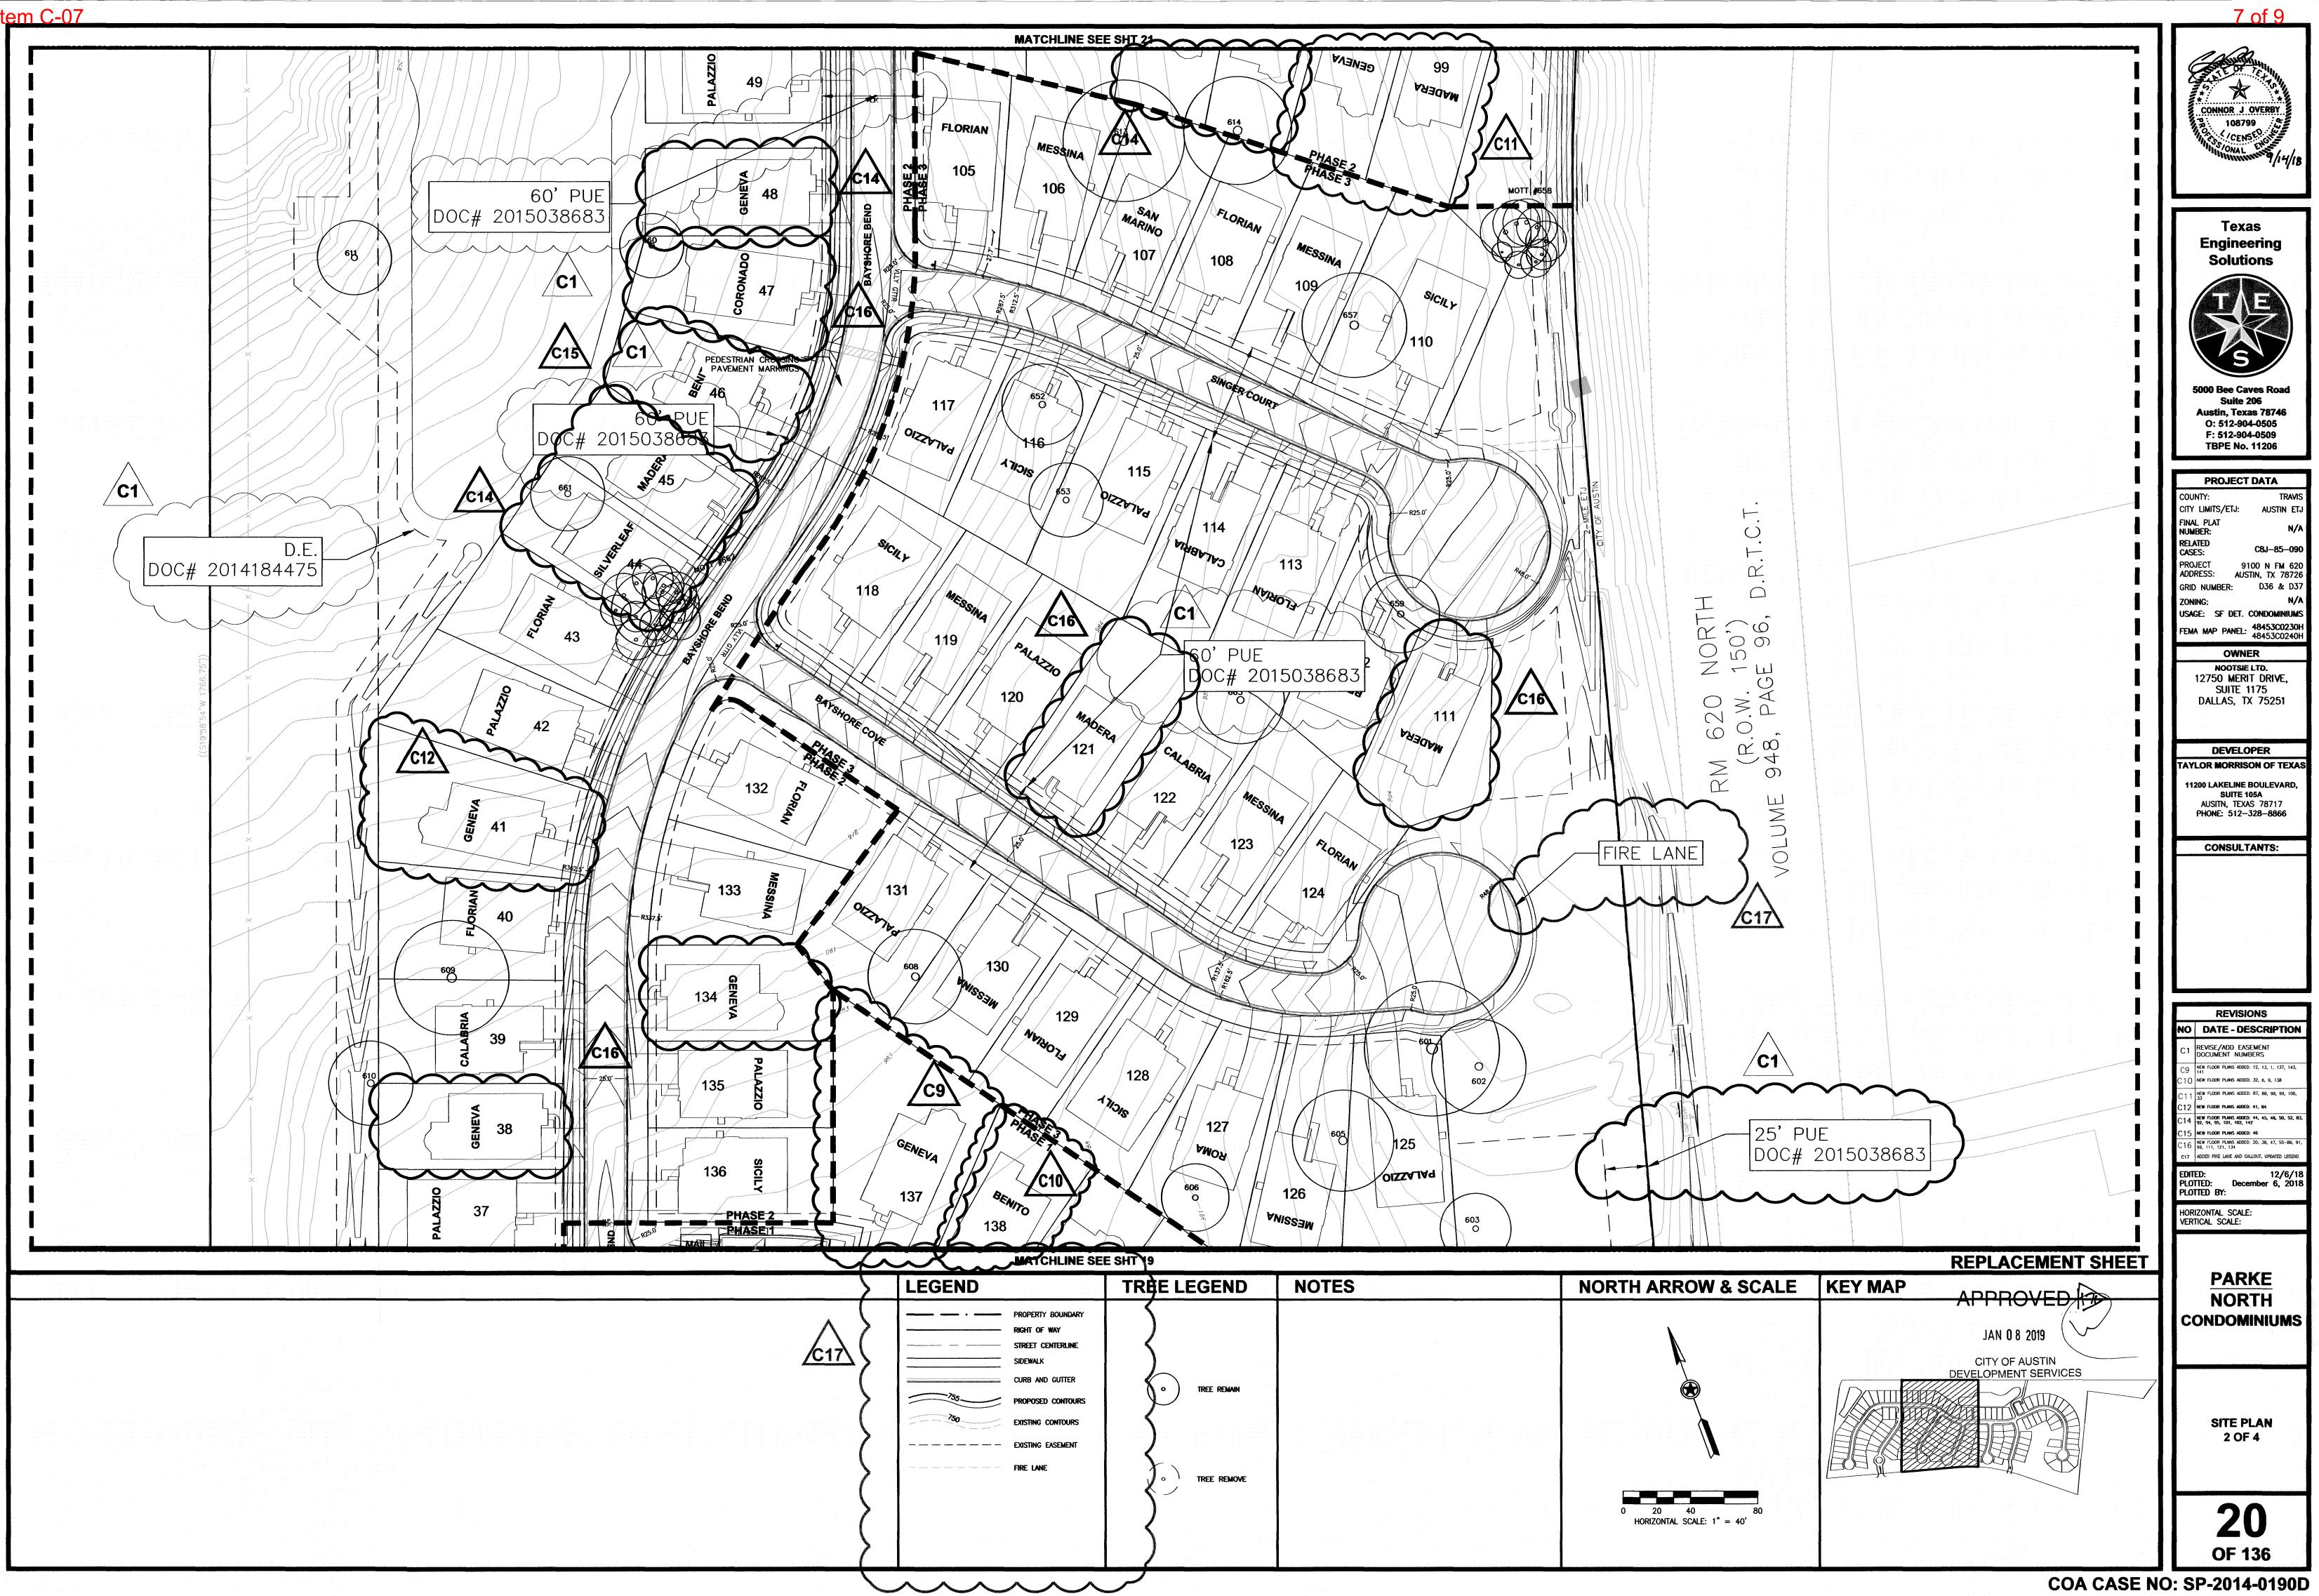



EXT.dwg TPO.dwg

NOOTSIE

15\B 5\B

T:\Private\TWC\Nootsie Tract\Design\BASE FILES AT CORRECT LOCATION_1.23. T:\Private\TWC\Nootsie Tract\Design\Shts Construction\24 × 36.dwg T:\Private\TWC\Nootsie Tract\Design\BASE FILES AT CORRECT LOCATION_1.23. T:\Private\TWC\Nootsie Tract\Design\B NOOTSIE GRD.dwg T:\Private\TWC\Nootsie Tract\Design\B NOOTSIE GRD.dwg T:\Private\TWC\Nootsie Tract\Design\B NOOTSIE PND.dwg T:\Private\TWC\Nootsie Tract\Design\B NOOTSIE PND.dwg T:\Private\TWC\Nootsie Tract\Design\B NOOTSIE PND.dwg

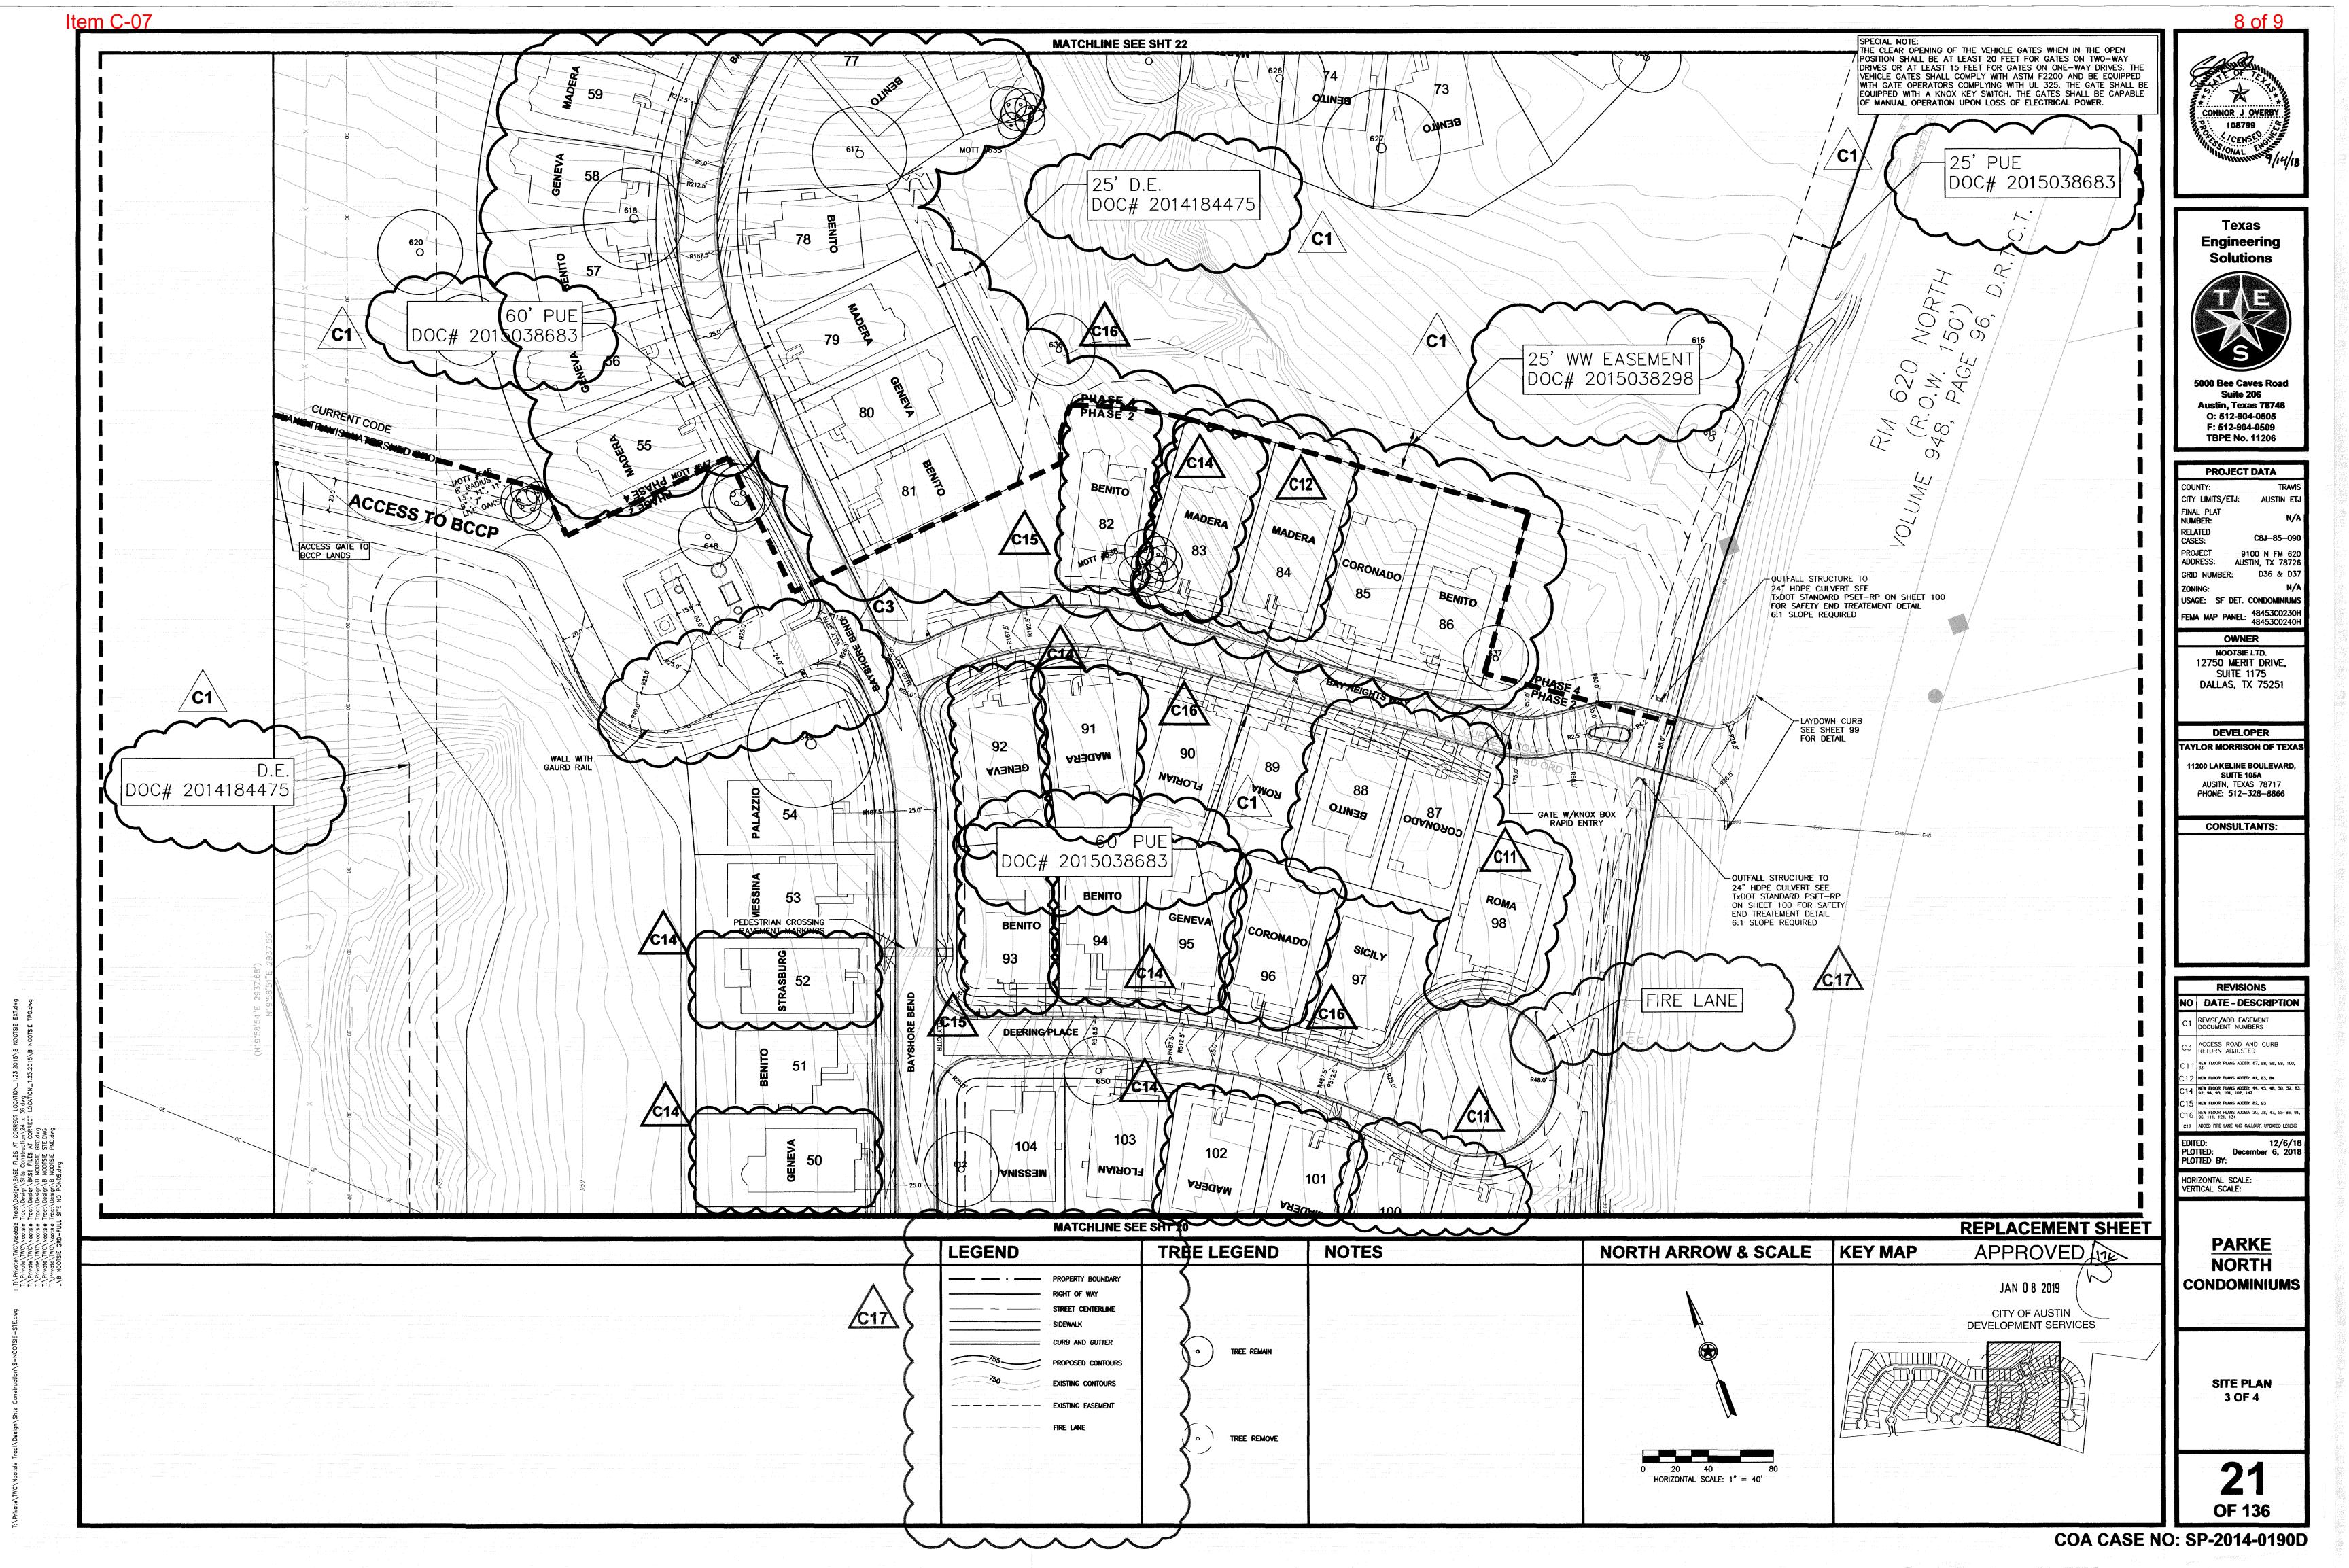

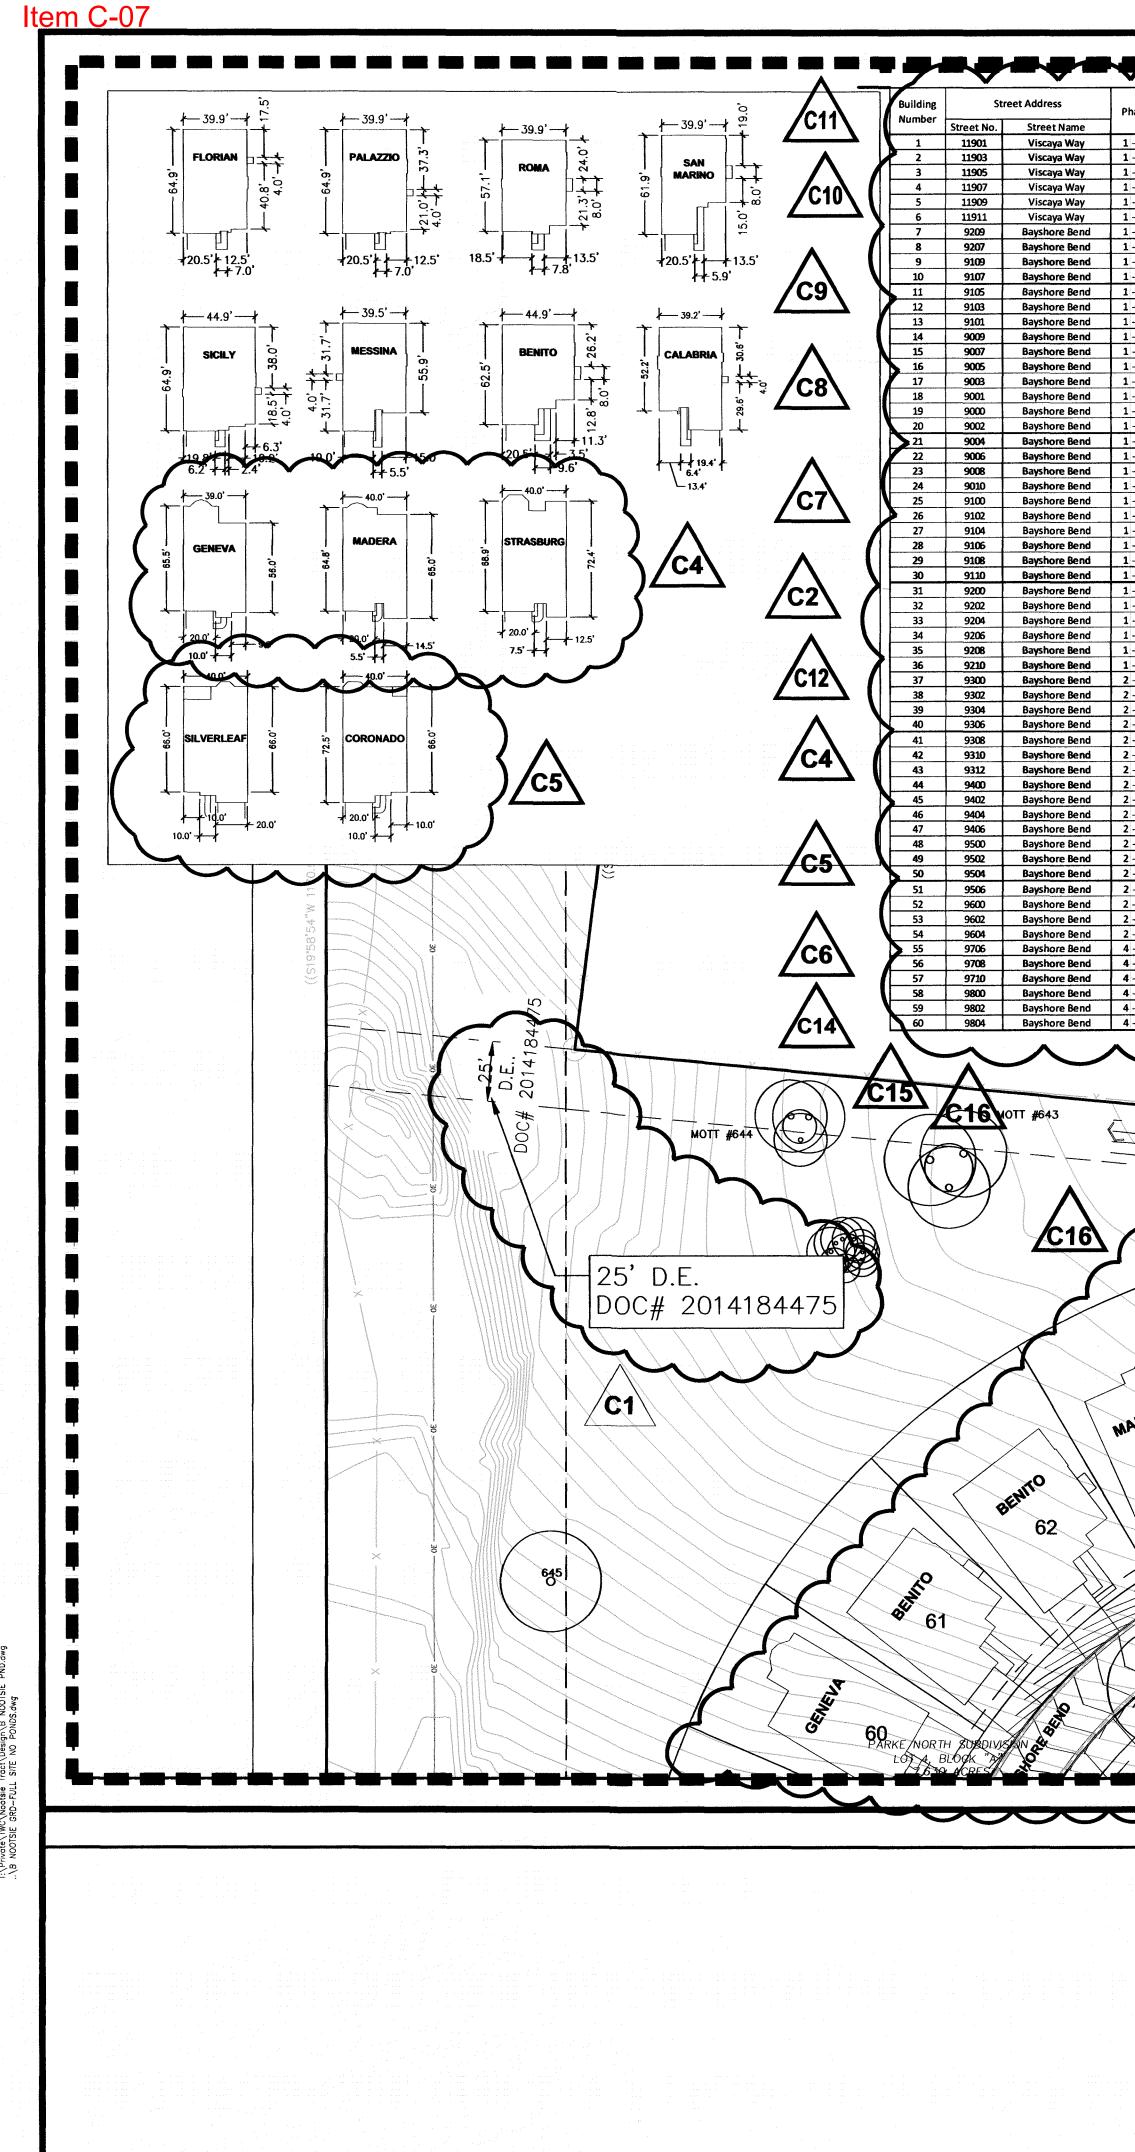

T:\Private\TWC\Nootsie Tract\Design\BASE FILES AT CORRECT LOCATION_1.23.2015\B NOOTSIE EXT.dwg T:\Private\TWC\Nootsie Tract\Design\Shts Construction\24 × 36.dwg T:\Private\TWC\Nootsie Tract\Design\BASE FILES AT CORRECT LOCATION_1.23.2015\B NOOTSIE TPO.dwg T:\Private\TWC\Nootsie Tract\Design\B NOOTSIE GR0.dwg T:\Private\TWC\Nootsie Tract\Design\B NOOTSIE GR0.dwg T:\Private\TWC\Nootsie Tract\Design\B NOOTSIE GR0.dwg T:\Private\TWC\Nootsie Tract\Design\B NOOTSIE PND.dwg T:\Private\TWC\Nootsie Tract\Design\B NOOTSIE PND.dwg T:\Private\TWC\Nootsie Tract\Design\B NOOTSIE PND.dwg

					9 of 9
	PhaseNorth or South TractFloorplan TypeDriveway SideBuilding Coverage (Left or Right)Flatwork IC (Square Feet)Driveway IC (Square Feet)Total Impervious Cover (sf)1 - 1SouthFlorianRight2,6924225753,6891 - 2SouthMaderaLeft2,7964864323,7141 - 3SouthGenevaRight2,7512514273,4291 - 4SouthCoronadoLeft2,6361203493,1051 - 5SouthGenevaRight2,7512514163,4181 - 6SouthMaderaRight2,7964864593,7411 - 7SouthMaderaRight2,7964864593,7411 - 8SouthGenevaRight2,7964864593,7411 - 8SouthGenevaRight2,7964864593,7411 - 8SouthGenevaRight3,023605253,6081 - 9SouthStrasburgRight3,023605253,6081 - 10SouthSan MarinoLeft2,7964865873,8691 - 11SouthMaderaLeft2,7964865873,8691 - 12SouthCoronadoRight2,6361953233,1541 - 13SouthGenevaLeft2,751546708 <th>Building NumberStreet AddressPhaseNorth or South TractFloorplan TypeImage: Complex co</th> <th>Building SideFlatwork IC (Square Feet)Driveway IC (Square Feet)Total Impervious Cover (st)Building NumberStreet AddressPhaseNort SouthLeft2,2251204482,79312111910Bayshore Cove3 - 121SouLeft2,225784482,77312211908Bayshore Cove3 - 122SouRight2,820754553,35012311906Bayshore Cove3 - 123SouLeft2,751746003,42512411904Bayshore Cove3 - 123SouRight2,225784482,75112511901Bayshore Cove3 - 125SouRight2,225784482,79612611903Bayshore Cove3 - 125SouRight2,2251234482,79612611903Bayshore Cove3 - 125SouLeft2,820744553,34912711905Bayshore Cove3 - 128SouLeft2,2251266523,00312911909Bayshore Cove3 - 128SouLeft2,225784482,75113011911Bayshore Cove3 - 128SouLeft2,225784482,75113011911Bayshore Cove3 - 128SouLeft2,225784482,75113011911Bayshore Cove3 - 129Sou</th> <th>h or TractFloorplan TypeDriveway Side (Left or Right)Building Coverage (Square Feet)Platwork IC (Square Feet)Driveway IC (Square Feet)Total Impervious Cover (sf)uthMaderaRight2,892434593,394uthCalabriaLeft2,4951266303,251uthMessinaRight2,6201206443,384uthFlorianLeft2,692786183,388uthPalazzioRight2,6201201,2954,035uthPalazzioRight2,6201201,2954,035uthRomaLeft2,217759153,207uthSicilyRight2,931716763,678uthFlorianLeft2,6201204503,190uthFlorianLeft2,6201204503,239uthPalazzioRight2,6201205653,305uthPalazzioRight2,605294533,087uthGenevaRight2,605294533,087uthGenevaRight2,605294533,087uthPalazzioLeft2,715745403,329</th> <th>Texas Engineering</th>	Building NumberStreet AddressPhaseNorth or South TractFloorplan TypeImage: Complex co	Building SideFlatwork IC (Square Feet)Driveway IC (Square Feet)Total Impervious Cover (st)Building NumberStreet AddressPhaseNort SouthLeft2,2251204482,79312111910Bayshore Cove3 - 121SouLeft2,225784482,77312211908Bayshore Cove3 - 122SouRight2,820754553,35012311906Bayshore Cove3 - 123SouLeft2,751746003,42512411904Bayshore Cove3 - 123SouRight2,225784482,75112511901Bayshore Cove3 - 125SouRight2,225784482,79612611903Bayshore Cove3 - 125SouRight2,2251234482,79612611903Bayshore Cove3 - 125SouLeft2,820744553,34912711905Bayshore Cove3 - 128SouLeft2,2251266523,00312911909Bayshore Cove3 - 128SouLeft2,225784482,75113011911Bayshore Cove3 - 128SouLeft2,225784482,75113011911Bayshore Cove3 - 128SouLeft2,225784482,75113011911Bayshore Cove3 - 129Sou	h or TractFloorplan TypeDriveway Side (Left or Right)Building Coverage (Square Feet)Platwork IC (Square Feet)Driveway IC (Square Feet)Total Impervious Cover (sf)uthMaderaRight2,892434593,394uthCalabriaLeft2,4951266303,251uthMessinaRight2,6201206443,384uthFlorianLeft2,692786183,388uthPalazzioRight2,6201201,2954,035uthPalazzioRight2,6201201,2954,035uthRomaLeft2,217759153,207uthSicilyRight2,931716763,678uthFlorianLeft2,6201204503,190uthFlorianLeft2,6201204503,239uthPalazzioRight2,6201205653,305uthPalazzioRight2,605294533,087uthGenevaRight2,605294533,087uthGenevaRight2,605294533,087uthPalazzioLeft2,715745403,329	Texas Engineering
	1 - 16 South Madera Left 2,796 486 428 3,710 1 - 17 South Geneva Right 2,751 251 608 3,610 1 - 18 South Madera Right 2,796 486 421 3,703 1 - 19 South Messina Right 2,620 120 369 3,109 1 - 20 South Geneva Left 2,608 28 664 3,300 1 - 21 South Madera Right 2,796 486 671 3,953 1 - 22 South Geneva Right 2,751 251 441 3,443 1 - 23 South Madera Left 2,636 120 349 3,105 1 - 24 South Coronado Left 2,636 120 349 3,105 1 - 25 South Florian Left 2,692 78 646 3,416 1 - 27	769811Bayshore Bend4 - 76NorthGeneva779807Bayshore Bend4 - 77NorthBenito789709Bayshore Bend4 - 78NorthBenito799707Bayshore Bend4 - 79NorthMadera809705Bayshore Bend4 - 80NorthGeneva819703Bayshore Bend4 - 81NorthBenito8211910Bay Heights Way2 - 82NorthBenito8311908Bay Heights Way2 - 83NorthMadera8411906Bay Heights Way2 - 83NorthMadera8511904Bay Heights Way2 - 85NorthBenito8611902Bay Heights Way2 - 86NorthBenito8711903Bay Heights Way2 - 87SouthCoronado8811905Bay Heights Way2 - 88SouthBenito8911907Bay Heights Way2 - 89SouthRoma9011909Bay Heights Way2 - 90SouthFlorian9111911Bay Heights Way2 - 91SouthGeneva9311910Deering Place2 - 93SouthBenito9411908Deering Place2 - 94SouthBenito9511906Deering Place2 - 95SouthGeneva9611904Deering Place2 - 97SouthSicily	Left 2,751 71 600 3,422 136 9301 Bayshore Bend 2 - 136 Sou Right 2,225 74 448 2,747 137 11912 Viscaya Way 1 - 137 Sou Right 2,225 123 448 2,796 138 11910 Viscaya Way 1 - 138 Sou Right 2,225 123 448 2,796 138 11910 Viscaya Way 1 - 139 Sou Right 2,225 78 448 2,751 141 11906 Viscaya Way 1 - 140 Sou Right 2,225 78 448 2,751 141 11902 Viscaya Way 1 - 142 Sou Right 2,920 37 401 3,340 143 11902 Viscaya Way 1 - 142 Sou Right 2,035 33 386 2,454 1900 Viscaya Way 1 - 142 Sou Left 2,058 233	ath GenevaRight Right2,7515156893,955ath BenitoLeft2,225605962,881ath 	Figure 15000 Bee Caves Road Suite 206Austin, Texas 787460: 512-904-0505F: 512-904-0509TBPE No. 11206
	2 - 39 South Calabria Left 2,495 126 432 3,053 2 - 40 South Florian Right 2,692 78 361 3,131 2 - 41 South Geneva Left 2,658 274 429 3,361 2 - 42 South Palazzio Left 2,715 74 545 3,334 2 - 43 South Florian Left 2,692 78 543 3,313 2 - 43 South Florian Left 2,692 78 543 3,313 2 - 44 South Silverleaf Right 2,718 29 386 3,133 2 - 45 South Benito Left 2,068 248 411 2,727 2 - 47 South Geneva Left 2,718 29 408 3,155 2 - 47 South Geneva Left 2,751 29 435 3,215 2 - 48	9911901Deering Place2 - 99SouthMadera10011903Deering Place2 - 100SouthGeneva10111905Deering Place2 - 101SouthMadera10211907Deering Place2 - 102SouthMadera10311909Deering Place2 - 103SouthFlorian10411911Deering Place2 - 104SouthMessina10511910Singer Court3 - 105SouthFlorian10611908Singer Court3 - 106SouthMessina10711906Singer Court3 - 107SouthSan Marino10811904Singer Court3 - 109SouthMessina10911902Singer Court3 - 110SouthMadera11011900Singer Court3 - 110SouthMessina11111901Singer Court3 - 111SouthMadera11211903Singer Court3 - 112SouthBenito11311905Singer Court3 - 113SouthFlorian11411907Singer Court3 - 114SouthCalabria11511909Singer Court3 - 115SouthPalazzio11611911Singer Court3 - 116SouthSicily11711913Singer Court3 - 117SouthPalazzio11811916Bayshore Cove3 - 118SouthSicily<	Right 2,772 219 376 3,367 Roma 1	$ \begin{array}{c ccccccccccccccccccccccccccccccccccc$	CITY LIMITS/ETJ: AUSTIN ETJ FINAL PLAT N/A RELATED CASES: CBJ-85-090 PROJECT 9100 N FM 620 ADDRESS: AUSTIN, TX 78726 GRID NUMBER: D36 & D37 ZONING: N/A USAGE: SF DET. CONDOMINIUMS FEMA MAP PANEL: 48453C0230H 48453C0240H OWNER NOOTSIE LTD. 12750 MERIT DRIVE, SUITE 1175
30 64 65 67 68 C1 25 PUE 25 25 PUE 25 PUE 25 PUE 25 PUE 25 PUE 25 PUE 25 25 PUE 25 PUE 25 PUE 25 PUE 25 PUE 25 PUE 25 25 PUE 25 PUE 25 </td <td>C1 60' PUE DOC# 2015038683 GENEVA BENITO BENITO BENITO</td> <td>DOC# 201418447</td> <td>San Marino 1 0 1 5 5 2 4 Silverleaf 3 1 0 Strasburg 3 1 0</td> <td>$\begin{array}{c c} \hline 0 & 2 \\ \hline 0 & 6 \\ \hline 0 & 4 \\ \hline \end{array}$</td> <td>TAYLOR MORRISON OF TEXAS 11200 LAKELINE BOULEVARD, SUITE 105A AUSITN, TEXAS 78717 PHONE: 512-328-8866</td>	C1 60' PUE DOC# 2015038683 GENEVA BENITO BENITO BENITO	DOC# 201418447	San Marino 1 0 1 5 5 2 4 Silverleaf 3 1 0 Strasburg 3 1 0	$\begin{array}{c c} \hline 0 & 2 \\ \hline 0 & 6 \\ \hline 0 & 4 \\ \hline \end{array}$	TAYLOR MORRISON OF TEXAS 11200 LAKELINE BOULEVARD, SUITE 105A AUSITN, TEXAS 78717 PHONE: 512-328-8866
LEGEND TREE LEGEND NOTES NORTH ARROW & SCALE KEY MAP APPROVED PARKE State contrake		67 68 BAYSHORE BEND 0 75	RABO FIRE LANE	S83 We We G WA G	NO DATE - DESCRIPTION C1 REVISE/ADD EASCMENT DOCUMENT NUMBERS C2 FROMDED LINT ADDRESS/ADDED NEW FLOOR PLANS C4 NEW FLOOR FLANS ADDED: 2, 7, 8, 10, 14, 25, 27, 10 C5 4, 5, 9, 11, 15, 24, 28, 29 C6 NEW FLOOR FLANS ADDED: 2, 7, 8, 10, 14, 25, 27, 10 C7 NEW FLOOR FLAN ADDED: 31 C7 NEW FLOOR FLAN ADDED: 22 C8 CHANCE PHASING DESCHAITON PER EV INSPECTOR NEW FLOOR FLANS ADDED: 21 C1, 13, 132, 143, 141 C10 NEW FLOOR FLANS ADDED: 45, 6, 133 C11 NEW FLOOR FLANS ADDED: 44, 45, 48, 50, 52, 83, 32 C12 NEW FLOOR FLANS ADDED: 20, 30, 47, 55-86, 91, 96, 101, 102, 142 C14 NEW FLOOR FLANS ADDED: 44, 45, 48, 50, 52, 83, 92, 100, 33 C14 NEW FLOOR FLANS ADDED: 20, 30, 47, 55-86, 91, 96, 111, 121, 134 C15 NEW FLOOR FLANS ADDED: 44, 62, 93 NEW FLOOR FLANS ADDED: 40, 62, 93 C16 NEW FLOOR FLANS ADDED: 20, 30, 47, 55-86, 91, 96, 111, 121, 134 C17 ADDED FRE LANE AND CALLOUT, UPDATED LEGEND EDITED: DECEMBER 6, 2018 PLOTTED: DECEMBER 6, 2018 P
C17 Sket of wy	LEGEND PROPERTY BOUNDARY		NORTH ARROW & SCALE	KEY MAP APPROVED	NORTH
OF 136	C17 STREET CENTERLINE SIDEWALK SIDEWALK CURB AND GUTTER 755 PROPOSED CONTOURS 750 EXISTING CONTOURS 750 EXISTING CONTOURS CURB AND GUTTER STREET CENTERLINE			CITY OF AUSTIN DEVELOPMENT SERVICES	SITE PLAN 4 OF 4
			HORIZONTAL SCALE: $1^{\circ} = 40^{\circ}$		OF 136