# 1949

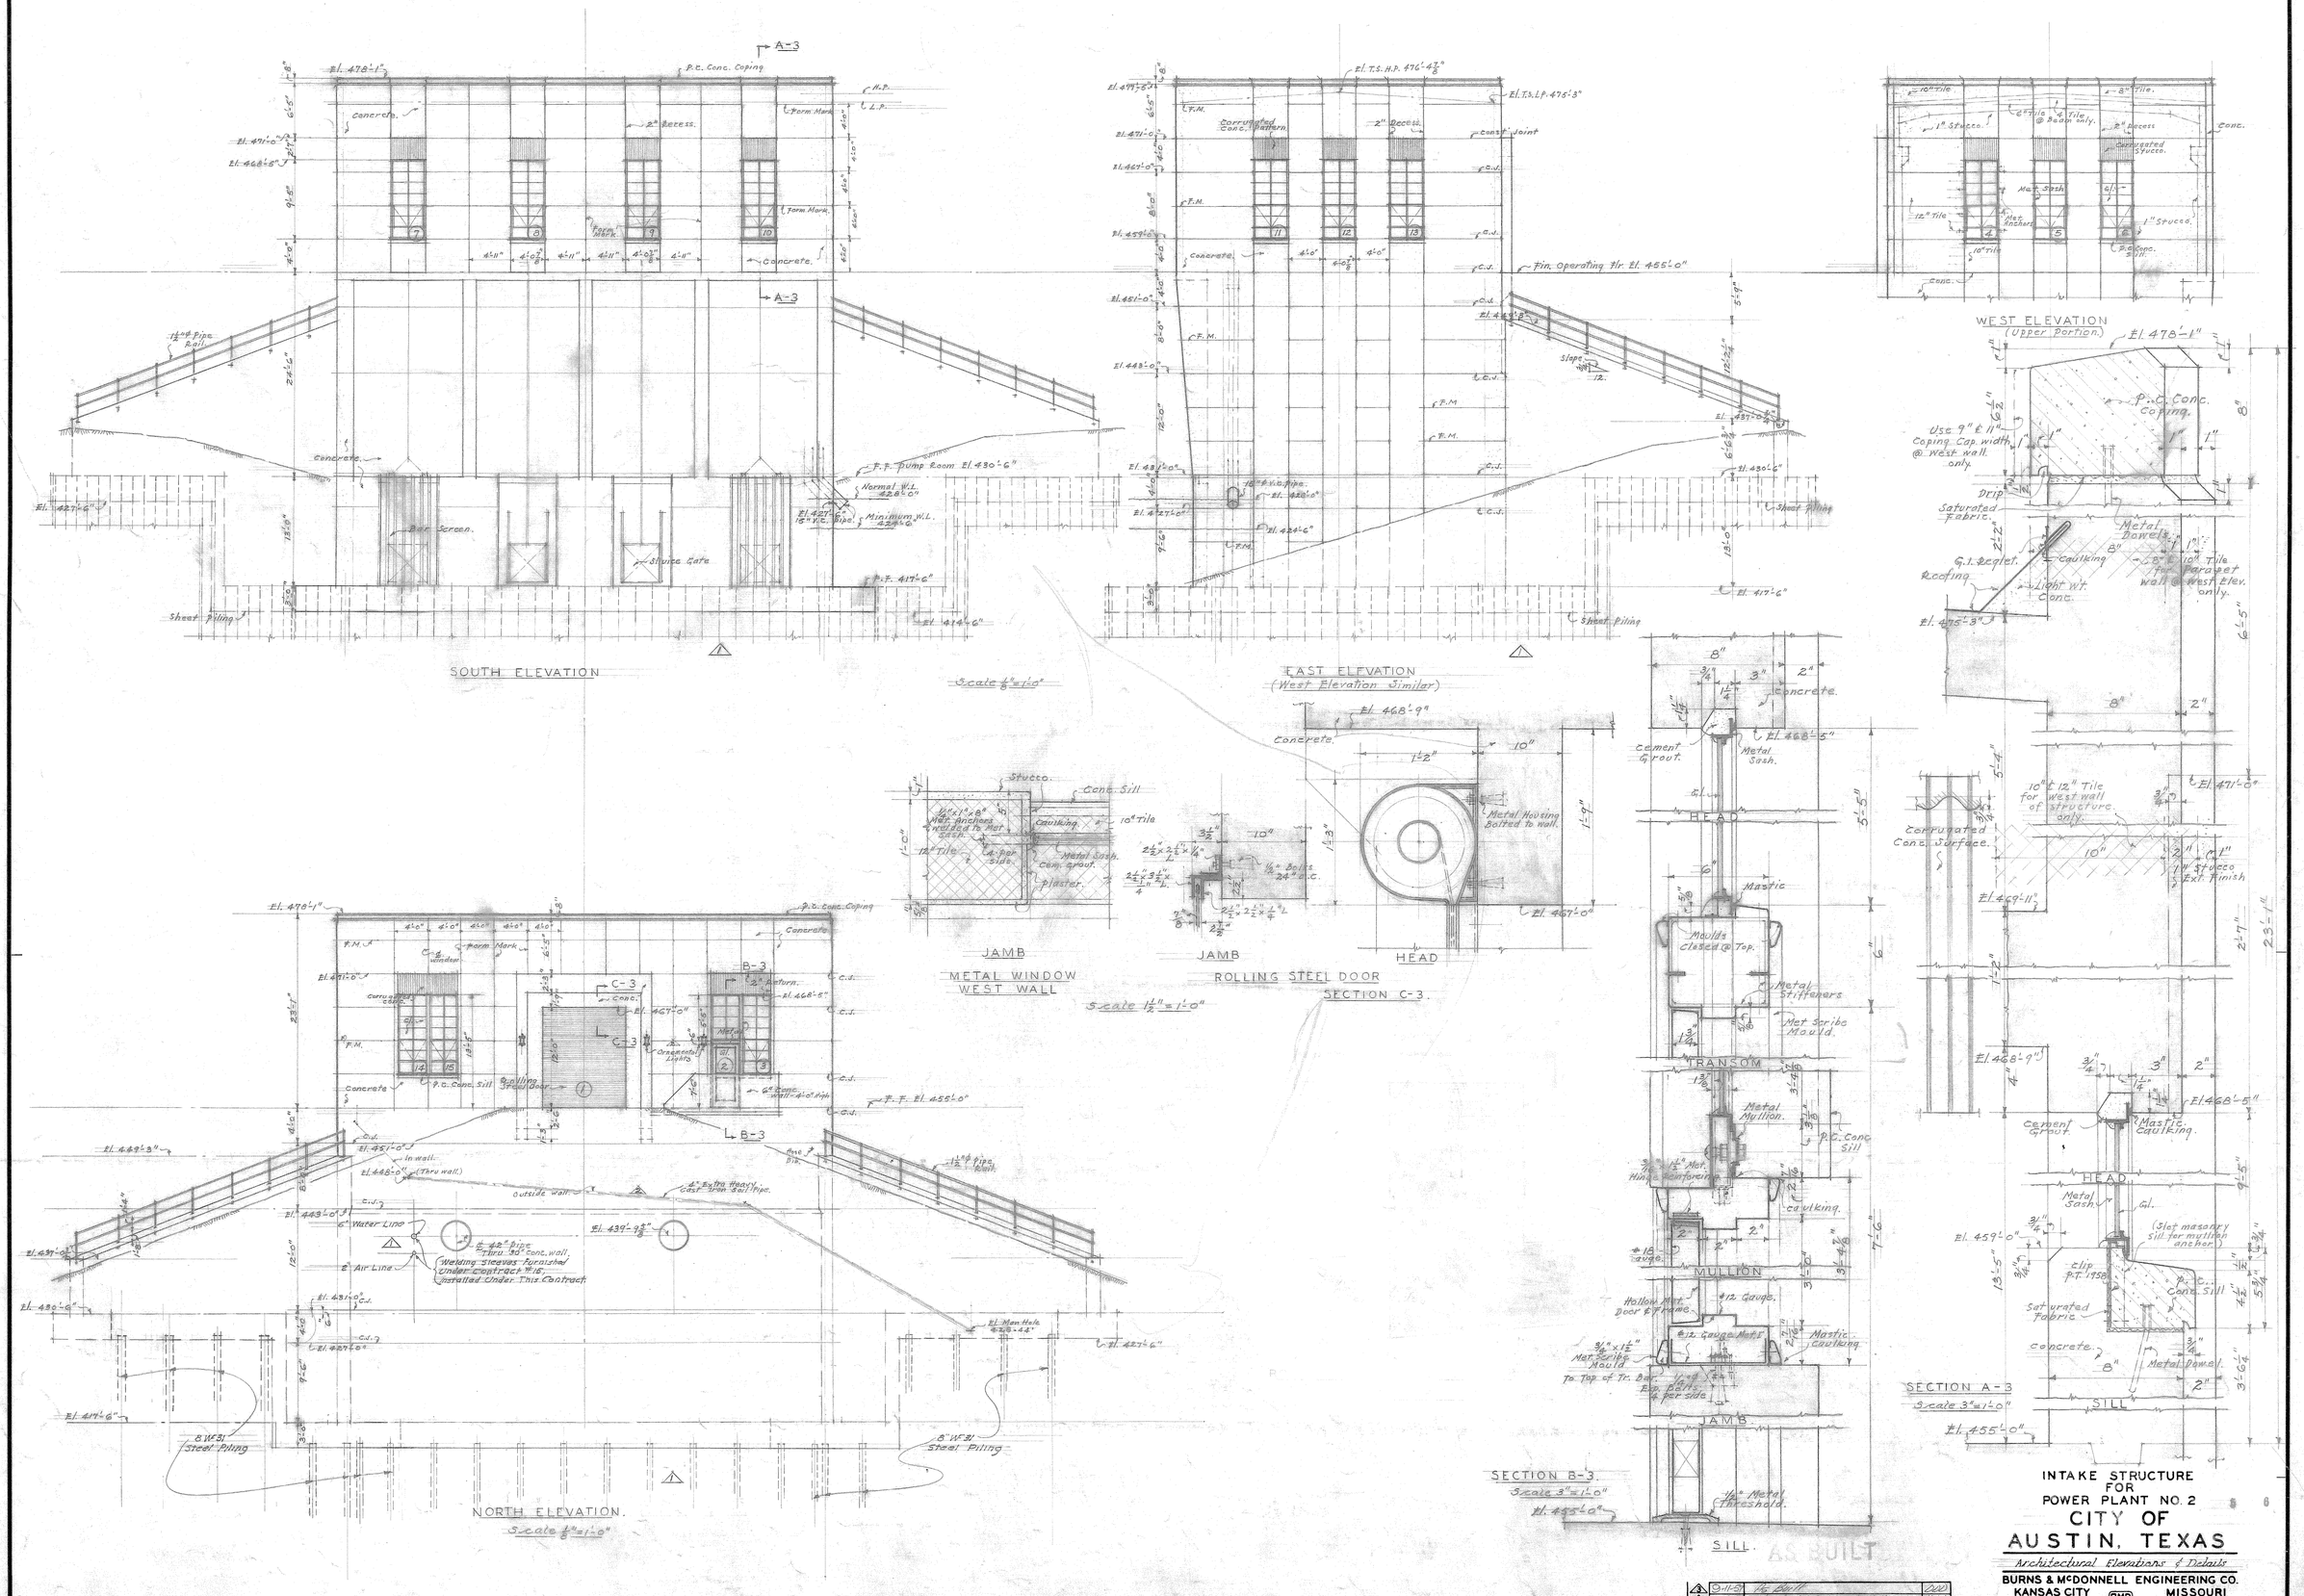


| NO. | DATE | REVISIONS | BY |
|---|---|---|---|
| 3 | 3-11-54 | As Built | DWD |
| 2 | 10-16-50 | Balance of Sheet & M.H. | HWD |
| 1 | 3/1/50 | Piling - Add Pump Sleeve | HLB |

| | | | |
|---|---|---|---|
| DESIGNED | R. M. M. | CHECKED | |
| DETAILED | H. A. L. | APPROVED | |

JOB NO. 48-32D

1950

SCALE : AS NOTED

SHEET -REV. 3-3

INTAKE STRUCTURE
FOR
POWER PLANT NO. 2
CITY OF
AUSTIN, TEXAS

Architectural Elevations & Details

BURNS & McDONNELL ENGINEERING CO.
KANSAS CITY MISSOURI

UNITS 5 & 6

Architectural Plans & Details

CHARLES BRUNING CO., INC.

1964